

Company	South Penn Natural Gas Co.		
Address	Parkersburg, W. Va.		
Farm	W.R. Shuman		
Tract	Acres	Lease No.	
	18 1/2	8470	
Well (Farm) No.	8	Serial No.	
Elevation (Spirit Level)	1508.78		
Quadrangle	Blacksville		
County	Monongalia	District	Clay
Engineer	E.C. Tabler		
Engineer's Registration No.			
File No.	Drawing No.		
Date	Oct. 14, 1940 Scale 1" = 400'		

STATE OF WEST VIRGINIA
 DEPARTMENT OF MINES
 OIL AND GAS DIVISION
 CHARLESTON
 NOW 061-1628

WELL LOCATION MAP
 FILE NO. **MON-247A**
 was 63A

+ Denotes location of well on United States Topographic Maps, scale 1: to 62,500, latitude and longitude lines being represented by border lines as shown.

- Denotes one inch spaces on border line of original tracing.

STATE OF WEST VIRGINIA
DEPARTMENT OF MINES
OIL AND GAS DIVISION

300

WELL RECORD

Ab
M7-A


Permit No. _____ Oil or Gas Well **OIL**
(KIND)

Company **South Penn Natural Gas Company**
Address **Union Trust Bldg. Parkersburg, W. Va.**
Farm **W. R. Shuman** Acres **181**
Location (waters) **---**
Well No. **8** Elev. **1508.78**
District **Clay** County **Monongalia**
The surface of tract is owned in fee by **H.A. & W.C. Darrach**
R.F.D. No. 2, Address **Fairview, W. Va.**
Mineral rights are owned by **W. Hunter Atha, et al.,**
s/o Atha Supply Co., Address **Zanesville, Ohio.**
Drilling commenced **July 6, 1905**
Drilling completed **Aug. 27, 1905**
Date shot **8-15-1905-16** Depth of shot **---**
Open Flow /10ths Water in **---** Inch
/10ths Merc. in **---** Inch
Volume **---** Cu. Ft.
Rock Pressure **---** lbs **---** hrs.
Oil **5** bbls., 1st 24 hrs.
Fresh water **---** feet **---** feet
Salt water **---** feet **---** feet

Casing and Tubing	Used in Drilling	Left in Well	Packers
Size			Kind of Packer
16			
13			
10	1140' (pulled)		Size of
8 1/4	1600' (Pulled)		
6 1/2	2350'		Depth set
5 3/16	2570'		
3			Perf. top
Cont.	16'		Perf. bottom
Liners Used			Perf. top
4 1/2	447'		Perf. bottom

CASING CEMENTED **---** SIZE **---** No. Ft. **---** Date **---**
COAL WAS ENCOUNTERED AT **990** FEET **60** INCHES
1092 FEET **84** INCHES **---** FEET **---** INCHES
--- FEET **---** INCHES **---** FEET **---** INCHES

Formation	Color	Hard or Soft	Top	Bottom	Oil, Gas or Water	Depth Found	Remarks
Mapletown Coal			990	995			
Pittsburgh Coal			1092	1099			
Big Dunkard Sand			1550	1622			
Gas Sand			1800	1920			
Salt Sand			1990	2120			
Big Lime			2310	2360			
Big Injun Sand			2360	2570			
Thirty Foot Sand			2870	2900			
Fifty Foot Sand			2962	3175			
Gordon Sand			3510	3325			
Fourth Sand			3555	3555			
Fifth Sand			3502	3512			
					Oil	3504	
Total Depth				3523			

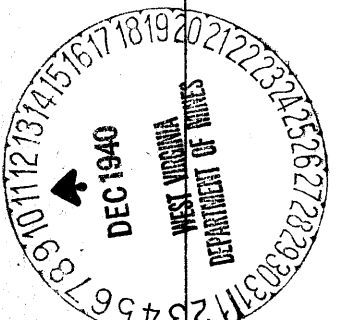

Clay District, Monongalia County, W. Va.

By South Penn Oil Co., P. O. Drawer 1255, Pittsburgh, Pa.

On 181 acres, surface owned by Howard and Guy Darrah, Route 2,
Fairview, W. Va., and mineral rights by W. Hunter Atha et al.,
Farmers & Merchants Bank, Fairview, W. Va.

Elevation, 1508.78' L.

16" conductor; 10" casing, 1140'; 8", 1600'; 6-5/8", 2350';
5-3/16", 2500'; 4 1/2" liner, 447'.

Coal was encountered at 990-995' and 1092-1100'.

4 1/2 x 4" liner, 447'.

Abandonment reported to Dept. of Mines May 5, 1933.

Oil well.

	Top.	Bottom.
Mapletown (Sewickley) Coal	990	
Pittsburgh Coal	1092	
Big Dunkard Sand	1550	- 1622
Gas Sand	1800	- 1920
Salt Sand	1990	- 2130
Big Lime	2310	- 2360
Big Injun Sand	2360	- 2570
30-Ft. ? Sand	2870	- 2900
50-Ft. ? Sand	2962	- 3175
Gordon Sand	3310	- 3325
4th Sand	3335	- 3355
5th Sand (oil, 3504')	3502	- 3513
Total depth		3523