


- WELL REFERENCE (API#, DISTANCE TO LATERAL)
- 061-01337 N 85°05'13" W 891'
 - 061-01347 N 38°02'30" W 1,311'
 - 061-00694 S 09°36'01" E 1,342'
 - 061-00816 N 15°05'24" E 1,527'
 - 061-00769
 - 061-00751
 - 061-00696

NOTE:
 NO WATER WELLS WERE FOUND WITHIN 250' OF THE CENTER OF WELL PAD.
 NO DWELLINGS WERE FOUND WITHIN 625' OF THE CENTER OF WELL PAD.

REFERENCE NOTES
 Boundaries as shown taken from deeds, tax maps and field locations. A full boundary survey is not expressed nor implied. All bearings are based on true north. Ownership taken from public records MONONGALIA County, West Virginia JULY 2017
 State Plane Coordinates & NAD 83 Lat/Long by differential submeter mapping grade GPS
 Drafted by: E.A.H.

FILE #: NNE15
 DRAWING #: 2817
 SCALE: PLAT: 1" = 1000'
 TICK: 1" = 2000'
 MINIMUM DEGREE OF ACCURACY: 1/200
 PROVEN SOURCE OF ELEVATION: SUBMETER MAPPING GRADE GPS

I, THE UNDERSIGNED, HEREBY CERTIFY THAT THIS PLAT IS CORRECT TO THE BEST OF MY KNOWLEDGE AND BELIEF AND SHOWS ALL THE INFORMATION REQUIRED BY LAW AND THE REGULATIONS ISSUED AND PRESCRIBED BY THE DEPARTMENT OF ENVIRONMENTAL PROTECTION.
 Signed: [Signature]
 L.L.S. #2124 : Ernest J. Benchek III

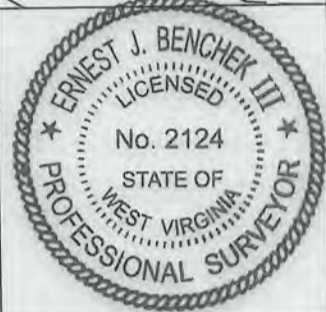


(+) DENOTES LOCATION OF WELL ON UNITED STATES TOPOGRAPHIC MAPS WYDEP
 OFFICE OF OIL & GAS
 601 5TH STREET
 CHARLESTON, WV 25304
 Well Type: Oil Waste Diposal Production Deep
 Gas Liquid Injection Storage Shallow
 WATERSHED: DUNKARD CREEK
 COUNTY/DISTRICT: MONONGALIA / CLAY
 SURFACE OWNER: PATTY A. KASSAY
 OIL & GAS ROYALTY OWNER: PATTY A. KASSAY
 LEASE NUMBERS: _____
 DRILL CONVERT DRILL DEEPER REDRILL FRACTURE OR STIMULATE
 PLUG OFF FORMATION PERFORATE NEW FORMATION PLUG & ABANDON
 CLEAN OUT & REPLUG OTHER CHANGE (SPECIFY): _____
 TARGET FORMATION: MARCELLUS
 WELL OPERATOR: NORTHEAST NATURAL ENERGY LLC
 ADDRESS: 707 VIRGINIA STREET EAST, SUITE 1200
 CITY: CHARLESTON STATE: WV ZIP CODE: 25301
 DATE: SEPTEMBER 24, 2018
 OPERATOR'S WELL #: KASSAY 2H
 API WELL #: 47 61 01794 P
 STATE COUNTY PERMIT
 AS-BUILT ELEVATION: 1,534'
 QUADRANGLE: BLACKSVILLE
 ACREAGE: 86.78 +/-
 ACREAGE: 86.78 +/-
 ESTIMATED DEPTH: TVD: 2,662.43' TMD: 2,668'
 DESIGNATED AGENT: JOHN ADAMS
 ADDRESS: 707 VIRGINIA STREET EAST, SUITE 1200
 CITY: CHARLESTON STATE: WV ZIP CODE: 25301

47-061-01794P

11/16/2018

Copyright © 2013 National Geographic Society, Inc.

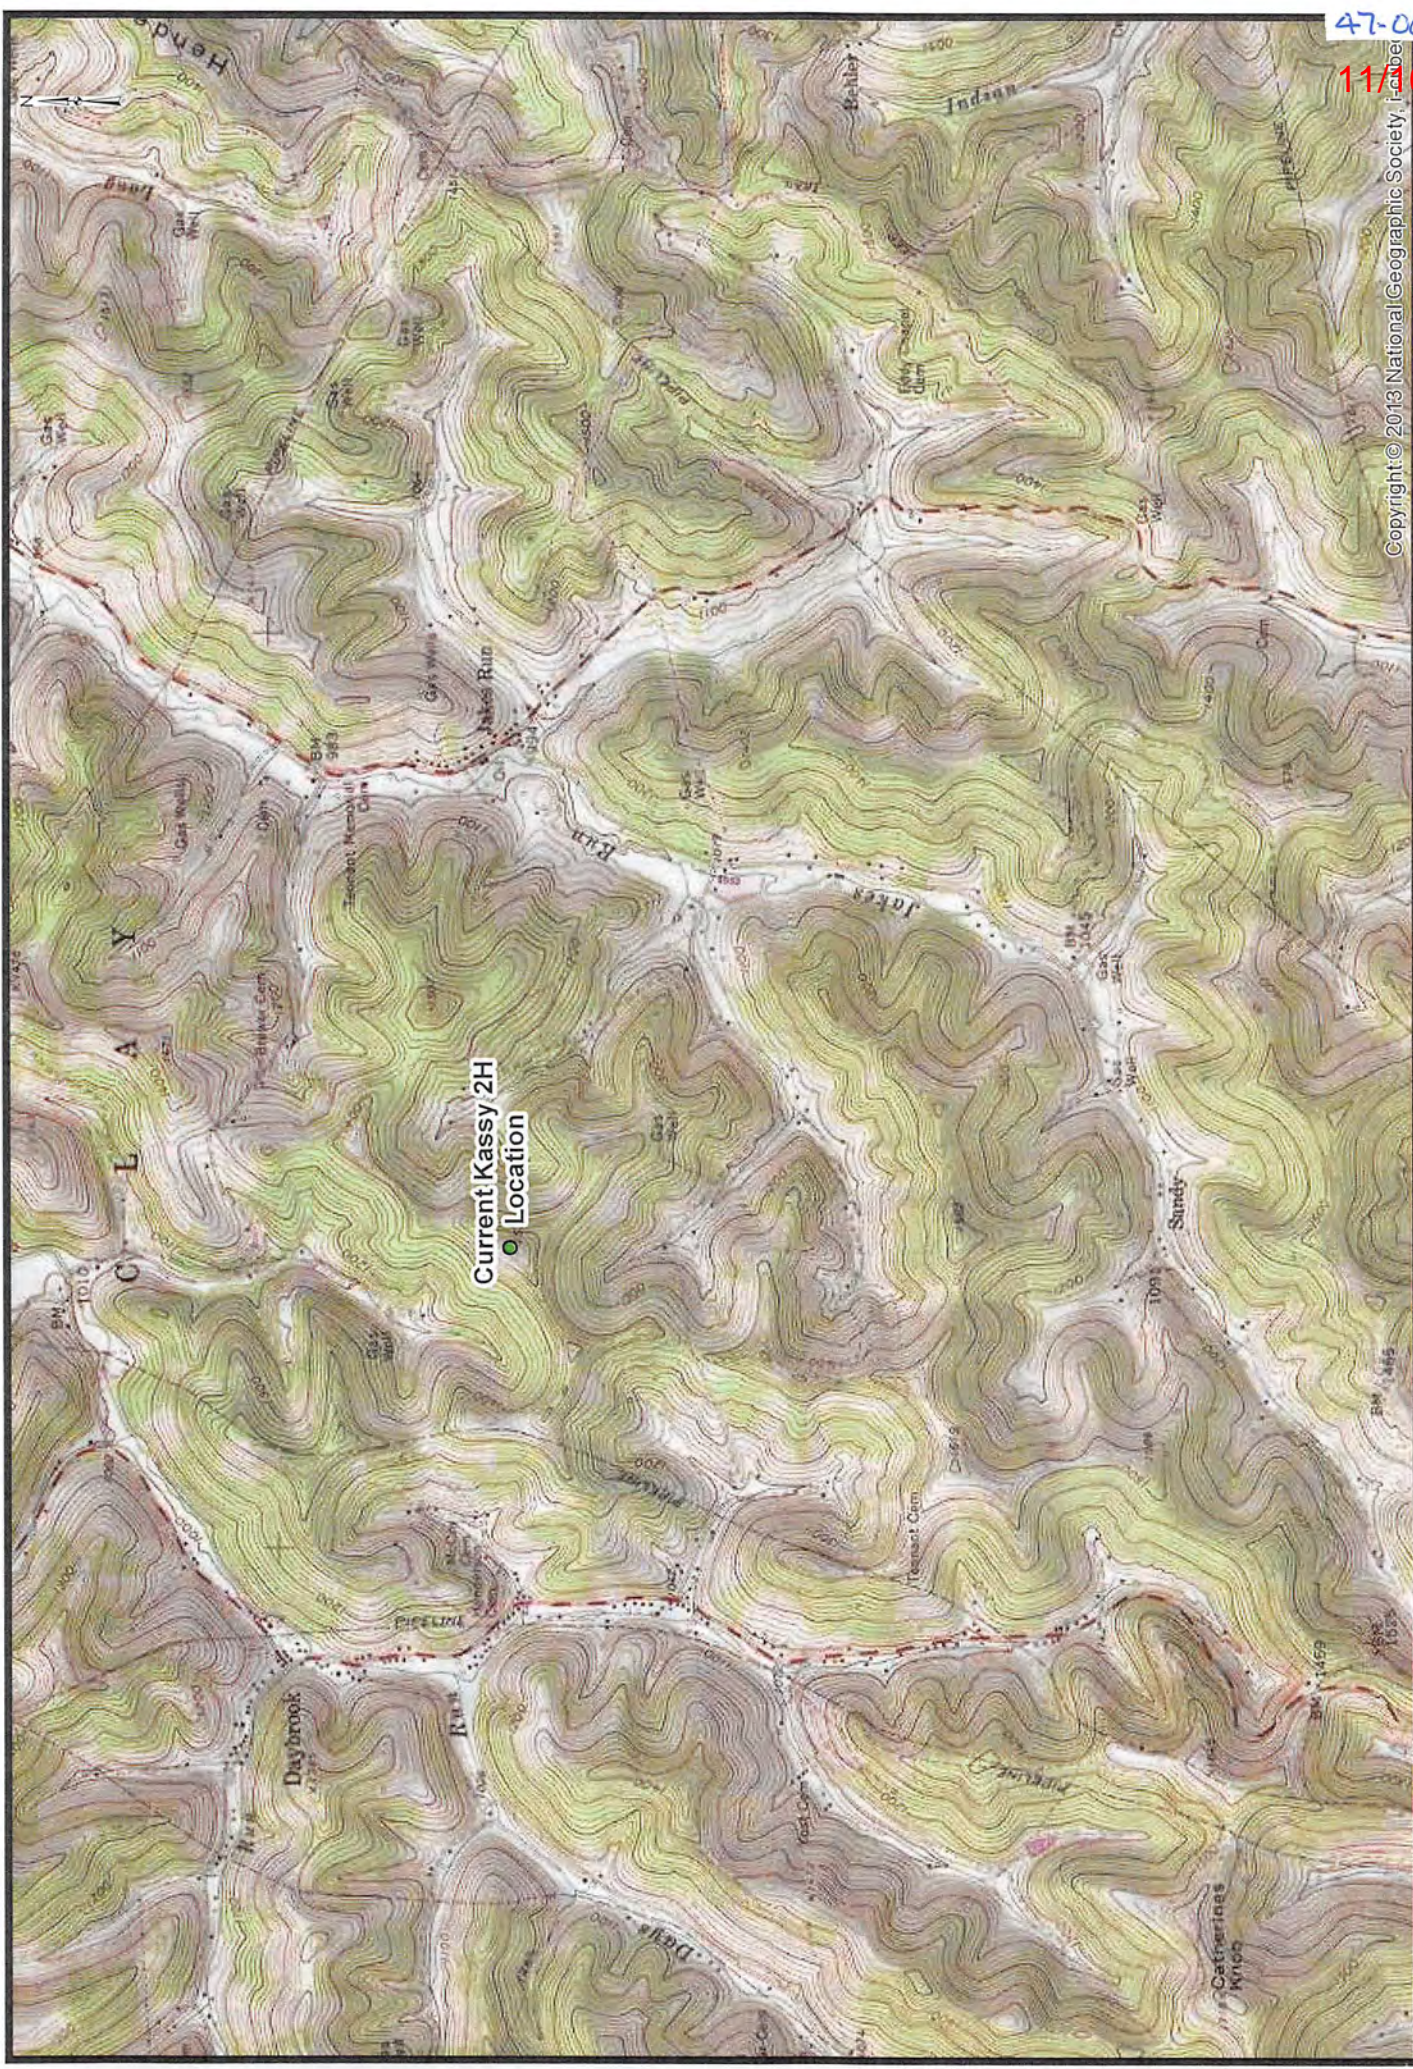

Current Kassy 2H Location

RECEIVED
Office of Oil and Gas

OCT 01 2018

WV Department of
Environmental Protection

Kassay 2H Current Location

Date: 9/21/2018

