

FILE #: NNE14
 DRAWING #: 2850
 SCALE: PLAT: 1" = 1600'
TICK: 1" = 2000'
 MINIMUM DEGREE OF ACCURACY: 1/200
 PROVEN SOURCE OF ELEVATION: SUBMETER MAPPING GRADE GPS

I, THE UNDERSIGNED, HEREBY CERTIFY THAT THIS PLAT IS CORRECT TO THE BEST OF MY KNOWLEDGE AND BELIEF AND SHOWS ALL THE INFORMATION REQUIRED BY LAW AND THE REGULATIONS ISSUED AND PRESCRIBED BY THE DEPARTMENT OF ENVIRONMENTAL PROTECTION.

Signed: [Signature]
 L.L.S. #2124 : Ernest J. Benchek III



(+) DENOTES LOCATION OF WELL ON UNITED STATES TOPOGRAPHIC MAPS WYDEP
 OFFICE OF OIL & GAS
 601 57TH STREET
 CHARLESTON, WV 25304

Well Type: Oil Waste Dposal Production Deep
 Gas Liquid Injection Storage Shallow

WATERSHED: UPPER MONONGAHELA
 COUNTY/DISTRICT: MONONGALIA / BATTELLE
 SURFACE OWNER: ALYCEMARIE MCCLELLAN & MICHELLE D. MOORE
 OIL & GAS ROYALTY OWNER: Barbara June Sutton, et al
 LEASE NUMBERS: _____

DATE: JULY 25, 2018
 OPERATOR'S WELL #: McCLELLAN NO. 14H
 API WELL #: 47 61 01817 H6A
 STATE COUNTY PERMIT

AS-BUILT ELEVATION: 1,411.7'
 QUADRANGLE: MANNINGTON
 ACREAGE: 883.579 +/-
 ACREAGE: 129.4 +/-


TARGET FORMATION: MARCELLUS
 WELL OPERATOR: NORTHEAST NATURAL ENERGY LLC
 ADDRESS: 707 VIRGINIA STREET EAST, SUITE 1200
 CITY: CHARLESTON STATE: WV ZIP CODE: 25301

DRILL CONVERT DRILL DEEPER REDRILL FRACTURE OR STIMULATE
 PLUG OFF FORMATION PERFORATE NEW FORMATION PLUG & ABANDON
 CLEAN OUT & REPLUG OTHER CHANGE (SPECIFY): _____

ESTIMATED DEPTH: TVD: 8,160' TMD: 19,619.91'
 DESIGNATED AGENT: JOHN ADAMS
 ADDRESS: 707 VIRGINIA STREET EAST, SUITE 1200
 CITY: CHARLESTON STATE: WV ZIP CODE: 25301

Let- 01817

01/18/2019

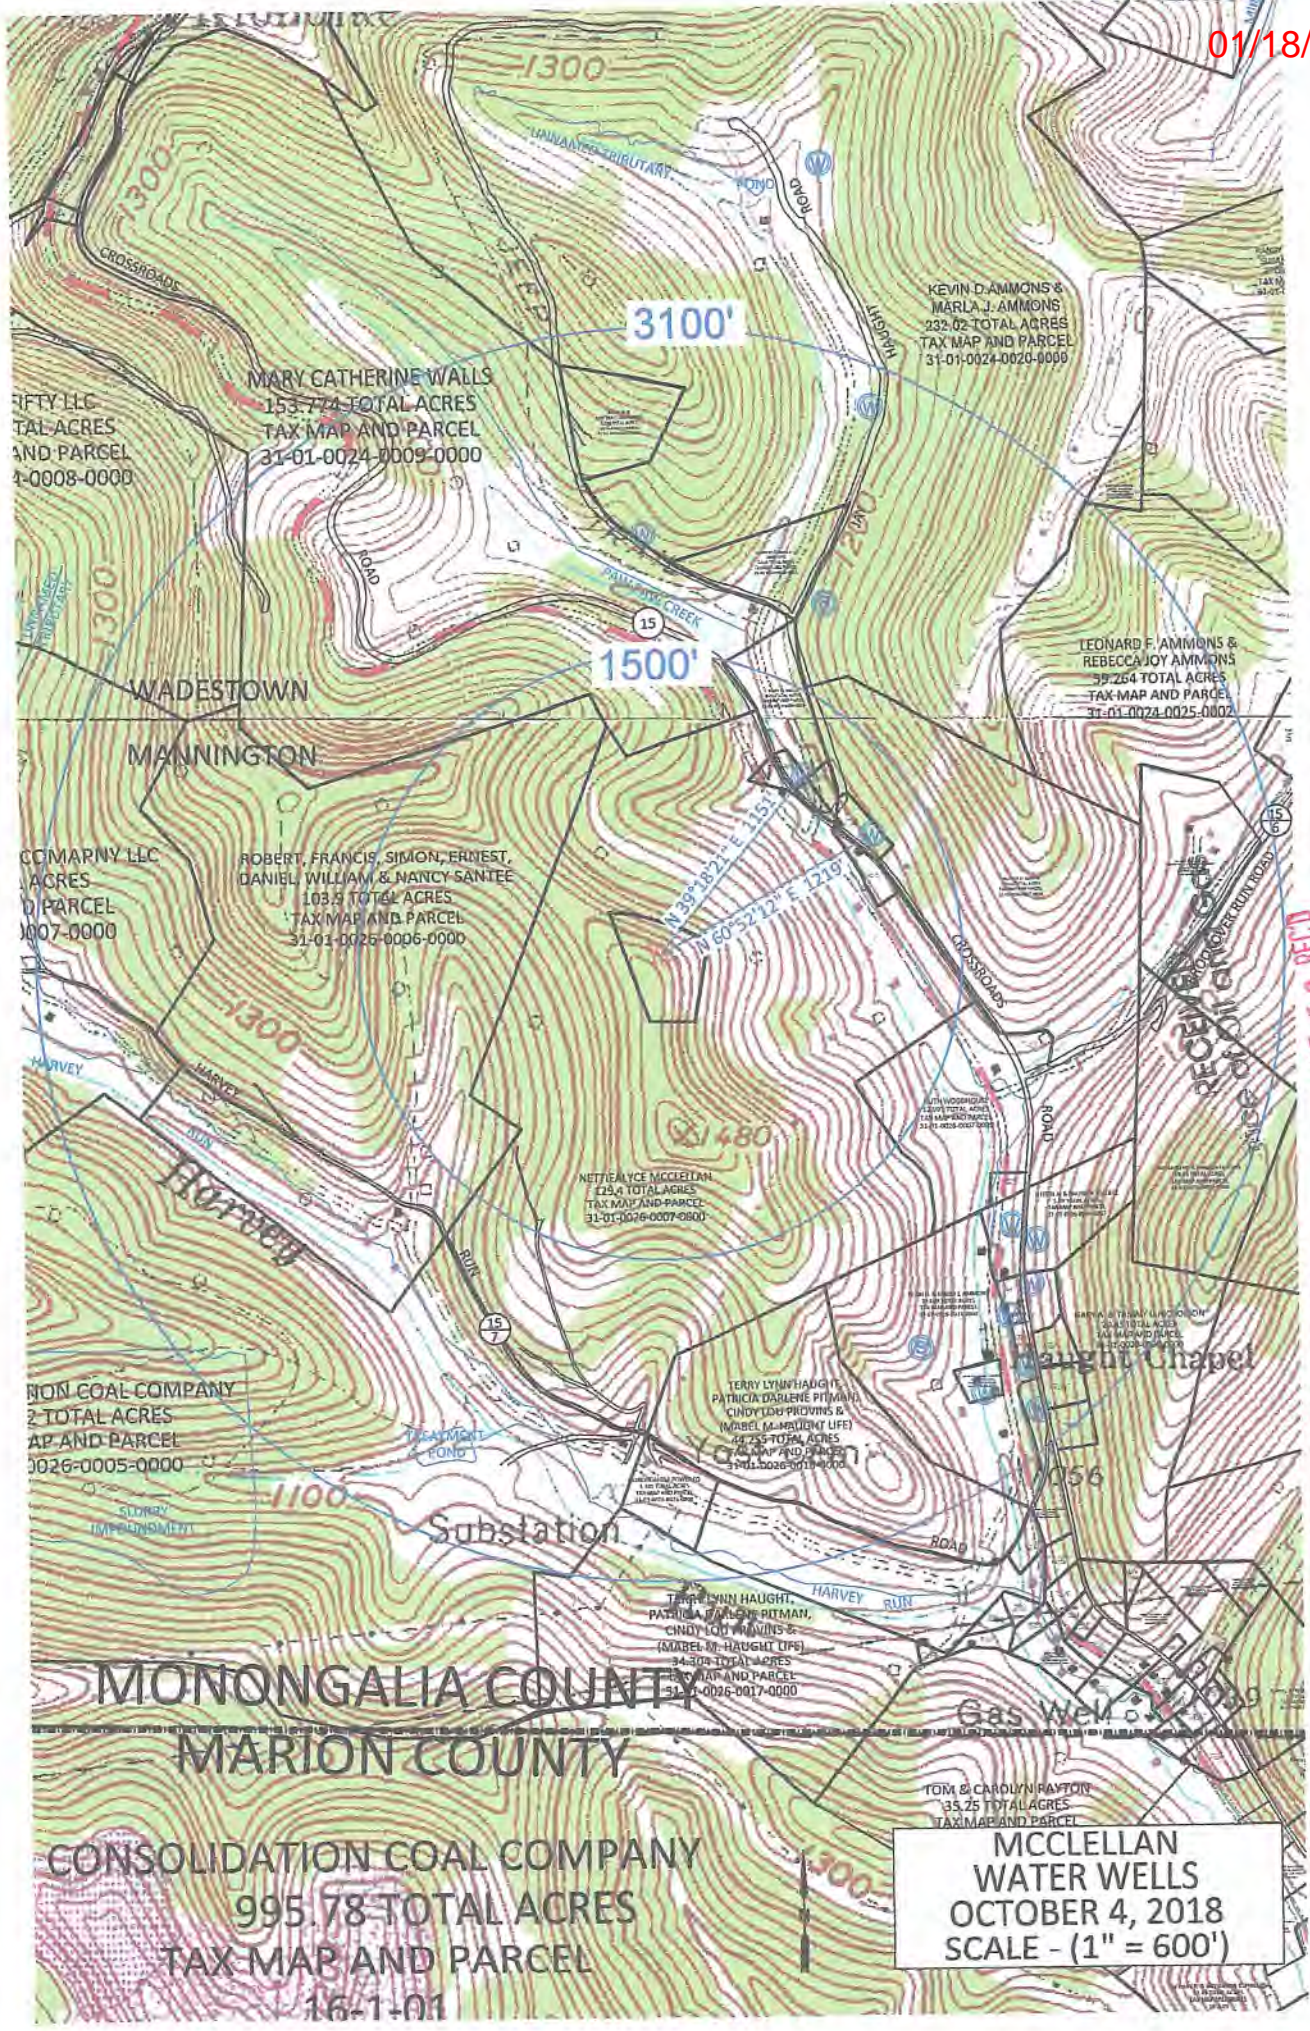

FIFTY LLC
 15.00 TOTAL ACRES
 TAX MAP AND PARCEL
 31-01-0008-0000

MARY CATHERINE WALLS
 153.774 TOTAL ACRES
 TAX MAP AND PARCEL
 31-01-0024-0009-0000

KEVIN D. AMMONS &
 MARLA J. AMMONS
 232.02 TOTAL ACRES
 TAX MAP AND PARCEL
 31-01-0024-0020-0000

LEONARD F. AMMONS &
 REBECCA JOY AMMONS
 39.264 TOTAL ACRES
 TAX MAP AND PARCEL
 31-01-0024-0025-0000

CCMARNY LLC
 10.00 ACRES
 TAX MAP AND PARCEL
 31-01-0007-0000

ROBERT, FRANCIS, SIMON, ERNEST,
 DANIEL, WILLIAM, & MARY Santee
 103.9 TOTAL ACRES
 TAX MAP AND PARCEL
 31-01-0026-0006-0000

NETTIE ALICE MCCLELLAN
 129.4 TOTAL ACRES
 TAX MAP AND PARCEL
 31-01-0026-0007-0000

MON COAL COMPANY
 12.00 TOTAL ACRES
 TAX MAP AND PARCEL
 31-01-0026-0005-0000

TERRY LYNN HAUGHT,
 PATRICIA DARLENE PITMAN,
 CINDY LDU PROVINS &
 MARIE M. HAUGHT LIFE
 47.25 TOTAL ACRES
 TAX MAP AND PARCEL
 31-01-0026-0018-0000

TERRY LYNN HAUGHT,
 PATRICIA DARLENE PITMAN,
 CINDY LDU PROVINS &
 MARIE M. HAUGHT LIFE
 47.25 TOTAL ACRES
 TAX MAP AND PARCEL
 31-01-0026-0017-0000

MONONGALIA COUNTY
 MARION COUNTY
 CONSOLIDATION COAL COMPANY
 995.78 TOTAL ACRES
 TAX MAP AND PARCEL
 16-1-01

TOM & CAROLYN FAITON
 35.25 TOTAL ACRES
 TAX MAP AND PARCEL

MCCLELLAN
 WATER WELLS
 OCTOBER 4, 2018
 SCALE - (1" = 600')

OCT 16 2018

WV Department of
 Environmental Protection