


FILE #: NNE20
DRAWING #: 2987
SCALE: PLAT: 1" = 2000'
TICK: 1" = 2000'
MINIMUM DEGREE OF ACCURACY: 1/200
PROVEN SOURCE OF ELEVATION: SUBMETER MAPPING GRADE GPS

I, THE UNDERSIGNED, HEREBY CERTIFY THAT THIS PLAT IS CORRECT TO THE BEST OF MY KNOWLEDGE AND BELIEF AND SHOWS ALL THE INFORMATION REQUIRED BY LAW AND THE REGULATIONS ISSUED AND PRESCRIBED BY THE DEPARTMENT OF ENVIRONMENTAL PROTECTION.

Signed:

L.L.S. #2124 : Ernest J. Benchek III

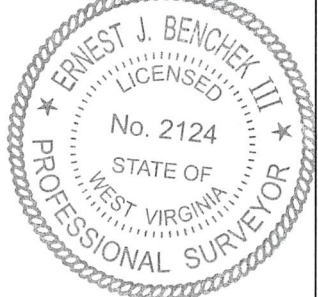

(+) DENOTES LOCATION OF WELL ON UNITED STATES TOPOGRAPHIC MAPS WVDEP

OFFICE OF OIL & GAS
601 57TH STREET
CHARLESTON, WV 25304

Well Type: Oil Waste Diposal Production Deep Gas Liquid Injection Storage Shallow

WATERSHED: DUNKARD CREEK
COUNTY/DISTRICT: MONONGALIA / BATTELLE
SURFACE OWNER: Phoenix Energy Resources, LLC
OIL & GAS ROYALTY OWNER: Phoenix Energy Resources, LLC, et al.
LEASE NUMBERS:

DATE: NOVEMBER 18, 2021
OPERATOR'S WELL #: ERP 2H (AS-DRILLED)
API WELL #: 47 61 01877
STATE COUNTY PERMIT

AS-BUILT ELEVATION: 1,338.60'
QUADRANGLE: WADESTOWN
ACREAGE: 1510.488 +/-
ACREAGE: 728.163 +/-

DRILL CONVERT DRILL DEEPER REDRILL FRACTURE OR STIMULATE
PLUG OFF FORMATION PERFORATE NEW FORMATION PLUG & ABANDON
CLEAN OUT & REPLUG OTHER CHANGE (SPECIFY):

TARGET FORMATION: MARCELLUS
DRILLED DEPTH: TVD: 8,071' TMD: 21,018'
WELL OPERATOR: NORTHEAST NATURAL ENERGY LLC
DESIGNATED AGENT: JOHN ADAMS
ADDRESS: 707 VIRGINIA STREET EAST, SUITE 1200
ADDRESS: 707 VIRGINIA STREET EAST, SUITE 1200
CITY: CHARLESTON STATE: WV ZIP CODE: 25301
CITY: CHARLESTON STATE: WV ZIP CODE: 25301

PROPERTY OWNER INDEX	
1-17-14	PHOENIX ENERGY RESOURCES, LLC
1-14-10.1	MARK A. & DEBRA C. WILLIAMS
1-14-10.2	DAVID W. & CHERYL A. WILLIAMS
1-14-19.1	PHOENIX ENERGY RESOURCES, LLC
1-17-16	PHOENIX ENERGY RESOURCES, LLC
1-17-13	PHOENIX ENERGY RESOURCES, LLC
4-19-1	SCOTTIE GLEN TRUST & KATHLEEN WILSON
1-14-18.1	NORMA WILLIAMS

LEASE INDEX			
A	WV-061-005667-001	I	WV-061-004351-005
B	WV-061-005667-001	J	WV-061-004514-001
C	WV-061-005697-001	K	WV-061-003767-004
D	WV-061-005697-002	L	WV-061-004376-001
E	WV-061-005329-015	M	WV-061-005168-004
F	WV-061-005754-001	N	WV-061-003767-004
G	WV-061-005754-001	O	WV-061-005607-001
H	WV-061-005168-004		

07/26/2024

FILE #: NEE20

DRAWING #: 2987

SCALE: N/A

DATE: NOVEMBER 18, 2021

OPERATOR'S WELL #: ERP 2H

API WELL #: 47 61 01877
STATE COUNTY PERMIT