

FILE #: NNE14


DRAWING #: 2995

SCALE: 1" = 2000'
TICK: 1" = 2000'


MINIMUM DEGREE OF ACCURACY: 1/200

PROVEN SOURCE OF ELEVATION: SUBMETER MAPPING GRADE GPS

I, THE UNDERSIGNED, HEREBY CERTIFY THAT THIS PLAT IS CORRECT TO THE BEST OF MY KNOWLEDGE AND BELIEF AND SHOWS ALL THE INFORMATION REQUIRED BY LAW AND THE REGULATIONS ISSUED AND PRESCRIBED BY THE DEPARTMENT OF ENVIRONMENTAL PROTECTION.

Signed: 

L.L.S. #2124 : Ernest J. Benchek III

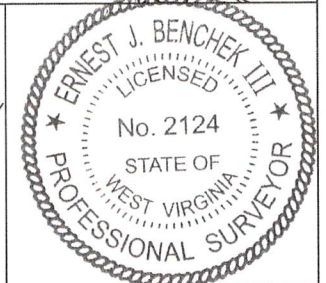

(+) DENOTES LOCATION OF WELL ON UNITED STATES TOPOGRAPHIC MAPS

WVDEP
OFFICE OF OIL & GAS
601 57TH STREET
CHARLESTON, WV 25304

DATE: AUGUST 26, 2022

OPERATOR'S WELL #: McCLELLAN 1H SIDE TRACK

Well Type: Oil Waste Diposal Production Deep
 Gas Liquid Injection Storage Shallow

API WELL #: 47 61 01882
STATE COUNTY PERMIT

WATERSHED: UPPER MONONGAHELA AS-BUILT ELEVATION: 1,411.7'

COUNTY/DISTRICT: MONONGALIA / BATTELLE QUADRANGLE: MANNINGTON

SURFACE OWNER: KLONDIKE REAL ESTATE PARTNERSHIP ACREAGE: 1,143.1 +/-

OIL & GAS ROYALTY OWNER: Barbara June Sutton, et al ACREAGE: 129.4 +/-

LEASE NUMBERS: _____

DRILL CONVERT DRILL DEEPER REDRILL FRACTURE OR STIMULATE
PLUG OFF FORMATION PERFORATE NEW FORMATION PLUG & ABANDON
CLEAN OUT & REPLUG OTHER CHANGE (SPECIFY): _____

TARGET FORMATION: MARCELLUS ESTIMATED DEPTH: SIDE TRACK TVD: 8,056' TMD: 24,172'

WELL OPERATOR: NORTHEAST NATURAL ENERGY LLC DESIGNATED AGENT: JOHN ADAMS

ADDRESS: 707 VIRGINIA STREET EAST, SUITE 1200 ADDRESS: 707 VIRGINIA STREET EAST, SUITE 1200

CITY: CHARLESTON STATE: WV ZIP CODE: 25301 CITY: CHARLESTON STATE: WV ZIP CODE: 25301

09/09/2022

PROPERTY OWNER INDEX	
1-26-7	KLONDIKE REAL ESTATE PARTNERSHIP
1-26-6	ROBERT G SANTEE ESTATE
1-24-7	CNX LAND LLC
1-24-8	NIFTY-FIFTY LLC
1-24-6	ALLEGHENY FORESTLANDS LLC
1-24-5	FRANCIS G SWISHER & THERESA TUTTLE
1-24-4	FRANCIS G SWISHER & THERESA TUTTLE
1-24-1	NELSON DALE & CHERYL LISBETH GALLAGHER
1-24-9.1	MARY C WALLS
1-18-43	BETTY J MARTINO
1-18-17	ERP FEDERAL MINING COMPLEX LLC

LEASE INDEX			
A	WV-061-004172-011	G	WV-061-004860-020
B	WV-061-004173-066	H	WV-061-004227-002
C	WV-061-004002-005	I	WV-061-700075-001
D	WV-061-004287-038	J	WV-061-005769-001
E	WV-061-005933-001	K	WV-061-003729-001
F	WV-061-004332-001	L	WV-061-003767-004

09/09/2022

FILE #: NEE14

DATE: AUGUST 26, 2022

DRAWING #: 2995

OPERATOR'S WELL #: McCLELLAN 1H SIDE TRACK

SCALE: N/A

API WELL #: 47 61 01882
STATE COUNTY PERMIT