


FILE #: _____
 DRAWING #: 2959
 SCALE: PLAT: 1" = 2400'
 TICK: 1" = 2000'
 MINIMUM DEGREE OF ACCURACY: 1/200
 PROVEN SOURCE OF ELEVATION: SUBMETER MAPPING GRADE GPS

PLAT IS CORRECT TO THE BEST OF MY KNOWLEDGE AND BELIEF AND SHOWS ALL THE INFORMATION REQUIRED BY LAW AND THE REGULATIONS ISSUED AND PRESCRIBED BY THE DEPARTMENT OF ENVIRONMENTAL PROTECTION.
 Signed: *[Signature]*
 L.L.S. #2124 : Ernest J. Benchek III

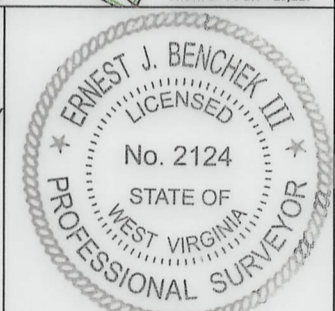

(+) DENOTES LOCATION OF WELL ON UNITED STATES TOPOGRAPHIC MAPS
 WYDEP
 OFFICE OF OIL & GAS
 601 57TH STREET
 CHARLESTON, WV 25304

Well Type: Oil Waste Diposal Production Deep
 Gas Liquid Injection Storage Shallow

WATERSHED: DUNKARD CREEK
 COUNTY/DISTRICT: MONONGALIA / BATTLETT
 SURFACE OWNER: CHARLES WENDELL MOORE & FRANK M. CHISLER
 OIL & GAS ROYALTY OWNER: Pat L. Park, et al
 LEASE NUMBERS: SEE PAGE 2

DATE: MAY 30, 2023
 OPERATOR'S WELL #: PHOENIX 6H AS-DRILLED
 API WELL #: 47 61 01890
 STATE COUNTY PERMIT
 AS-BUILT ELEVATION: 1,503.5'
 QUADRANGLE: WADESTOWN
 ACREAGE: 466.30 +/-
 ACREAGE: 1679.553 +/-

DRILL CONVERT DRILL DEEPER REDRILL FRACTURE OR STIMULATE
 PLUG OFF FORMATION PERFORATE NEW FORMATION PLUG & ABANDON
 CLEAN OUT & REPLUG OTHER CHANGE (SPECIFY): _____

TARGET FORMATION: MARCELLUS
 DRILLED DEPTH: TVD: 7,957' TMD: 29,087'
 WELL OPERATOR: NORTHEAST NATURAL ENERGY LLC
 DESIGNATED AGENT: JOHN ADAMS
 ADDRESS: 707 VIRGINIA STREET EAST, SUITE 1200
 ADDRESS: 707 VIRGINIA STREET EAST, SUITE 1200
 CITY: CHARLESTON STATE: WV ZIP CODE: 25301
 CITY: CHARLESTON STATE: WV ZIP CODE: 25301

PROPERTY OWNER INDEX	
1-17-14.1	FRANK M. CHISLER
4-24-17	DAVID A POLING
1-24-18	JOHN RAYMOND & JENNIFER L. HORNSBY MYERS
4-19-12	EDITH L DARRAH
4-19-14	PENNY S QUICKLE
4-19-18	CAROLYN S PAYTON
4-26-11	CAROLYN S PAYTON
4-19-15	TIMOTHY ALAN DARRAH
4-19-13	DOUGLAS L & DEBRA DARRAH
4-19-17	LEWIS M MAXWELL II & SHERRY E MAXWELL
4-19-19	LYDELL T & CONNIE S OWENS
4-19-18.1	LYDELL T & CONNIE S OWENS
4-26-10	BILLY C & BETTY A HAUGHT
4-26-10.3	WILLIAM R & KATHY L ICE
1-24-19.1	CHARLES WENDEL MOORE
4-26-9	GARY A & TAMMY L NICHOLSON
16-2-15	BILLY C & BETTY A HAUGHT
16-2-39.2	ROBERT E & LUELLA R CONAWAY
16-2-41	ROBERT E & LUELLA R CONAWAY
16-2-42	ROBERTA K ACUFF
16-2-38	ROBERT E & LUELLA R CONAWAY
16-2-41.1	HAROLD R BELL
4-26-41	THOMAS ALLEN KEANE JR & JUDITH LOUISE KEANE
16-9-1	THOMAS ALLEN KEANE JR & JUDITH LOUISE KEANE
16-9-1.2	FRANK J & HELEN R SCRITCHFIELD
16-9-42	JAMES P & URSULA A MCDONALD
16-9-41.1	JAMES R MOORE
16-9-41.2	JEFFREY J & SANDRA J MOORE
16-9-41	JEFFREY J & SANDRA J MOORE
16-9-41.3	ROYAL E & ELIZABETH J MOORE
16-9-40	JOHN & SANDRA J MOORE
16-9-40.1	ROYAL E & ELIZABETH J MOORE

LEASE INDEX			
A	WV-061-004079-001		
B	WV-061-004079-001	M	WV-061-004956-011; WV-061-005626-002
C	WV-061-003767-004		
D	WV-061-004463-001	N	WV-061-004956-011
E	WV-061-004076-010	O	WV-061-004846-030
F	WV-061-005687-001	P	WV-061-005699-002
G	WV-061-005687-001	Q	WV-061-000146-001-LOI
H	WV-061-001730-004	R	WV-061-000146-001-LOI
I	WV-061-001941-031	S	WV-061-000146-001-LOI
J	WV-061-005588-001	T	WV-061-000146-001-LOI
K	WV-061-000146-001-LOI	U	WV-061-000146-001-LOI
L	WV-061-001422-002	V	WV-061-000146-001-LOI
		W	WV-061-000146-001-LOI

RECEIVED
Office of Oil and Gas

JAN 16 2024

WV Department of
Environmental Protection
02/23/2024

FILE #: NEE14

DRAWING #: 2959

SCALE: N/A

DATE: MAY 30, 2023

OPERATOR'S WELL #: PHOENIX 6H AS-DRILLED

API WELL #: 47 61 01890
STATE COUNTY PERMIT