


FILE #: NEE14
 DRAWING #: 3038
 SCALE: PLAT: 1" = 1800'
TICK MARK: 1" = 2000'
 MINIMUM DEGREE OF ACCURACY: 1/200
 PROVEN SOURCE OF ELEVATION: SUBMETER MAPPING GRADE GPS

I, THE UNDERSIGNED, HEREBY CERTIFY THAT THIS PLAT IS CORRECT TO THE BEST OF MY KNOWLEDGE AND BELIEF AND SHOWS ALL THE INFORMATION REQUIRED BY LAW AND THE REGULATIONS ISSUED AND PRESCRIBED BY THE DEPARTMENT OF ENVIRONMENTAL PROTECTION.
 Signed: [Signature]
 L.L.S. #2124, Ernest J. Benchek III

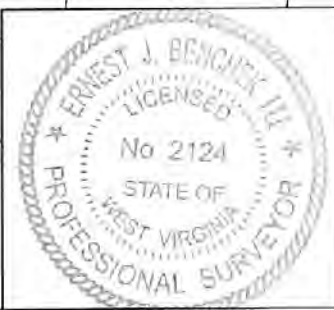

(+) DENOTES LOCATION OF WELL ON UNITED STATES TOPOGRAPHIC MAPS WYDEP
 OFFICE OF OIL & GAS
 601 57TH STREET
 CHARLESTON, WV 25304

Well Type: Oil Waste Diposal Production Deep
 Gas Liquid Injection Storage Shallow

WATERSHED: DUNKARD CREEK
 COUNTY/DISTRICT: MONONGALIA / CLAY
 SURFACE OWNER: YOST HERITAGE INC
 OIL & GAS ROYALTY OWNER: _____
 LEASE NUMBERS: _____

DATE: FEBRUARY 24, 2022
 OPERATOR'S WELL #: YOST 10H
 API WELL #: 47 61 01895 - M OD
 STATE COUNTY PERMIT

AS-BUILT ELEVATION: 1,494.93'
 QUADRANGLE: BLACKSVILLE, WV
 ACREAGE: 93.08 +/- 03/18/2022
 ACREAGE: 799.420 +/-

DRILL CONVERT DRILL DEEPER REDRILL FRACTURE OR STIMULATE
 PLUG OFF FORMATION PERFORATE NEW FORMATION PLUG & ABANDON
 CLEAN OUT & REPLUG OTHER CHANGE (SPECIFY): _____

TARGET FORMATION: MARCELLUS ESTIMATED DEPTH: TVD: 8,280' TMD: 20,352'
 WELL OPERATOR: NORTHEAST NATURAL ENERGY LLC DESIGNATED AGENT: JOHN ADAMS
 ADDRESS: 707 VIRGINIA STREET EAST, SUITE 1200 ADDRESS: 707 VIRGINIA STREET EAST, SUITE 1200
 CITY: CHARLESTON STATE: WV ZIP CODE: 25301 CITY: CHARLESTON STATE: WV ZIP CODE: 25301

PROPERTY OWNER INDEX	
4-19-43.1	YOST HERITAGE INC
4-19-44.1	YOST HERITAGE INC
4-19-44	LOIS JEAN MCCOY, SANDY L MOORE ET AL
4-19-43.4	YOST HERITAGE INC
4-19-43.3	DONALD LEE & ROGER KIETH WILLIAMS ET AL
4-20-26	RANDY D & VICKY S AMMONS (LIFE DELBERT E & LOLA HARTLEY)
4-20-35	DAVID R SAXON
4-20-47	DARRELL E EDDY
4-25-7	EVA V, ROGER A & RONALD T TULANOWSKI II
4-25-10	KITTY S & CRYSTAL L HAYES
4-20-38	PATRICIA DIANE FOLEY
4-25-12	KITTY S HAYES
4-20-28	BRANDEN L NUTTER
4-20-27	BRUCE ARNETT
4-20-42	THOMAS R & NORA M MCCOY
4-20-47.3	NINA FRANCES DEAN EDDY
4-25-12.1	AARON & DEBBIE CLEVINGER
4-25-14.1	AARON & DEBBIE CLEVINGER
4-25-14.2	AARON & DEBBIE CLEVINGER

LEASE INDEX			
A	WV-061-001043-002	J	WV-061-000173-065
B	WV-061-001043-002	K	WV-061-000173-065
C	WV-061-001043-002	L	WV-061-002303-006
D	WV-061-003452-000	M	WV-061-005854-001
E	WV-061-000821-000	N	WV-061-005854-001
F	WV-061-003452-000	O	WV-061-005853-001
G	WV-061-003451-001	P	WV-061-005853-001
H	WV-061-003862-004	Q	WV-061-005853-001
I	WV-061-005686-001	R	WV-061-005853-001
		S	WV-061-005851-001

03/18/2022

FILE #: NEE14

DRAWING #: 2979

SCALE: N/A

DATE: FEBRUARY 24, 2022

OPERATOR'S WELL #: YOST 10H

API WELL #: 47 61 01895 - MOD
STATE COUNTY PERMIT