

WW-7
8-30-06



West Virginia Department of Environmental Protection
Office of Oil and Gas

WELL LOCATION FORM: GPS

API: 47-061-70452 WELL NO.: 8240

FARM NAME: B.F. LIMING

RESPONSIBLE PARTY NAME: WEST VIRGINIA LAND RESOURCES INC.

COUNTY: MONONGALIA DISTRICT: BATTELLE

QUADRANGLE: HUNDRED W.VA, PA

SURFACE OWNER: KYLIE D. BARNHART

ROYALTY OWNER: _____

UTM GPS NORTHING: 4,390,035 m (1381')

UTM GPS EASTING: 551,534 m GPS ELEVATION: 421 m

The Responsible Party named above has chosen to submit GPS coordinates in lieu of preparing a new well location plat for a plugging permit or assigned API number on the above well. The Office of Oil and Gas will not accept GPS coordinates that do not meet the following requirements:

- 1. Datum: NAD 1983, Zone: 17 North, Coordinate Units: meters, Altitude: height above mean sea level (MSL) – meters.
- 2. Accuracy to Datum – 3.05 meters
- 3. Data Collection Method:
Survey grade GPS ____ : Post Processed Differential ____

Real-Time Differential ____

Mapping Grade GPS : Post Processed Differential

Real-Time Differential ____

- 4. Letter size copy of the topography map showing the well location.

I the undersigned, hereby certify this data is correct to the best of my knowledge and belief and shows all the information required by law and the regulations issued and prescribed by the Office of Oil and Gas.

B.F. Liming
Signature

Professional Surveyor
Title

OCTOBER 29, 2021
Date

RECEIVED
Office of Oil and Gas
DEC 14 2021
WV Department of
Environmental Protection

Well# 8240

HUNDRED WV, PA 7.5' Quad

Scale: 1" = 500'

Dawson Cem

Limming Ridge

Ch

Well# 8240


1300

1400


1400

RECEIVED
Office of Oil and Gas
DEC 14 2021
WV Department of
Environmental Protection

12/24/2021

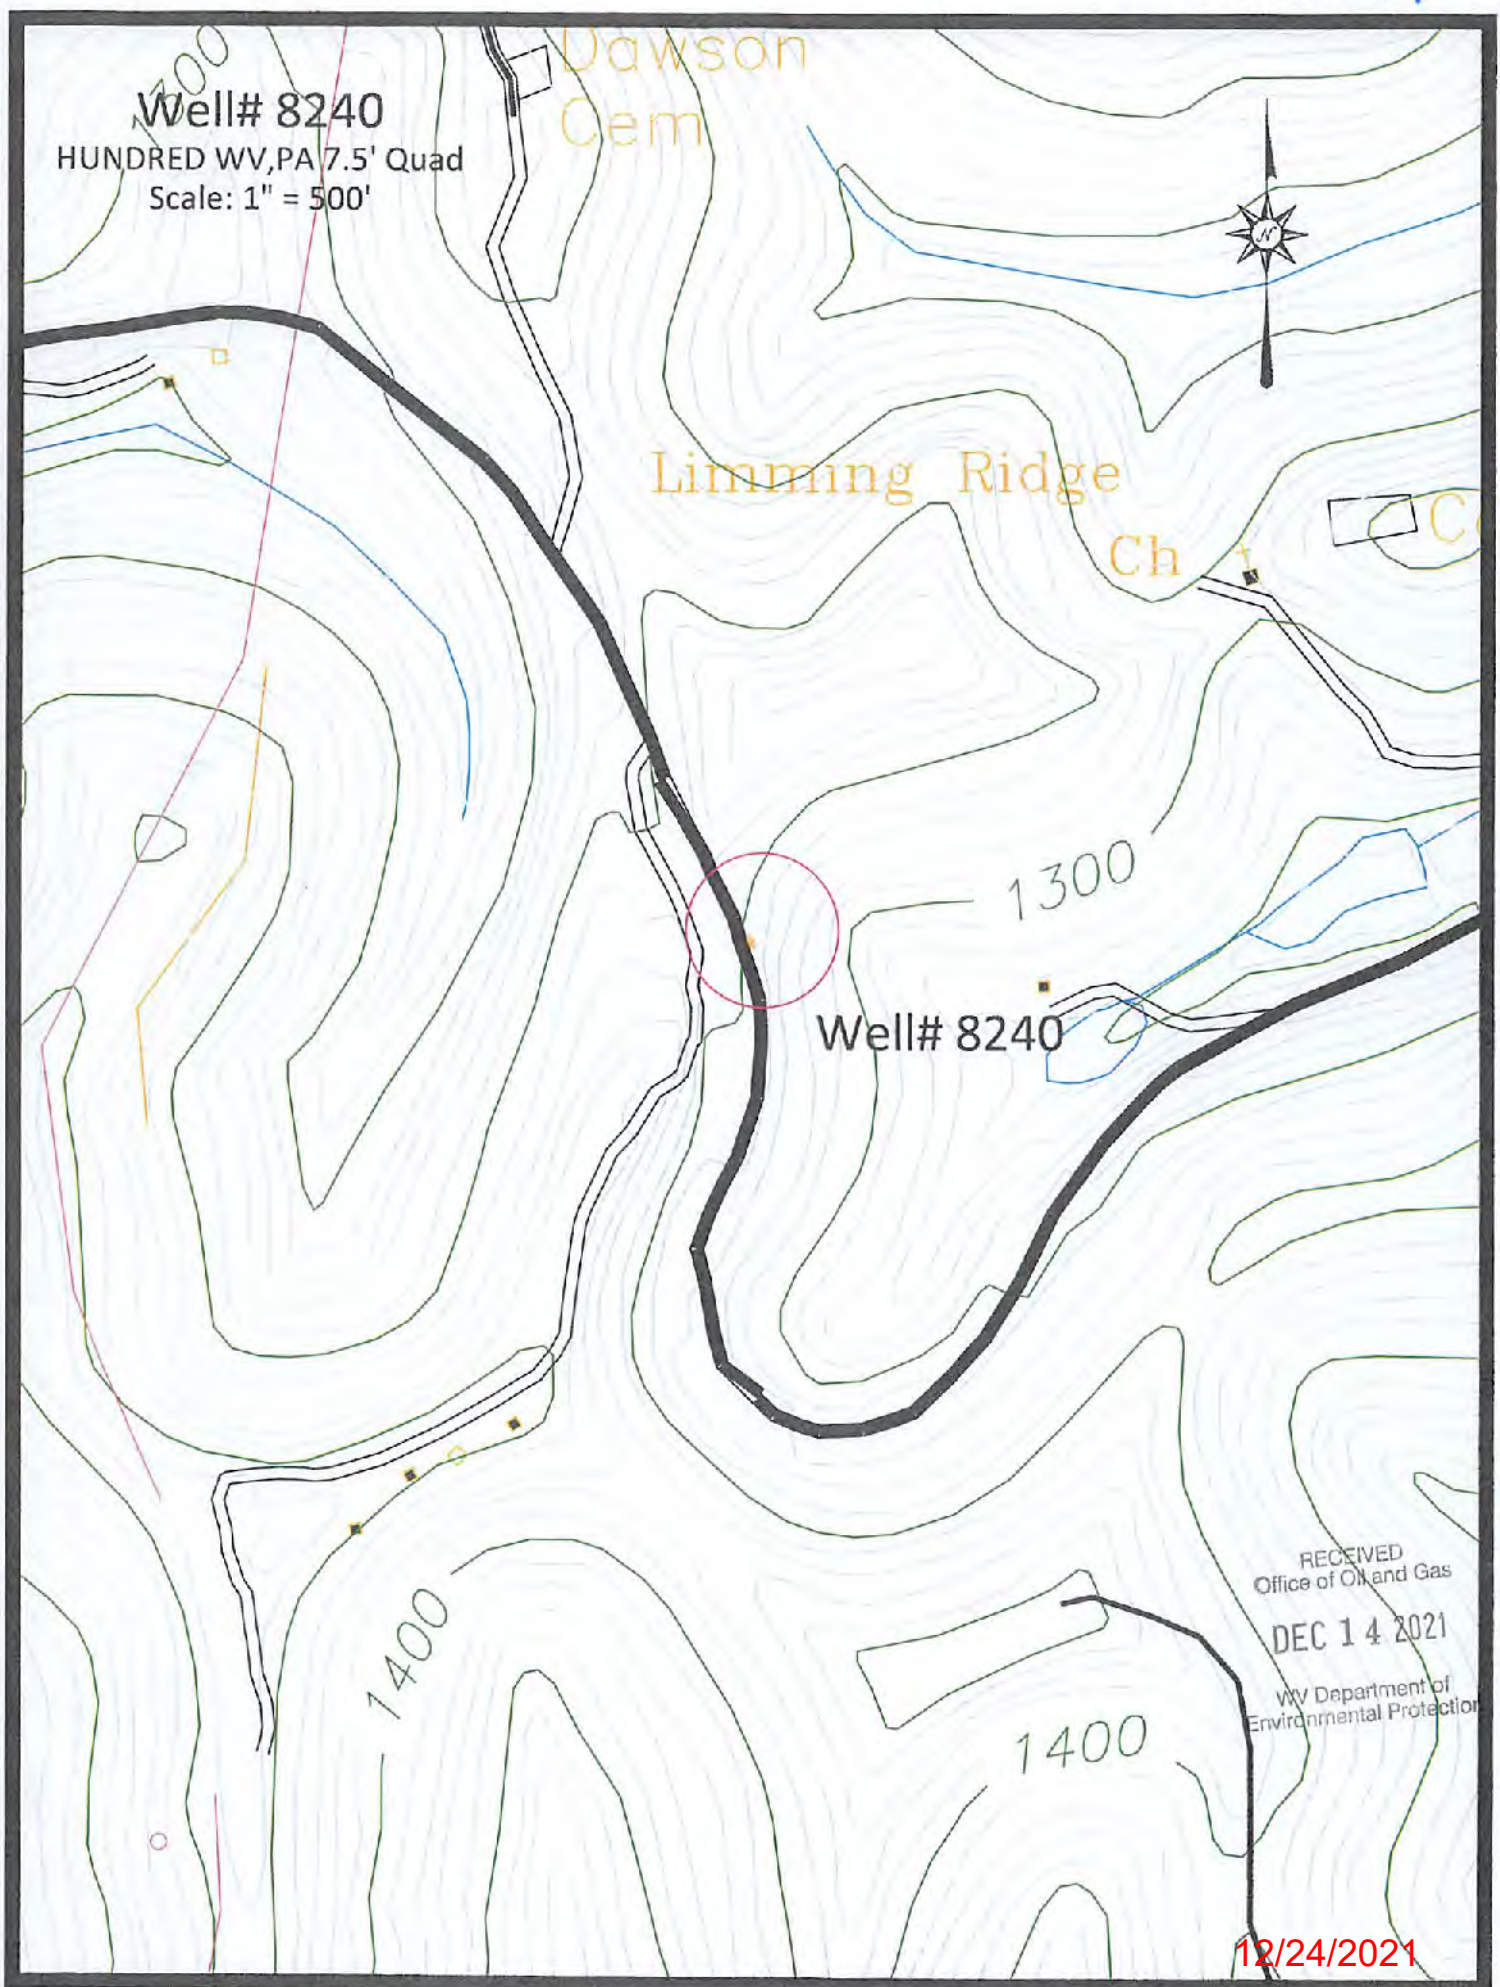

4706101897P

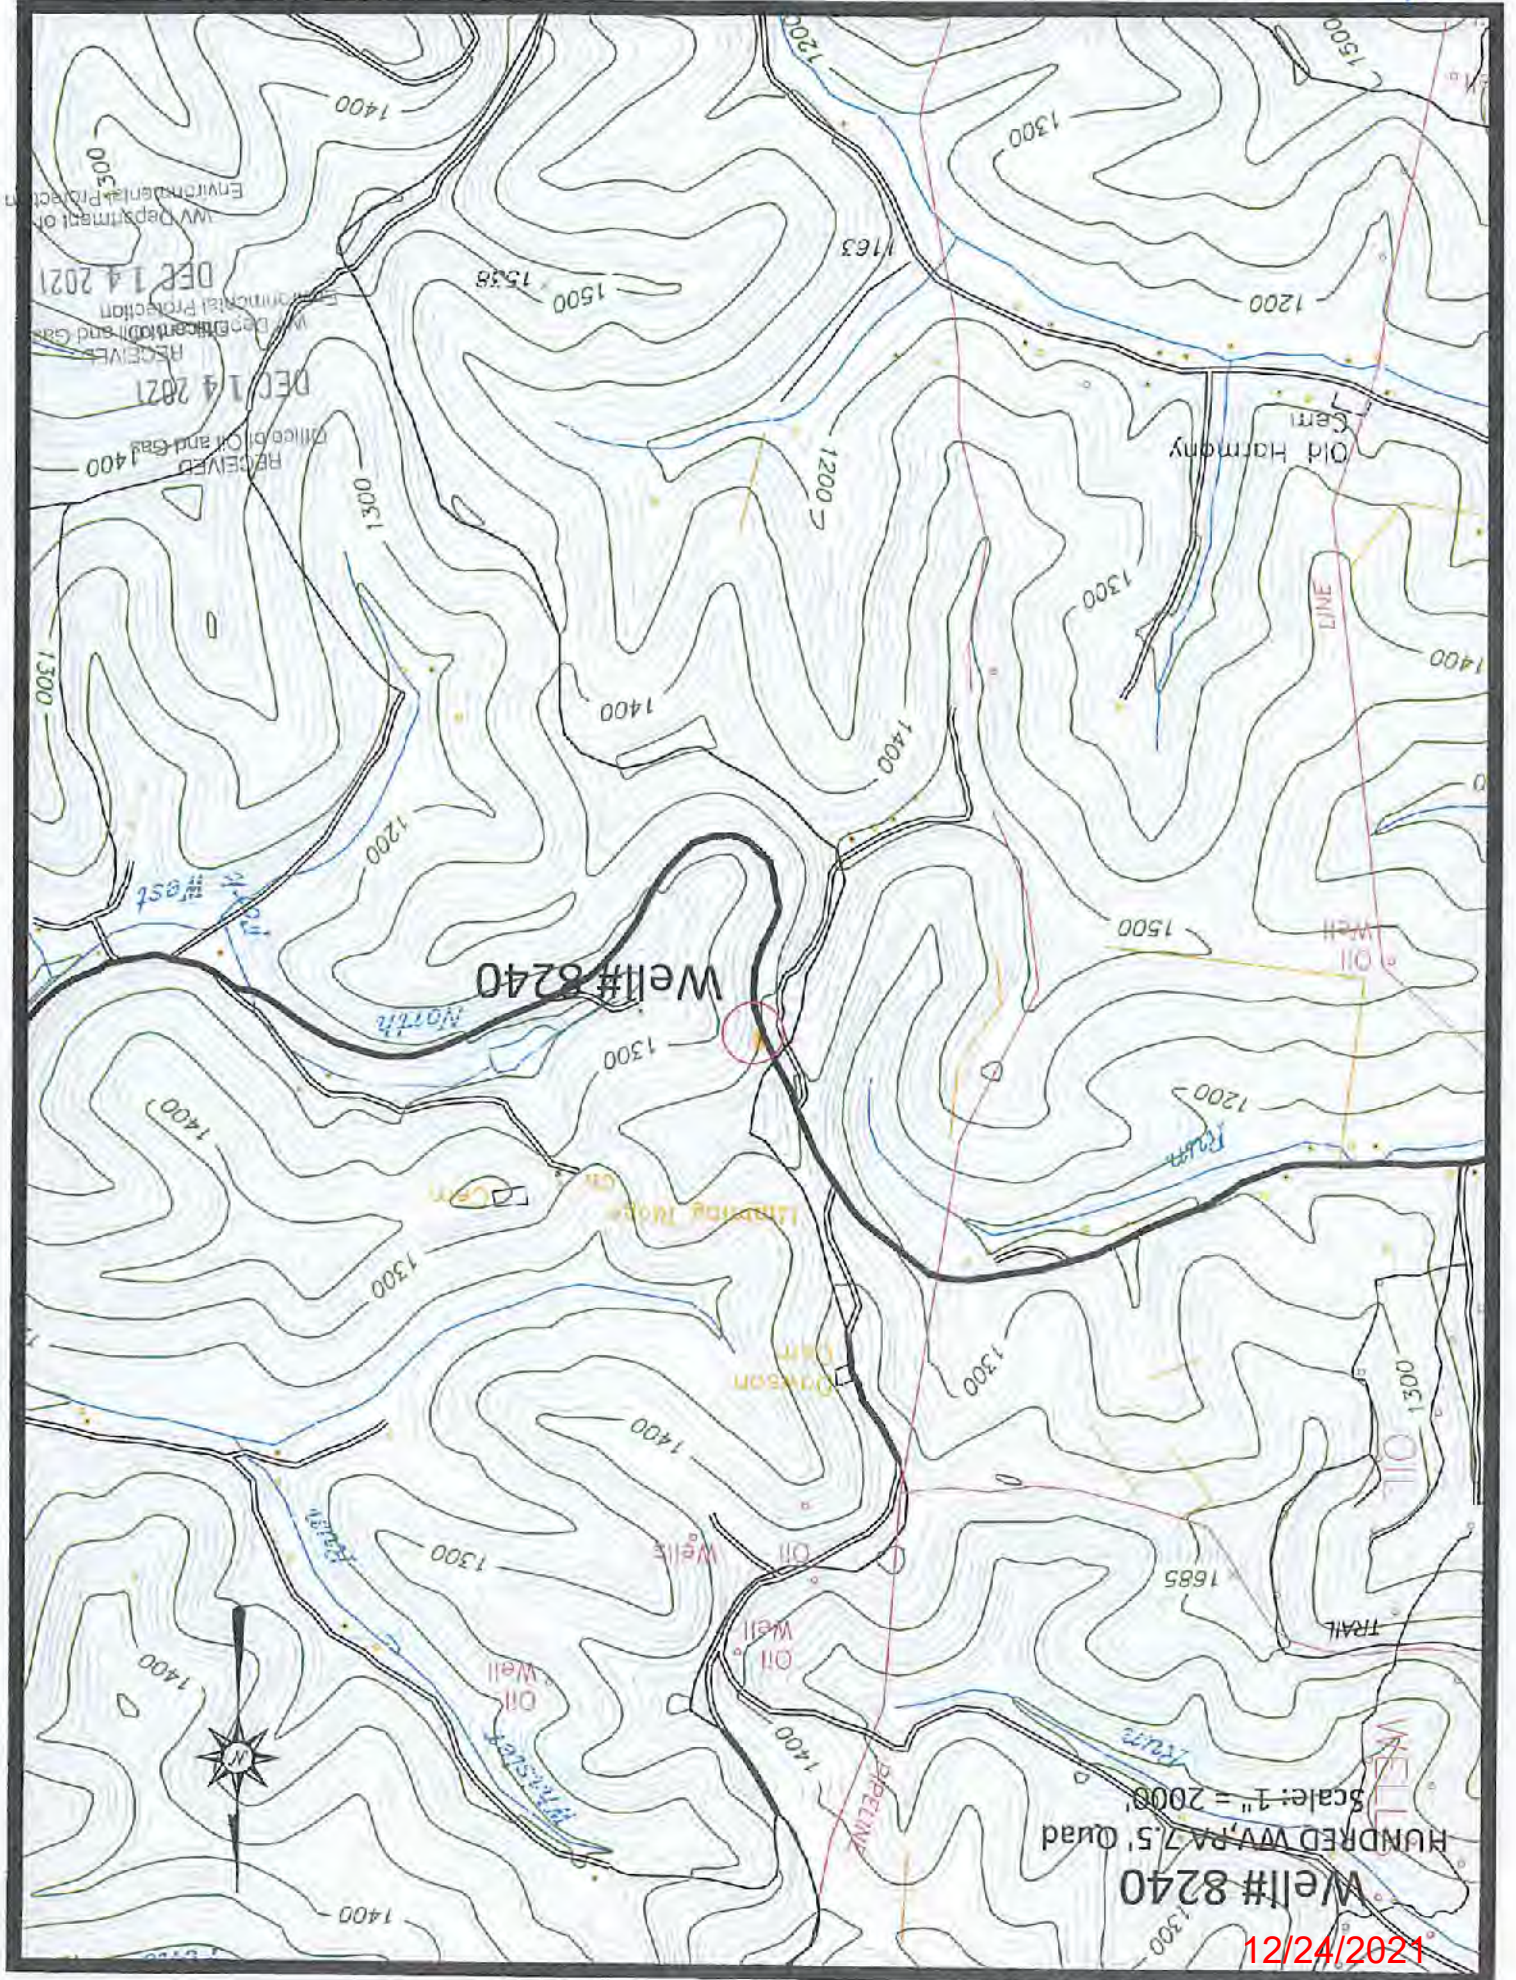

RECEIVED
 Office of Oil and Gas
 DEC 14 2021
 Environmental Protection
 DEC 14 2021
 WV Department of
 Environmental Protection
 WV Department of
 Environmental Protection

HUNDRED WV, PA 7.5' Quad
 Scale: 1" = 200'

Well# 8240

12/24/2021

4706101897P



4591
40'
4589
4588
4587

RECEIVED-1
Office of Oil and Gas
DEC 14 2021
WV Department of
Environmental Protection

147 (1.5 MI)
197 (2.2 MI)
25
1:250,000 FEET (PA) 51

52
53
39°57'30"
80°22'30"



ROAD CLASSIFICATION	
Heavy duty	Light duty
Medium duty	Unimproved dirt
U.S. Route	State Route

HUNDRED, W. VA. 12/24/2021

NW/4 MANNINGTON 15' QUADRANGLE
N 29 37.5 - WR 02 5 / 7.5

'Hundred' WV PA Scale: 1" = 0.379Mi 610M/ 2 000Ft 1 Mi = 2 640' 1 cm = 240M