


WELL NAME: BUNNER 1H BLACKSVILLE, WV

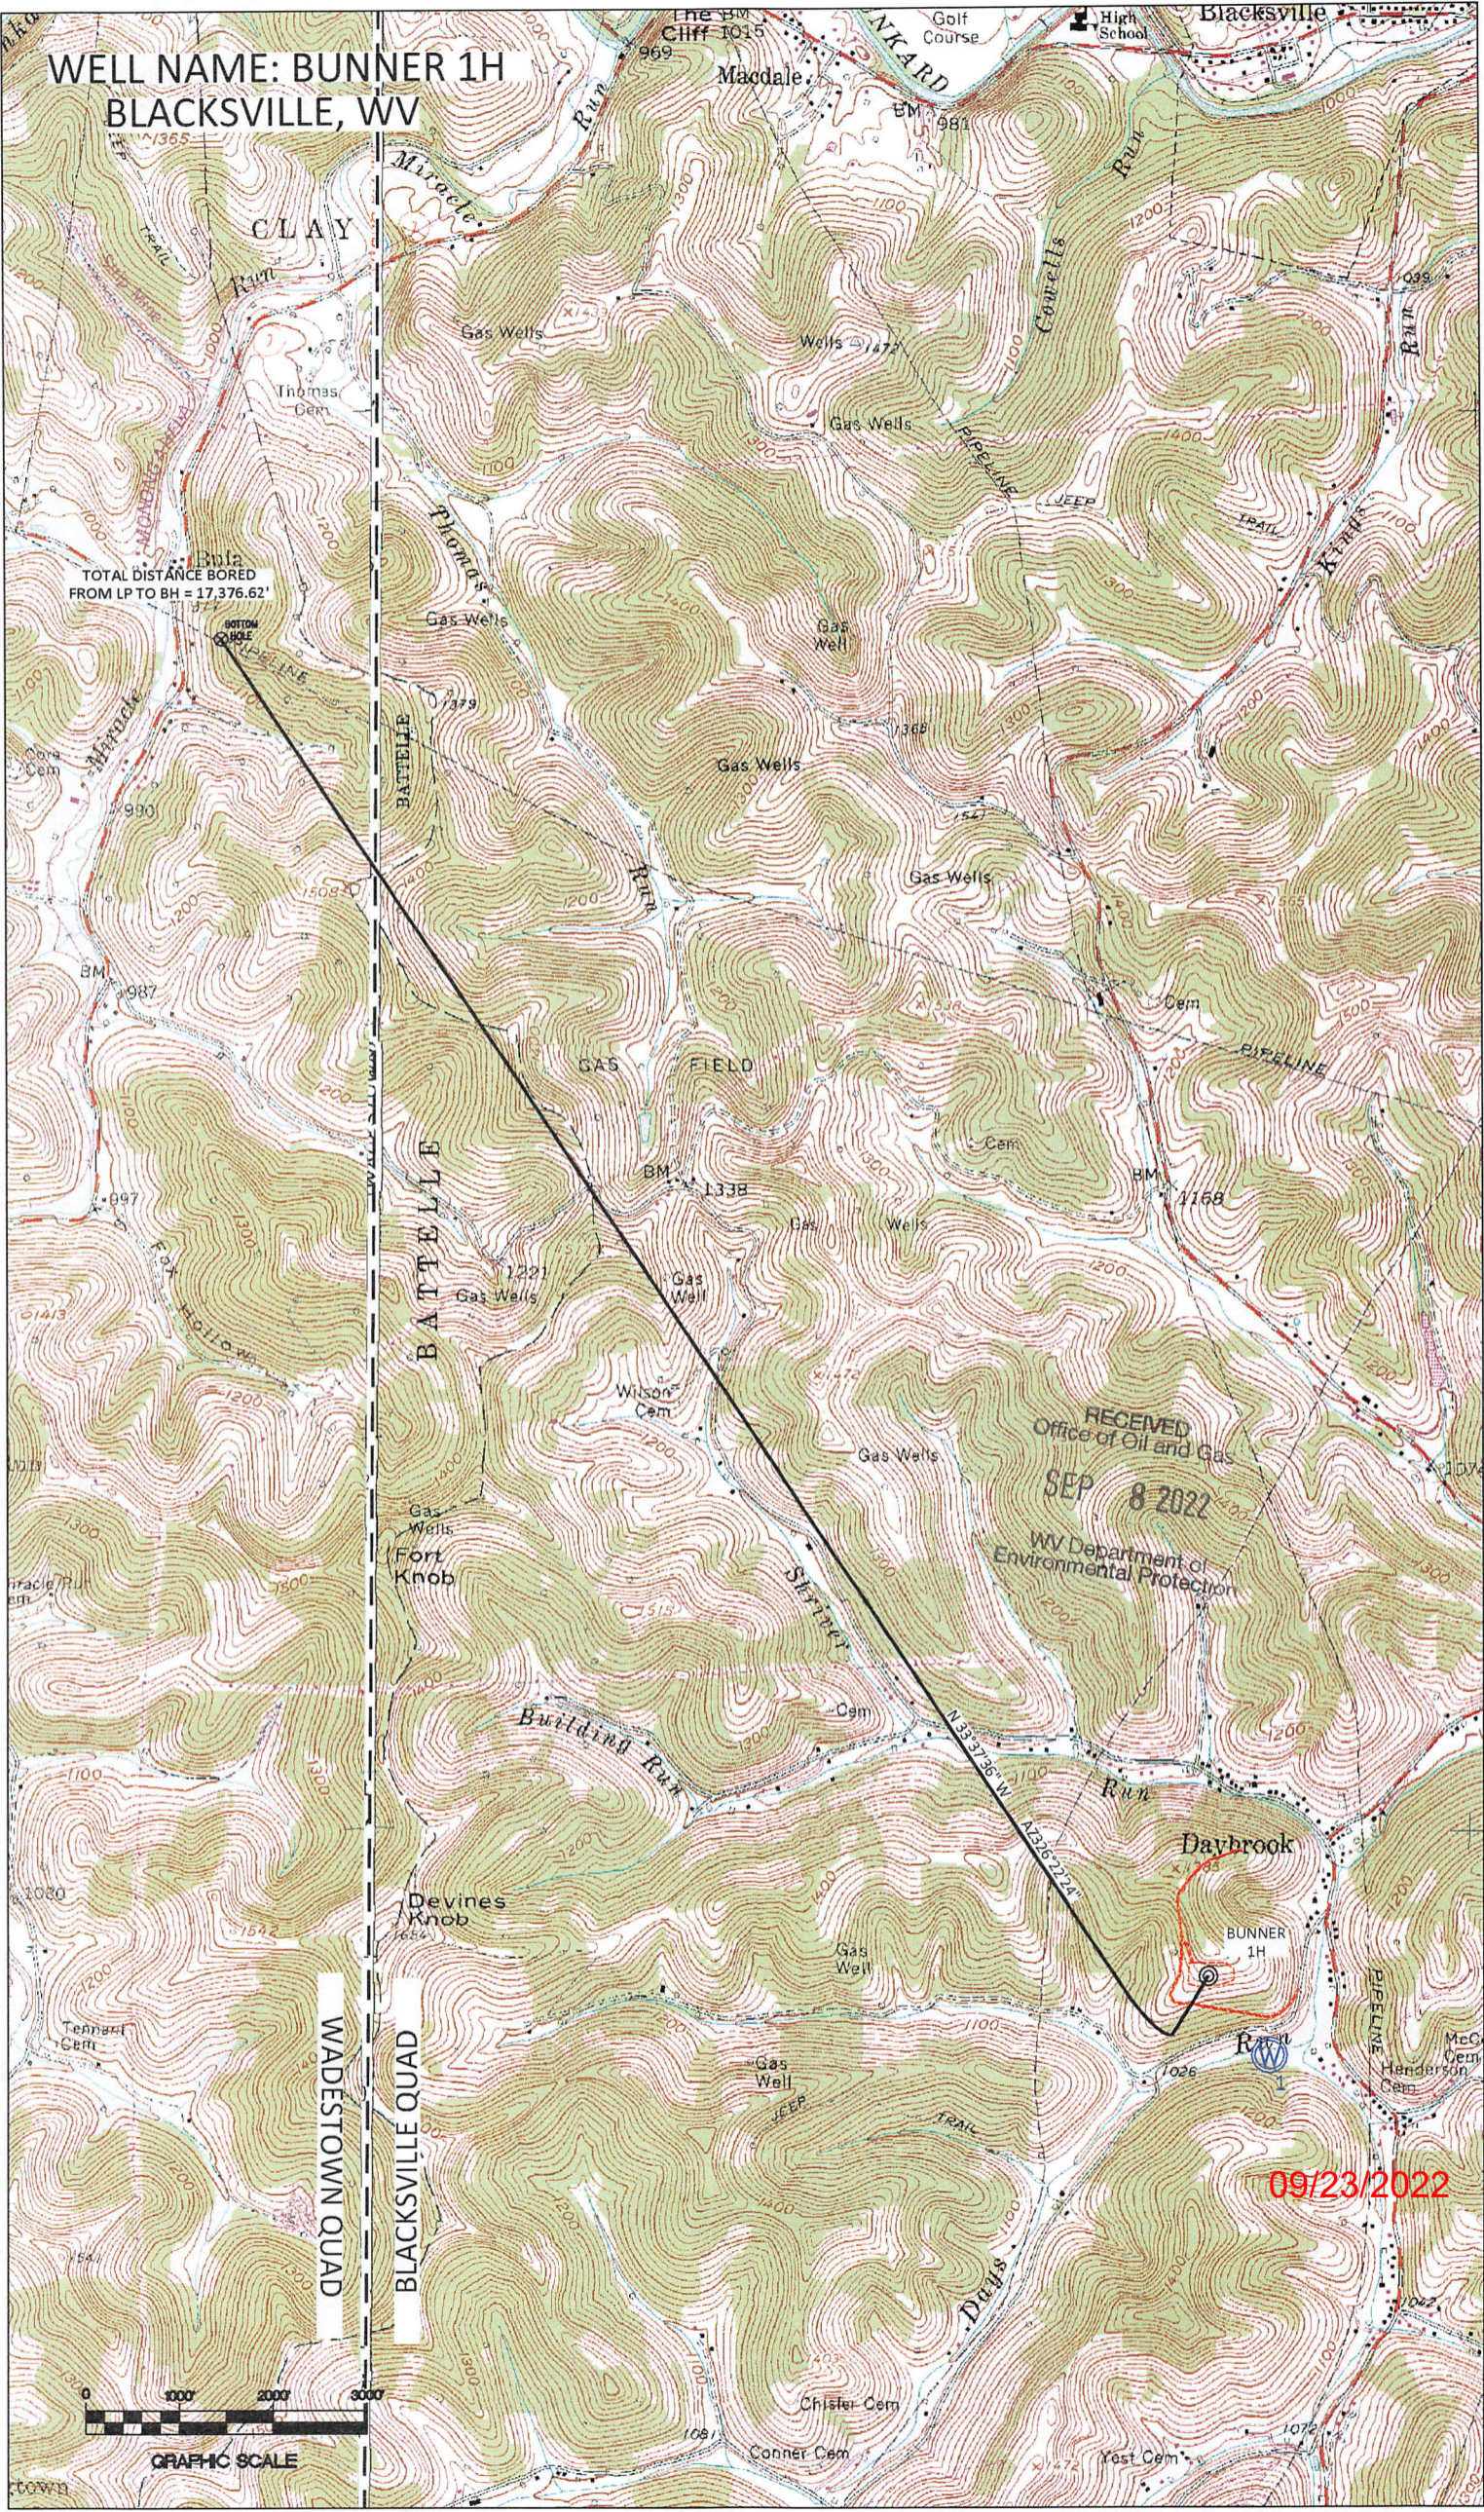

Bula
TOTAL DISTANCE BORED
FROM LP TO BH = 17,376.62'

RECEIVED
Office of Oil and Gas
SEP 8 2022
WV Department of
Environmental Protection

09/23/2022

