


SURFACE HOLE DEC. LONG: 80.217820
SURVEYED LONG: 80°13'04.2"


Latitude: 39° 40' 00" (NAD27)

Longitude: 80° 12' 30" (NAD27)
SURFACE HOLE DEC. LAT: 39.665488
SURVEYED LAT: 39.640273°

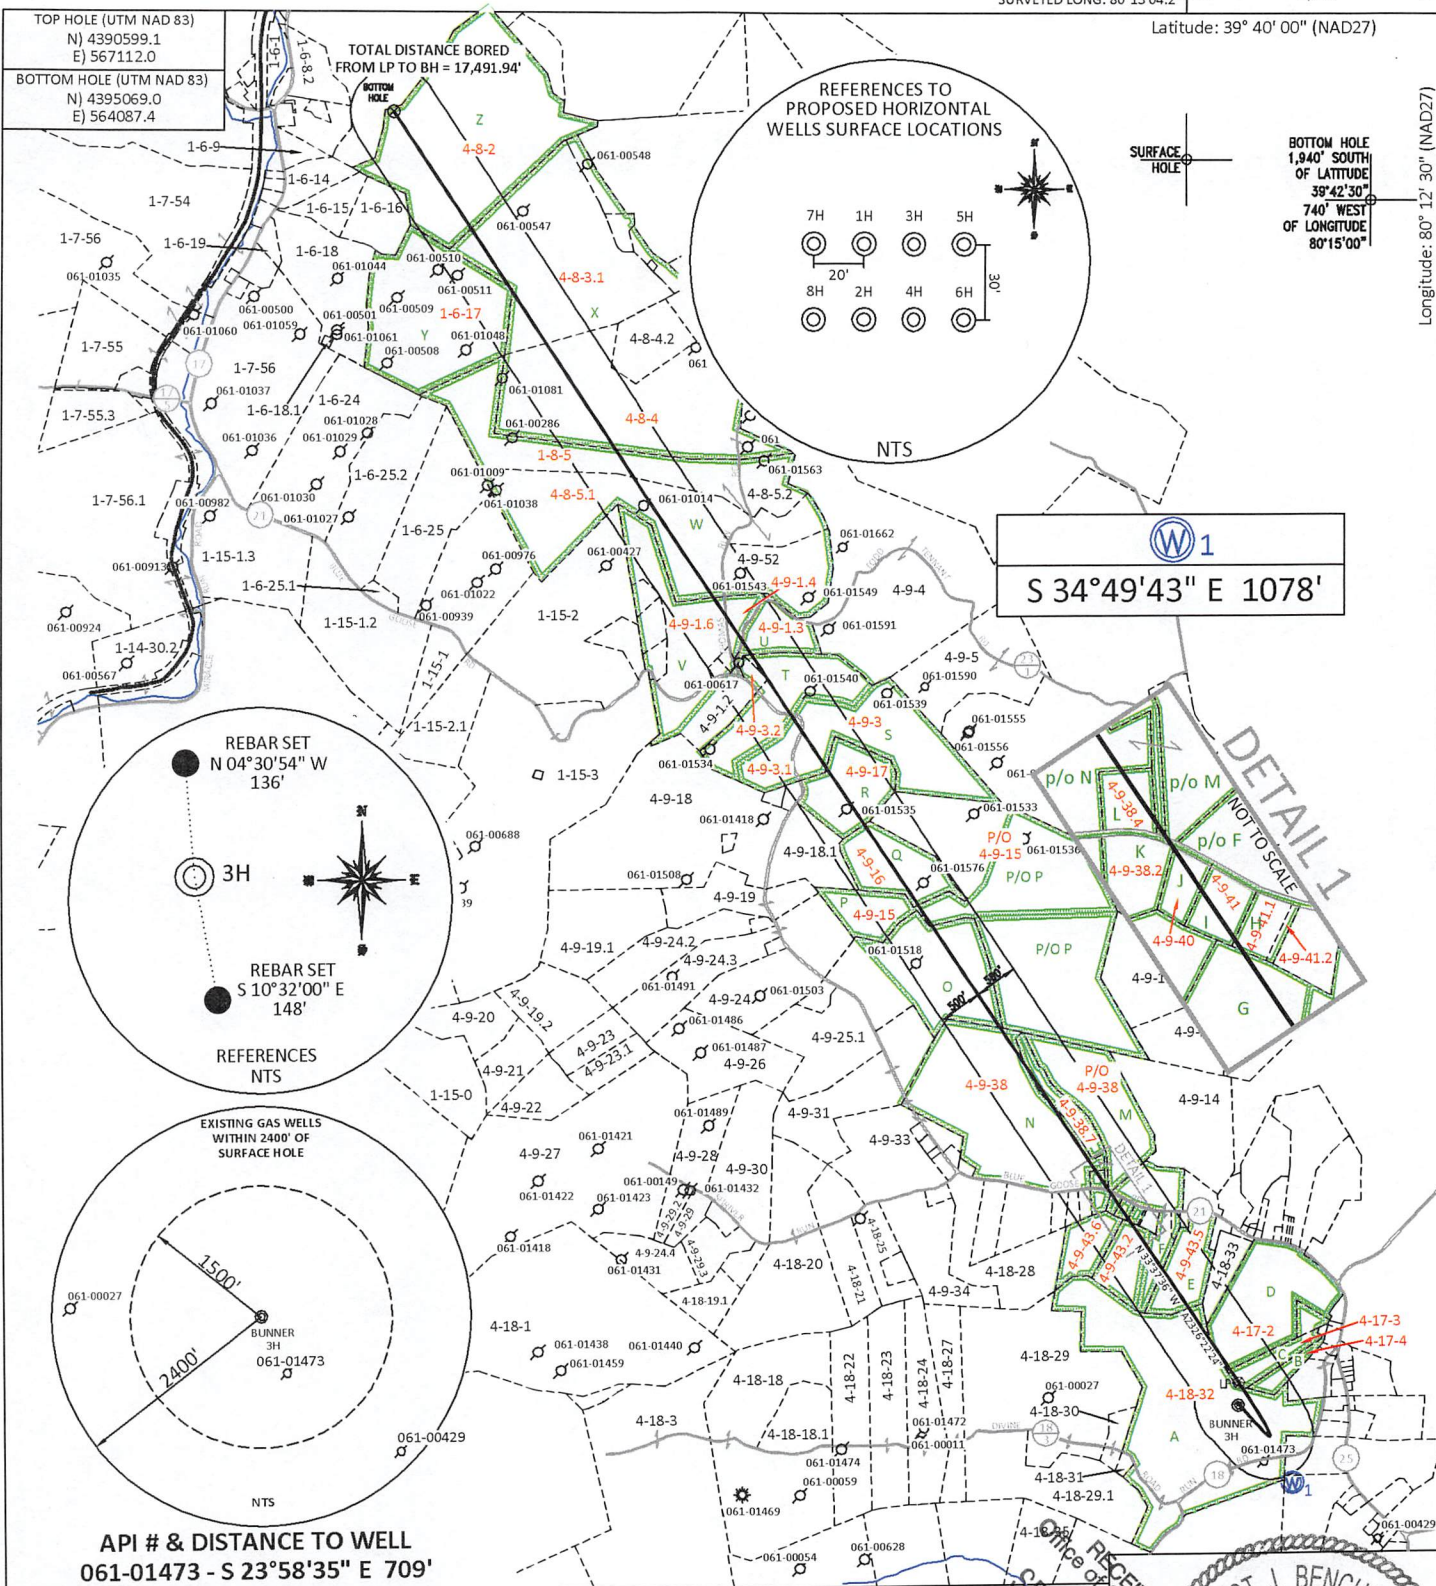

FILE #: NEE14
DRAWING #: 3075
SCALE: PLAT: 1" = 2200'
TICK MARK: 1" = 2000'
MINIMUM DEGREE OF ACCURACY: 1/200
PROVEN SOURCE SUBMETER MAPPING OF ELEVATION: GRADE GPS

I, THE UNDERSIGNED, HEREBY CERTIFY THAT THIS PLAT IS CORRECT TO THE BEST OF MY KNOWLEDGE AND BELIEF AND SHOWS ALL THE INFORMATION REQUIRED BY LAW AND THE REGULATIONS ISSUED AND PRESCRIBED BY THE DEPARTMENT OF ENVIRONMENTAL PROTECTION
Signed: *[Signature]*
L.L.S. #2124: Ernest J. Benchek III

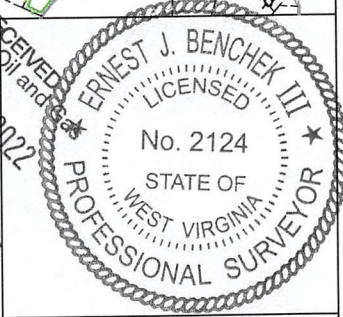

(+) DENOTES LOCATION OF WELL ON UNITED STATES TOPOGRAPHIC MAPS WVDEP
OFFICE OF OIL & GAS
601 57TH STREET
CHARLESTON, WV 25304

Well Type: Oil Waste Diposal Production Deep
 Gas Liquid Injection Storage Shallow

WATERSHED: DUNKARD CREEK
COUNTY/DISTRICT: MONONGALIA / CLAY
SURFACE OWNER: PATRICIA A. BUNNER
OIL & GAS ROYALTY OWNER: PATRICIA BUNNER, et al
LEASE NUMBERS:

DATE: AUGUST 31, 2022
OPERATOR'S WELL #: BUNNER 3H
API WELL #: 47 61 01907
STATE COUNTY PERMIT
AS-BUILT
ELEVATION: 1277.25'

QUADRANGLE: BLACKSVILLE, WV
ACREAGE: 94.72 +/-
ACREAGE: 986.8 +/-

DRILL CONVERT DRILL DEEPER REDRILL FRACTURE OR STIMULATE
PLUG OFF FORMATION PERFORATE NEW FORMATION PLUG & ABANDON
CLEAN OUT & REPLUG OTHER CHANGE (SPECIFY):

TARGET FORMATION: MARCELLUS
ESTIMATED DEPTH: TVD: 8,024' TMD: 26,022.88
WELL OPERATOR: NORTHEAST NATURAL ENERGY LLC
ADDRESS: 707 VIRGINIA STREET EAST, SUITE 1200
CITY: CHARLESTON STATE: WV ZIP CODE: 25301
DESIGNATED AGENT: JOHN ADAMS
ADDRESS: 707 VIRGINIA STREET EAST, SUITE 1200
CITY: CHARLESTON STATE: WV ZIP CODE: 25301

PROPERTY OWNER INDEX	
4-9-38	ALLEN K & VIRGINIA L MOORE
4-9-43.6	THOMAS R LUZADER
4-18-32	PATRICIA A BUNNER
4-9-38.7	ALLEN K & VIRGINIA L MOORE
4-9-43.2	ROSE MARIE MOORE
4-9-43.5	CHISLER INC
4-17-2	ANGELA L CHISLER
4-17-3	ANGELA L CHISLER
4-17-4	DAYBROOK CHURCH OF CHRIST
4-9-38.4	CHARLES E & CONNIE L SNODGRASS
4-9-38.2	TERRY L & ANGELA M SHRIVER
4-9-41	JERRY W & GATHA TETER
4-9-41.1	LOIS JEAN MCCOY
4-9-41.2	LOIS JEAN MCCOY
4-9-40	CAROLYN SUE LUZADER-NEWHOUSE
4-8-2	KATHY LYNN SNYDER, ELIZABETH ANN REESE & JOHN M BUTCHER SR
4-8-3.1	RAYMOND L ALLEN
1-6-17	JACK LEMLEY; JAMES R LEMLEY; OLESTON SURVIVORS TRUST
4-8-4	L DOUGLAS & VICKI L TENNANT
1-8-5	KENNETH W & DONNA P EFAW
4-9-1.6	ERP FEDERAL MINING COMPLEX LLC
4-8-5.1	JANICE M STILES IRREVOCABLE TRUST
4-9-1.3	ORA D & MARY ANN TENNANT
4-9-3	JEFFREY TODD & CARLENE SUE MOORE ET AL
4-9-3.2	J TODD & CARLENE S MOORE
4-9-3.1	JEFFREY TODD & CARLENE MOORE ET AL
4-9-17	GARY D YOST
4-9-16	CHARLIE CHASE II & VICKI M CHASE
4-9-15	LOIS J MCCOY ET AL

LEASE INDEX			
A	WV-061-004154-001	N	WV-061-005864-001
B	WV-061-003731-000	O	WV-061-002693-003
C	WV-061-005711-001	P	WV-061-005813-001
D	WV-061-005711-001	Q	WV-061-000160-001-LA
E	WV-061-005884-003	R	WV-061-006022-001
F	WV-061-005208-008	S	WV-061-086005-001
G	WV-061-002667-023	T	WV-061-003670-037
H	WV-061-004985-001	U	WV-061-005991-001
I	WV-061-004984-001	V	WV-061-005823-001
J	WV-061-005209-001	W	WV-061-006004-001
K	WV-061-005864-001	X	WV-061-000160-001-LA
L	WV-061-005864-001	Y	WV-061-000160-001-LA
M	WV-061-005864-001	Z	WV-061-005863-002

RECEIVED
Office of Oil and Gas
SEP 8 2022
WV Department of
Environmental Protection

09/23/2022

FILE #: NEE14
DRAWING #: 3075
SCALE: N/A

DATE: AUGUST 31, 2022
OPERATOR'S WELL #: BUNNER 3H
API WELL #: 47 61 01907
STATE COUNTY PERMIT

WELL NAME: BUNNER 3H
BLACKSVILLE, WV

TOTAL DISTANCE BORED
FROM LP TO BH = 17,491.94'

09/23/2022

