


SURFACE HOLE DEC. LONG: 80.217962  
SURVEYED LONG: 80°13'04.7"

2,710'

Latitude: 39° 40' 00" (NAD27)

Longitude: 80° 12' 30" (NAD27)

1,520'

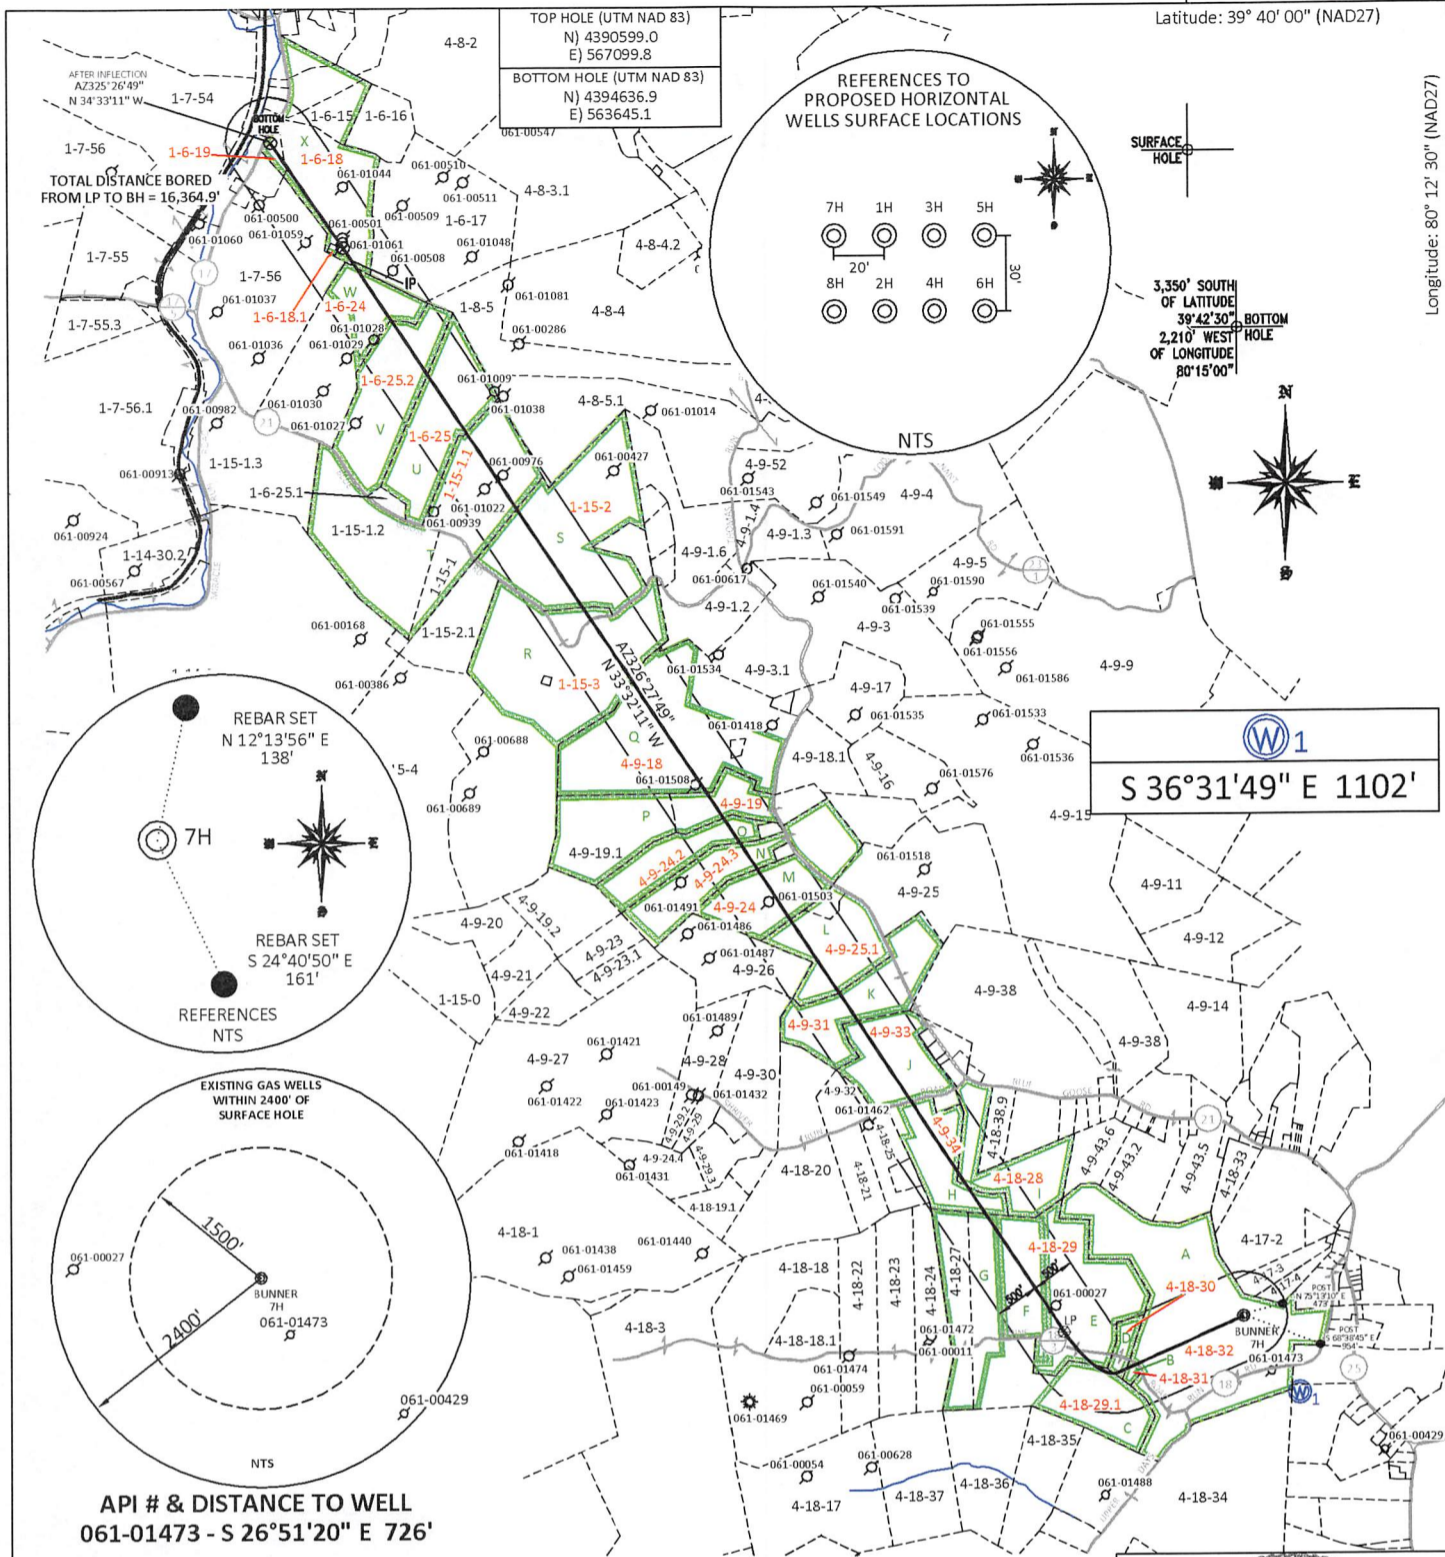


**W1**  
S 36°31'49" E 1102'

API # & DISTANCE TO WELL  
061-01473 - S 26°51'20" E 726'

FILE #: NEE14  
DRAWING #: 3077  
SCALE: PLAT: 1" = 2200'  
TICK MARK: 1" = 2000'  
MINIMUM DEGREE OF ACCURACY: 1/200  
PROVEN SOURCE OF ELEVATION: SUBMETER MAPPING GRADE GPS

I, THE UNDERSIGNED, HEREBY CERTIFY THAT THIS PLAT IS CORRECT TO THE BEST OF MY KNOWLEDGE AND BELIEF AND SHOWS ALL THE INFORMATION REQUIRED BY LAW AND THE REGULATIONS ISSUED AND PRESCRIBED BY THE DEPARTMENT OF ENVIRONMENTAL PROTECTION.  
Signed: [Signature]  
L.L.S. #2124 : Ernest J. Benchek III

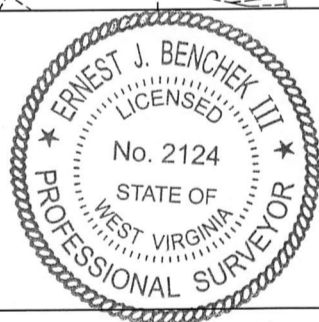

(+) DENOTES LOCATION OF WELL ON UNITED STATES TOPOGRAPHIC MAPS WVDEP  
OFFICE OF OIL & GAS  
601 57TH STREET  
CHARLESTON, WV 25304  
Well Type:  Oil  Waste Diposal  Production  Deep  
 Gas  Liquid Injection  Storage  Shallow  
WATERSHED: DUNKARD CREEK  
COUNTY/DISTRICT: MONONGALIA / CLAY  
SURFACE OWNER: PATRICIA A. BUNNER  
OIL & GAS ROYALTY OWNER: PATRICIA BUNNER, et al  
LEASE NUMBERS: \_\_\_\_\_

DATE: AUGUST 31, 2022  
OPERATOR'S WELL #: BUNNER 7H  
API WELL #: 47 61 01909  
STATE COUNTY PERMIT  
AS-BUILT  
ELEVATION: 1277.25'

DRILL  CONVERT  DRILL DEEPER  REDRILL  FRACTURE OR STIMULATE   
PLUG OFF FORMATION  PERFORATE NEW FORMATION  PLUG & ABANDON   
CLEAN OUT & REPLUG  OTHER CHANGE  (SPECIFY): \_\_\_\_\_  
TARGET FORMATION: MARCELLUS  
WELL OPERATOR: NORTHEAST NATURAL ENERGY LLC  
ADDRESS: 707 VIRGINIA STREET EAST, SUITE 1200  
CITY: CHARLESTON STATE: WV ZIP CODE: 25301  
ESTIMATED DEPTH: TVD: 8,024 TMD: 25,139.34  
DESIGNATED AGENT: JOHN ADAMS  
ADDRESS: 707 VIRGINIA STREET EAST, SUITE 1200  
CITY: CHARLESTON STATE: WV ZIP CODE: 25301

QUADRANGLE: BLACKSVILLE, WV  
ACREAGE: 94.72 +/- **09/23/2022**  
ACREAGE: 792.09 +/-

PROPERTY OWNER INDEX	
4-18-30	PRUDENCE G BERRY
4-18-32	PATRICIA A BUNNER
4-18-31	ROBERT ELDON BERRY; PRUDENCE G BERRY & DEBRA JEAN JONES
4-18-29.1	BILLY VON DEVINE
4-9-34	DANNY K & MONICA MOORE
4-18-28	SHANNON REEVES
4-18-29	GILBERT DONALD BERRY (LIFE-ROBERT E BERRY SR)
1-6-19	VERNON C VARNER & TAMMY R TENNANT
1-6-18	DAVID N & WILLA R HOWARD
1-6-18.1	CLAY BATTELLE PUBLIC SERVICE DISTRICT
1-6-24	ROGER E SWANSON; MELVIN L SWANSON, ET AL (LIFE SHELBY LEARY)
1-6-25.2	DANIEL A ROBBINS
1-6-25	JOSEPH T & DEBRA L MERCER
1-15-1.1	ROD L & DEBORAH E CARPENTER
1-15-2	ERP FEDERAL MINING COMPLEX LLC
4-9-18	JODIE DAWN & JEFFREY LANE SHRIVER
4-9-19	BART L, CHRIS M & BUCKEY L WILSON
1-15-3	SHUMAN INC
4-9-24.2	EVERETT D WILSON; DOTTIE REEMAN; CINDY DONALDSON
4-9-24.3	AARON D & CARLA R WILSON
4-9-24	HAMPTON D COTTRELL
4-9-25.1	JEFFREY J & SANDRA J MOORE
4-9-31	ALLEN K & VIRGINIA L MOORE
4-9-33	CHRISTOPHER BLAINE & SHARON WILSON

LEASE INDEX			
A	WV-061-004154-001	M	WV-061-004823-023
B	WV-061-005378-013	N	WV-061-004823-023
C	WV-061-005639-001	O	WV-061-004823-023
D	WV-061-005378-013	P	WV-061-004823-023
E	WV-061-005966-001	Q	WV-061-004821-004
F	WV-061-005899-001	R	WV-061-005889-001
G	WV-061-005890-001	S	WV-061-004139-001
H	WV-061-005189-001	T	WV-061-005889-001
I	WV-061-005189-011	U	WV-061-005806-001
J	WV-061-004996-001	V	WV-061-005829-001
K	WV-061-000160-001-LA	W	WV-061-005806-001
L	WV-061-000160-001-LA	X	WV-061-003896-005

RECEIVED  
Office of Oil and Gas  
SEP 8 2022  
WV Department of  
Environmental Protection

09/23/2022

FILE #: <u>NEE14</u>	DATE: <u>AUGUST 31, 2022</u>
DRAWING #: <u>3077</u>	OPERATOR'S WELL #: <u>BUNNER 7H</u>
SCALE: <u>N/A</u>	API WELL #: <u>47</u> <u>61</u> <u>01909</u> STATE COUNTY PERMIT

WELL NAME: BUNNER 7H  
BLACKSVILLE, WV

CLAY  
WADESTOWN QUAD  
BLACKSVILLE QUAD

TOTAL DISTANCE BORED  
FROM LP TO BH = 16,364.9'

RECEIVED  
Office of Oil and Gas  
SEP 8 2022  
WV Department of  
Environmental Protection

09/23/2022

