


FILE #: NNE20
 DRAWING #: 3047
 SCALE: PLAT: 1" = 2000'
TICK: 1" = 2000'
 MINIMUM DEGREE OF ACCURACY: 1/200
 PROVEN SOURCE OF ELEVATION: SUBMETER MAPPING GRADE GPS

I, THE UNDERSIGNED, HEREBY CERTIFY THAT THIS PLAT IS CORRECT TO THE BEST OF MY KNOWLEDGE AND BELIEF AND SHOWS ALL THE INFORMATION REQUIRED BY LAW AND THE REGULATIONS ISSUED AND PRESCRIBED BY THE DEPARTMENT OF ENVIRONMENTAL PROTECTION.
 Signed: [Signature]
 L.L.S. #2124 : Ernest J. Benchek III

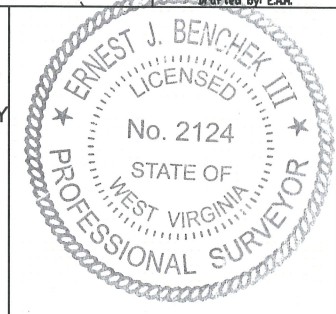

(+) DENOTES LOCATION OF WELL ON UNITED STATES TOPOGRAPHIC MAPS WVDEP
 OFFICE OF OIL & GAS
 601 57TH STREET
 CHARLESTON, WV 25304
 Well Type: Oil Waste Diposal Production Deep
 Gas Liquid Injection Storage Shallow
 WATERSHED: UPPER MONONGAHELA RIVER AS-BUILT ELEVATION: 1,476'
 COUNTY/DISTRICT: MONONGALIA / CLAY QUADRANGLE: GRANT TOWN
 SURFACE OWNER: ALAN SULLIVAN ACREAGE: 870.94 +/-
 OIL & GAS ROYALTY OWNER: ALAN SULLIVAN ACREAGE: 25.870 **02/23/2024**
 LEASE NUMBERS: _____
 DRILL CONVERT DRILL DEEPER REDRILL FRACTURE OR STIMULATE
 PLUG OFF FORMATION PERFORATE NEW FORMATION PLUG & ABANDON
 CLEAN OUT & REPLUG OTHER CHANGE (SPECIFY): _____
 TARGET FORMATION: MARCELLUS
 WELL OPERATOR: NORTHEAST NATURAL ENERGY LLC DRILLED DEPTH: TVD: 8,200' TMD: 21,813'
 ADDRESS: 707 VIRGINIA STREET EAST, SUITE 1200 DESIGNATED AGENT: JOHN ADAMS
 CITY: CHARLESTON STATE: WV ZIP CODE: 25301 ADDRESS: 707 VIRGINIA STREET EAST, SUITE 1200
 CITY: CHARLESTON STATE: WV ZIP CODE: 25301

4-19-14	PENNY S QUICKLE
4-19-23	BOYD & MARY STARKEY ESTATE
4-26-35	RANDY LEE & TRINA TENNANT
4-26-34	SHIRLEY J NEELY, DEANNA M FRAZIER, DONNA J WALDEN & DARRIN NEELY
4-26-18	ROSE MARIE FLUHARTY
4-26-30	THOMAS R & LISA A LUZADER
4-26-38	ADAM CLAY DARRAH
4-26-30.2	WAYNE WHIPKEY
4-26-17	ROSE MARIE FLUHARTY
4-26-29	WAYNE WHIPKEY
4-19-14.2	PENNY S QUICKLE
4-19-26	CHARLES W MOORE; JASON T & KIRSTON KARSON (LIFE)
4-19-24	EDITH L DARRAH
4-19-25	SHIRLEY L MOORE ESTATE
4-19-49	ROCKY & CATHY J BARR
4-26-12	KENNETH W & RUTH E ALBERT
4-26-35.1	ALAN SULLIVAN
4-26-26	NNE MIDSTREAM LLC
4-26-20	KENNETH W & RUTH E ALBERT
4-19-6	JIMMY R & PAMELA K TENNANT; RAY & ROXANA CAHILL
4-19-7	STEPHEN R WILSON, ET AL
4-19-1.1	KEMBLE D TATE

LEASE INDEX			
A	WV-061-000160-001-ACT	I	WV-061-003931-001
B	WV-061-005448-002	J	WV-061-003931-011
C	WV-061-000160-001-ACT	K	WV-061-003931-002
D	WV-061-000165-001 - LA	L	WV-061-000160-001-ACT
E	WV-061-000160-001-ACT	M	WV-061-003931-011
F	WV-061-005998-001	N	WV-061-000160-001-ACT
G	WV-061-004797-039	O	WV-061-004792-004
H	WV-061-000160-001-ACT	P	WV-061-005788-001
		Q	WV-061-005876-002

02/23/2024

FILE #: <u>NEE20</u>	DATE: <u>FEBRUARY 5, 2024</u>
DRAWING #: <u>3047</u>	OPERATOR'S WELL #: <u>SULLIVAN 9H AS-DRILLED</u>
SCALE: <u>N/A</u>	API WELL #: <u>47</u> <u>61</u> <u>01920</u> STATE COUNTY PERMIT