
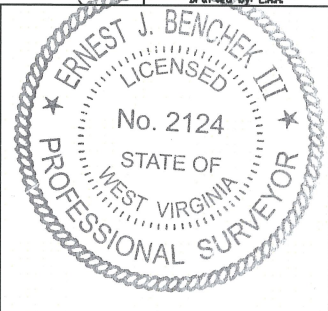


FILE #: NNE20
 DRAWING #: 3046
 SCALE: PLAT: 1" = 2000'
TICK: 1" = 2000'
 MINIMUM DEGREE OF ACCURACY: 1/200
 PROVEN SOURCE OF ELEVATION: SUBMETER MAPPING GRADE GPS

I, THE UNDERSIGNED, HEREBY CERTIFY THAT THIS PLAT IS CORRECT TO THE BEST OF MY KNOWLEDGE AND BELIEF AND SHOWS ALL THE INFORMATION REQUIRED BY LAW AND THE REGULATIONS ISSUED AND PRESCRIBED BY THE DEPARTMENT OF ENVIRONMENTAL PROTECTION.
 Signed: 
 L.L.S. #2124 : Ernest J. Benchek III



(+) DENOTES LOCATION OF WELL ON UNITED STATES TOPOGRAPHIC MAPS
 WVDEP
 OFFICE OF OIL & GAS
 601 57TH STREET
 CHARLESTON, WV 25304

DATE: FEBRUARY 29, 2024
 OPERATOR'S WELL #: SULLIVAN 13H AS-DRILLED
 API WELL #: 47 61 01921
 STATE COUNTY PERMIT
 AS-BUILT ELEVATION: 1,476'
 WATERSHED: UPPER MONONGAHELA RIVER
 COUNTY/DISTRICT: MONONGALIA / CLAY
 SURFACE OWNER: ALAN SULLIVAN
 OIL & GAS ROYALTY OWNER: ALAN SULLIVAN
 LEASE NUMBERS: _____
 QUADRANGLE: GRANT TOWN
 ACREAGE: 779.53 +/-
 ACREAGE: 25.870 **02/23/2024**

Well Type: Oil Waste Diposal Production Deep
 Gas Liquid Injection Storage Shallow

DRILL CONVERT DRILL DEEPER REDRILL FRACTURE OR STIMULATE
 PLUG OFF FORMATION PERFORATE NEW FORMATION PLUG & ABANDON
 CLEAN OUT & REPLUG OTHER CHANGE (SPECIFY): _____

TARGET FORMATION: MARCELLUS
 WELL OPERATOR: NORTHEAST NATURAL ENERGY LLC
 ADDRESS: 707 VIRGINIA STREET EAST, SUITE 1200
 CITY: CHARLESTON STATE: WV ZIP CODE: 25301
 DRILLED DEPTH: TVD: 8,163' TMD: 21,740'
 DESIGNATED AGENT: JOHN ADAMS
 ADDRESS: 707 VIRGINIA STREET EAST, SUITE 1200
 CITY: CHARLESTON STATE: WV ZIP CODE: 25301

4-19-8	CHARLES W MOORE; JASON T & KIRSTON KARSON (LIFE)
4-19-7	STEPHEN R WILSON ET AL
4-19-14	PENNY S QUICKLE
4-19-17	LEWIS M MAXWELL II & SHERRY E MAXWELL
4-19-23	BOYD & MARY STARKEY ESTATE
4-26-12	KENNETH W & RUTH E ALBERT
4-26-35.1	ALAN SULLIVAN
4-26-35	RANDY LEE & TRINA TENNANT
4-26-34	SHIRLEY J NEELY, DEANNA M FRAZIER, DONNA J WALDEN & DARRIN NEELY
4-26-18	ROSE MARIE FLUHARTY
4-26-31	ERNEST E & HILERI GORBIEY
4-26-14	ELLEN M CURFMAN
4-26-13	ROSE MARIE FLUHARTY
4-26-18.1	JEFFERY A & BETH FLUHARTY
4-26-30	THOMAS R & LISA A LUZADER
4-26-30.3	LARRY L WHIPKEY
4-26-16	KEVIN MOORE
4-26-15	KEVIN MOORE
4-26-26	NNE MIDTREAM LLC
4-26-38	ADAM CLAY DARRAH

LEASE INDEX			
A	WV-061-000160-001-ACT	G	WV-061-004797-039
B	WV-061-005448-002	H	WV-061-001422-003
C	WV-061-000160-001-ACT	I	WV-061-000160-001-ACT
D	WV-061-000165-001 - LA	J	WV-061-004792-004
E	WV-061-000160-001-ACT	K	WV-061-004357-005
F	WV-061-005998-001	L	WV-061-002965-004

02/23/2024

FILE #: NEE20

DRAWING #: 3046

SCALE: N/A

DATE: FEBRUARY 29, 2024

OPERATOR'S WELL #: SULLIVAN 13H AS-DRILLED

API WELL #: 47 61 01921
STATE COUNTY PERMIT