


47061019309

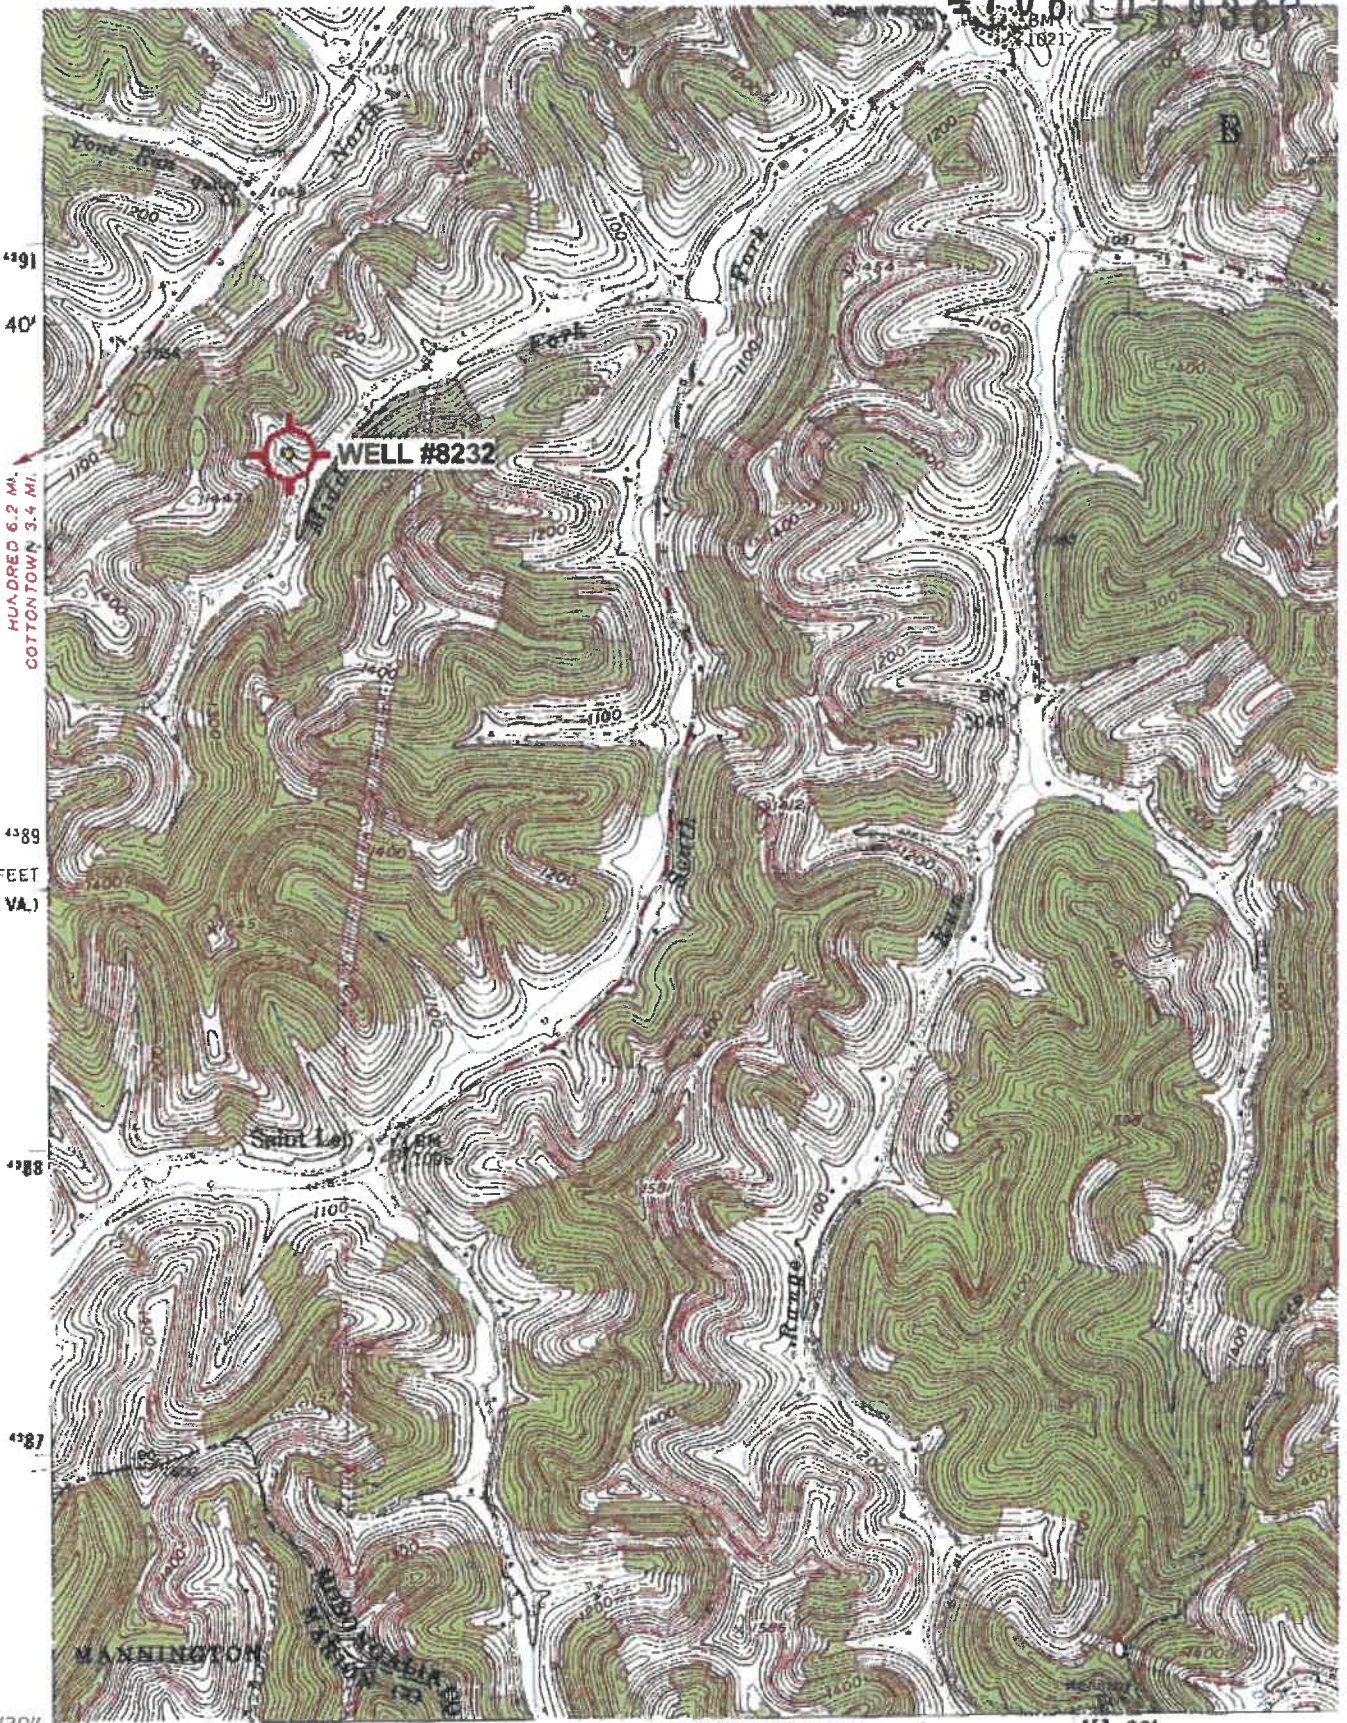

491
40'
HUNDRED 6.2 MI.
COTTONTOWN 3.4 MI.

489
420 000 FEET
(W. VA.)

488

487

39°37'30"
80°22'30"

54

55

1 760 000 FEET (W. VA.)


57 20'
1160'

Office of Oil and Gas

MAY 15 2023

WV Department of
Environmental Protection

06/16/2023

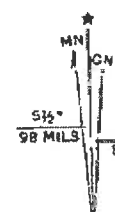

Mapped, edited, and published by the Geological Survey
Control by USGS and USC&GS
Topography from aerial photographs by photogrammetric methods
Aerial photographs taken 1956. Field check 1958
Polyconic projection. 1927 North American datum
10,000-foot grids based on West Virginia coordinate system,
"Wadestown: WV.PA" Scale: 1" = 0.379Mi 610M: 2 000F: 1 Mi = 2 640" 1 cm = 240M

GLOVER GAP
4883 III SW

WW-7
8-30-06



West Virginia Department of Environmental Protection
Office of Oil and Gas

WELL LOCATION FORM: GPS

API: 47-061-70178 WELL NO.: 8232

FARM NAME: SOLOMON M. SHRIVER

RESPONSIBLE PARTY NAME: WEST VIRGINIA LAND RESOURCES INC.

COUNTY: MONONGALIA DISTRICT: BATTELLE

QUADRANGLE: HUNDRED W.VA, PA

SURFACE OWNER: GEORGE D. SIX

ROYALTY OWNER: _____

UTM GPS NORTHING: 4,390,521 m (1118.5')

UTM GPS EASTING: 554,437 m GPS ELEVATION: 341 m

The Responsible Party named above has chosen to submit GPS coordinates in lieu of preparing a new well location plat for a plugging permit or assigned API number on the above well. The Office of Oil and Gas will not accept GPS coordinates that do not meet the following requirements:

- Datum: NAD 1983, Zone: 17 North, Coordinate Units: meters, Altitude: height above mean sea level (MSL) – meters.
- Accuracy to Datum – 3.05 meters
- Data Collection Method:

Survey grade GPS _____: Post Processed Differential _____

Real-Time Differential _____

Mapping Grade GPS : Post Processed Differential

Real-Time Differential _____

- Letter size copy of the topography map showing the well location.

I the undersigned, hereby certify this data is correct to the best of my knowledge and belief and shows all the information required by law and the regulations issued and prescribed by the Office of Oil and Gas.

Signature

Professional Surveyor

Title

MARCH 31, 2023

Date

RECEIVED
Office of Oil and Gas

MAY 15 2023

WV Department of
Environmental Protection

06/16/2023