
11/13/23, 10:40 AM Capture.PNG



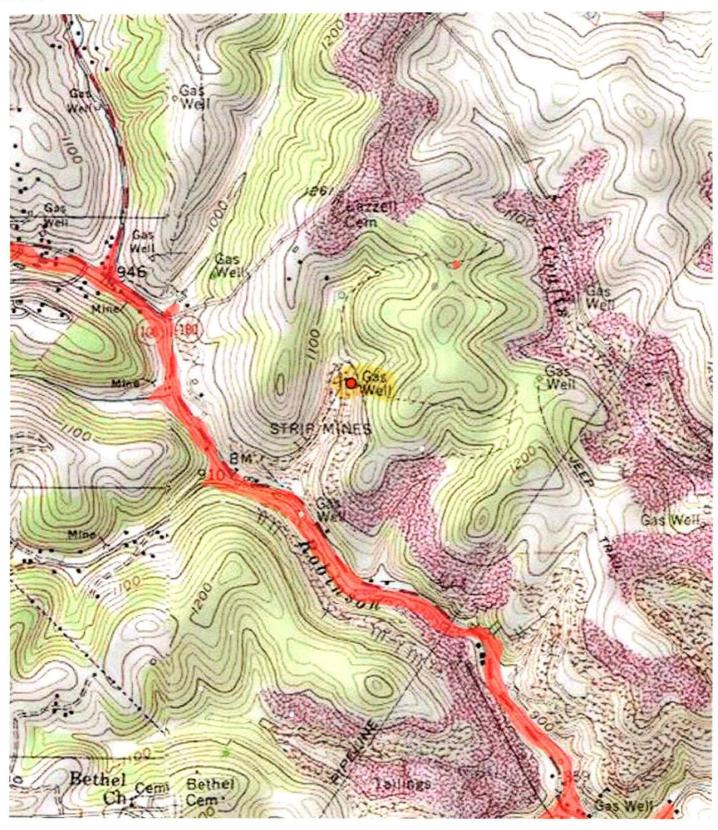

West Virginia Department of Environmental Protection Office of Oil and Gas

WELL LOCATION FORM: GPS

_{арі:} 4706101943	WELL NO.:	Heller 1
FARM NAME: Rick Heller		
RESPONSIBLE PARTY NAME: DEP Paid Plugging Contract		
COUNTY: Monongalia	DISTRICT: Ca	388
OUADRANGLE: Morgantown North		
SURFACE OWNER: Heller, Geoffrey R. Jr. & Kimberly A.		
ROYALTY OWNER: Richard A. Pultorak & Carol S.		
UTM GPS NORTHING: 5 86 416		
UTM GPS EASTING: 43 94 394	GPS ELEVAT	_{TON:} 1053'
The Responsible Party named above has che preparing a new well location plat for a plugabove well. The Office of Oil and Gas will the following requirements: 1. Datum: NAD 1983, Zone: 17 Not height above mean sea level (MS 2. Accuracy to Datum – 3.05 meters 3. Data Collection Method: Survey grade GPS: Post Processed	gging permit or assigned a not accept GPS coordinat orth, Coordinate Units: ma SL) – meters.	API number on the les that do not meet
Real-Time Di		
Mapping Grade GPS X: Post Processed Differential		
Real-Time Differential		
4. Letter size copy of the topogra I the undersigned, hereby certify this data is belief and shows all the information require prescribed by the Office of Oil and Gas.	s correct to the best of my	knowledge and
Bryan Harris		Oct 20, 2023
Signature	Title	Date