

LATITUDE 39°42'30"

80°22'08"

LONGITUDE

7.5'

7.5 OGIS topo location

7.5' loc 2.705
1.23 w

15' loc 4.585
(calc.) 3.45 w

Company _____

Farm _____

Quad HUNDREN (Mannington NC)


County Monongahela

District Battelle

WELL LOCATION MAP

File No. 061-143A

Plot showing location of well No. 5 of the Martin Oil and
 Gas Co. of Fairmont, W. Va. Abandoned, on the A. W. Wheeler
 Farm, consisting of 116.66 acres, situated in Hottel's District,
 Mingo County, West Virginia.

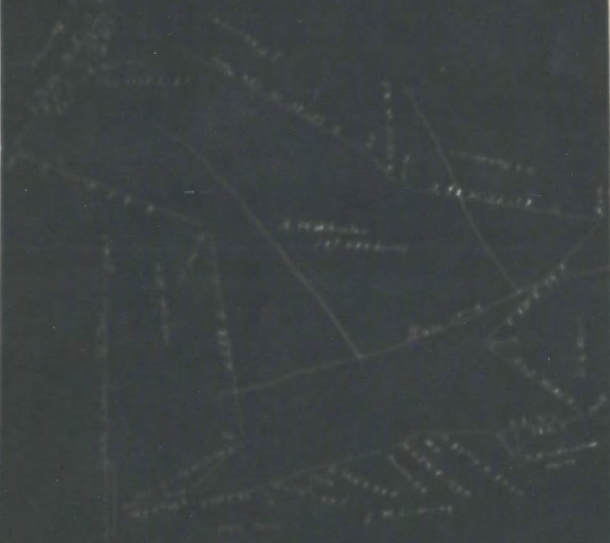

This map was prepared by the writer for the Martin Oil and Gas Co.
 in the month of December, 1910, and the information furnished
 by the owner is believed to be correct.

J. M. [Name] Surveyor

**AFFIDAVIT IN TRIPLICATE TO TIME AND MANNER OF
PLUGGING AND FILLING WELL.**
ENACTED BY SENATE S. 600 AND HOUSE H. 6000 ON 12-15-1920
WEST VIRGINIA DEPARTMENT OF MINES
OIL AND GAS DIVISION

Barth, Joseph, Shepherd et al.

Wester Oil and Gas Co.

67 Scripps 7700
Beckham, W. Va.

Box 212, Fairmont, W. Va.

Oil, Gas or Steam

Well and Location

Beckham State

Franklin County

A. F. Bishop

Vol No. 2

Beckham, W. Va.

A. F. Bishop Sworn

THE STATE OF WEST VIRGINIA VS THE STATE OF NEW YORK

AFFIDAVIT

STATE OF WEST VIRGINIA,
 County of Beckham)

Barth, Joseph, Shepherd et al. vs. Wester Oil and Gas Co.
 That the said well known to be open and on the day of February 11, 1921 of the State of West Virginia was owned by Wester Oil and Gas Co. of Beckham, West Virginia and that the said well was plugged and filled on the day of February 11, 1921, at the place of the said well, and that the well was plugged and filled in the manner and to the effect of the following to-wit:

That a check and receipted 212 funds received to be plugged were plugged and sealed as required to the West Virginia Division to and made a part of the Office of Inspection to plug and seal said well, dated May 2, 1920, on file in your office. Your check to plug said funds bearing date May 14, 1920, to which reference is here made.

That a check and receipted. In accordance with the above West Virginia.

Receipt of amount. In accordance with Rule 10, Regulations.

That the well of plugging and filling said well was completed on the day of February 11, 1921 at Beckham, West Virginia

Subscribed and sworn to before me this 14 day of February, 1921.

[Handwritten Signature]



PROPOSED MANNER OF PLUGGING AND FILLING WELL

(Division of Mines and Metallurgy)

WEST VIRGINIA DEPARTMENT OF MINES

OIL AND GAS DIVISION

WORK ORDER

Well to be plugged and filled as follows:

Fill with clay from bottom, 3222, to 3177.
Drive wood plug 3177 to 3174 (Top Thirty Foot Sand)
Cement from 3174 to 3164, sealing Thirty Foot Sand.
Fill with clay from 3164 to 3136.
Drive wood plug, 3136 to 3135 (Top of Fifty Foot Sand).
Cement from 3135 to 3125, sealing Fifty Foot Sand.
Set permanent bridge at 2685, using cement at top of bridge.
Fill with clay from 2685 to 2420, 30 feet above Big Injun Sand.
Drive wood plug from 2420 to 2417.
Cement from 2417 to 2407, sealing Big Injun.
Fill with clay from 2407 to 2398, 8 feet below 6 3/8" casing.
Pull 6 3/8" casing.
Set permanent bridge at 2130, using cement at top of bridge.
Fill with clay from 2130 to 1955, 20 feet above Salt Sands.
Drive wood plug from 1955 to 1923.
Cement from 1923 to 1942, sealing Salt Sands.
Fill with clay from 1942 to 1822.
Drive wood plug from 1822 to 1822.
Cement from 1822 to 1812.
Set permanent bridge at 1270.
Fill with clay from 1270 to 1180, 30 feet below Pittsburgh Coal.
Cement from 1180 to 1125, 20 feet above Pittsburgh Coal.
Fill with clay from 1125 to 250, 10 feet below 10" casing.
Drive wood plug from 250 to 247.
Pull 10" casing and fill with clay to surface.
Erect Marker as prescribed by Rule 12.

To the Department of Mines,
Oil and Gas Division,
Lanes or Property Office.

Gentlemen:

This "work order" is submitted for your approval and concurrence and copies notified of your disapproval or non-concurrence, the undersigned will proceed with the plugging and filling of said well in the above described manner on the date stated in the notice of intention to plug and abandon the said well on opposite side of this sheet.

Very truly yours,

Walter Oil and Gas Company

By W. E. Jones, W. E. Jones

No objections have been filed by the said owner or coal operator, or any available adjacent land or property owner or interested by the Department of Mines to the manner herein described for the plugging and filling of the well above mentioned. Therefore, the same is hereby approved this _____ day

of _____, 1924

DEPARTMENT OF MINES
Oil and Gas Division

Dept. Of Mines.

Charleston, W. Va. 'Vr. Kent.

Gentlemen:

Please give us the most liberal work order for plugging and abandoning the following well:

A. W. Whicker, well No. 8.
Location, Battell Dist., Maccungalia Co.
Owner, Weston Oil and Gas Co.
Contractor, S. W. Hull.
Completed, July 22, 1907.

Record.

Pit to Seal	1140-1170
Little Buzzard	1270-1270
Big "	1215-1220
Gas Sand	170-190
1st Salt Sand	1970-2000
2nd "	2070-2170
3rd "	2170-2200
" (1)	2100-2100
Big Sand	2200-2200
" (2)	2100-2200
50 feet Sand	2170-2170
Thirty feet "	2170-2170
" "	2100-2100
" and oil	2200-2200
" Oil	2210-2210
Total reduced at	2100
Total depth.	2100

Summ 2100.6 2/3

casing:

1 1/2"	500
2"	100
3 1/2"	2000 (Redwood)

Also please advise us as to the necessity for action to the coal owner regarding abandonment of a well when there is no nearby coal workings. In this case there is no coal within 50 to 60 miles of the well to be plugged. Yours are the coal was sold to Wm. Dick & Co. Harry. Much of it has been forfeited to the State. When not forfeited, it has been switched around to different owners and trustees until it is difficult to determine who is the present owner. Under such circumstances, need to give notice him to the coal owner. We are inclined to think the statute (as to notice) only applies when the well to be plugged is near some coal operation. Are we right as to this?

Also find enclosed a record of the well drilled on the S.V. Haffan heirs, Church Dist., Putnam Co., under permit recently issued by your Dept.

Very truly yours,
Weston Oil and Gas Co.,

This is a copy of the original record of the well drilled on the S.V. Haffan heirs, Church Dist., Putnam Co., under permit recently issued by your Dept.

