


LATITUDE 39° 42' 45"

390 40'

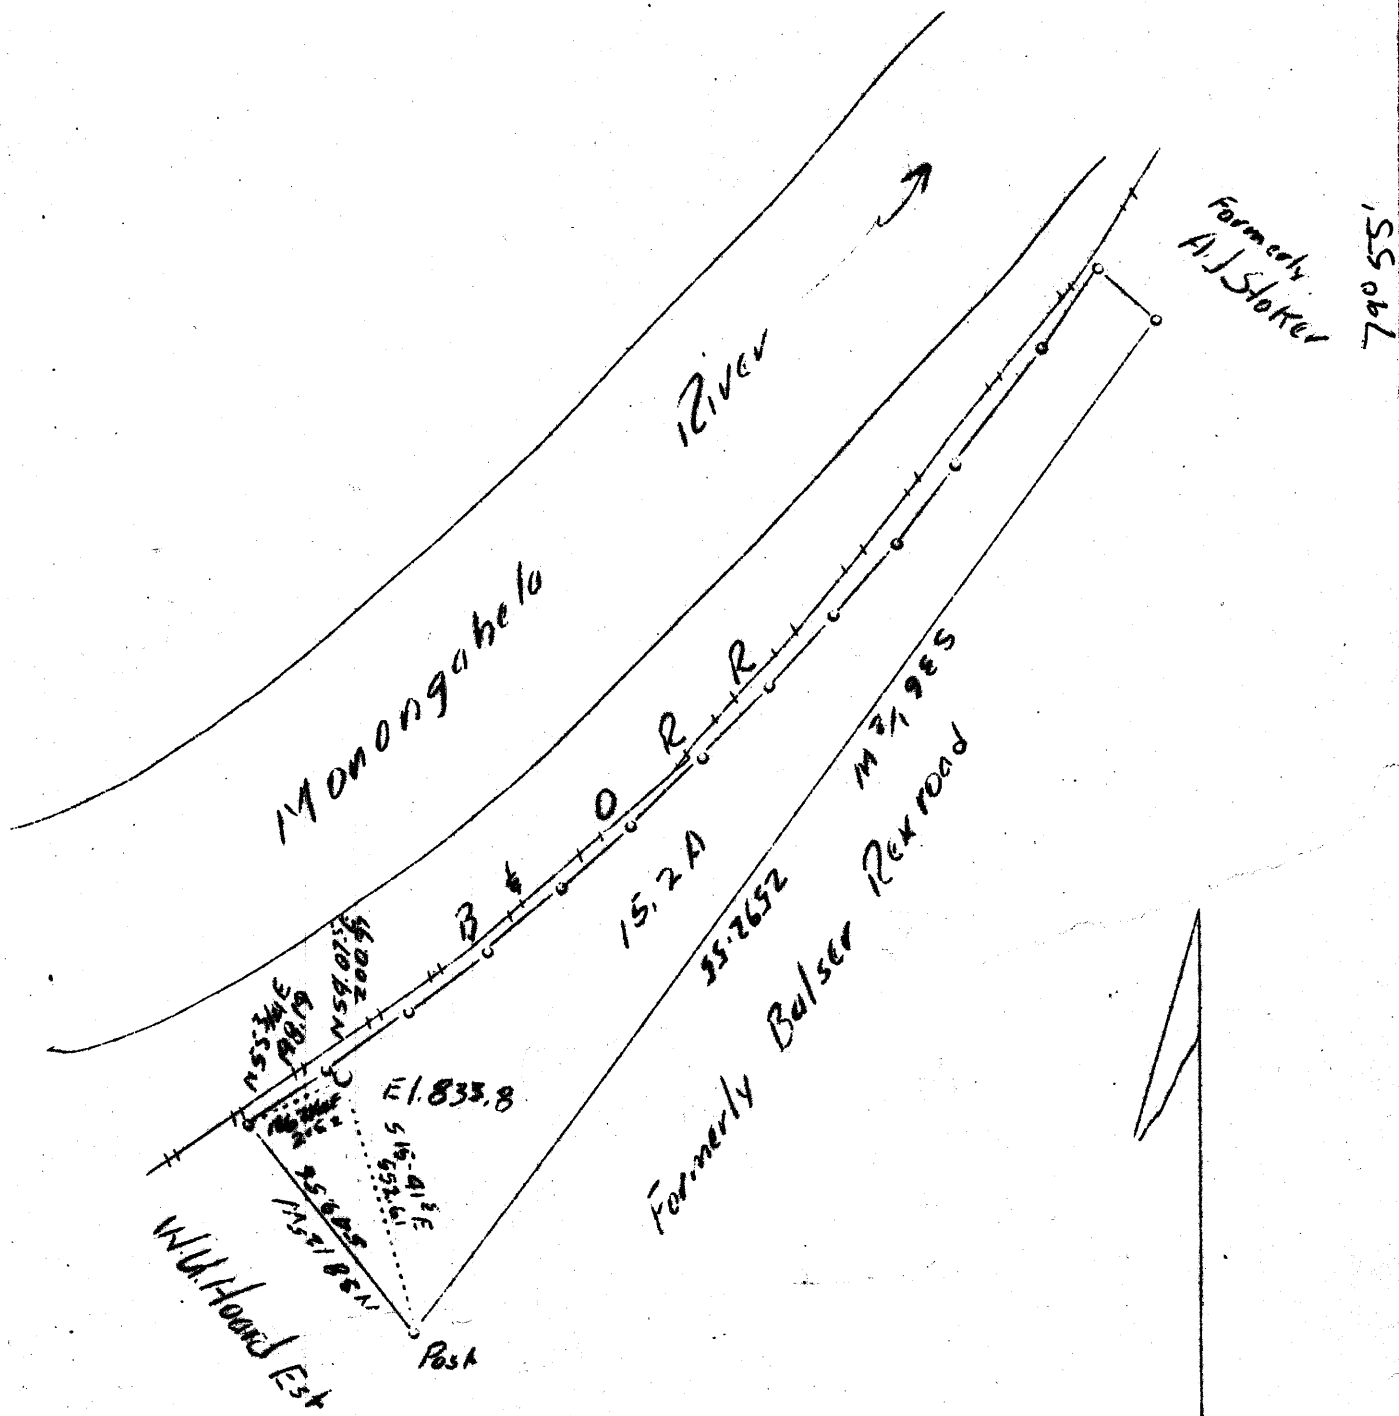

No log. 3.2 N 73 39 40'
0.3 W 79 55'

Abd.

MgTn N Quad?

Company	L. J. Houze Convex Glass Co.
Address	Point Marion, Pa.
Farm	Loverina Johnson
Tract 1	Acres 15.2 Lease No.
Well (Farm) No. 1	Serial No. 122724
Elevation (Spirit Level)	833.8
Quadrangle	Morgantown <i>MC</i>
County	Monongalia District Union
Engineer	James M. Cabbage
Engineer's Registration No.	3158 PA.
File No.	Drawing No. 161
Date	Aug. 18, 1937 Scale 1"=400'

STATE OF WEST VIRGINIA
Department of Mines
OIL AND GAS DIVISION
CHARLESTON

WELL LOCATION MAP

File No. MON-162A

+ Denotes location of well on United States Topographic Maps, scale 1 to 62,500, latitude and longitude lines being represented by border lines as shown.

- Denotes one inch spaces on border line of original tracing.