


LATITUDE 39° 40'

LONGITUDE 80° 10'

Asa Tennant
Hrs

J. Neeley

3.635

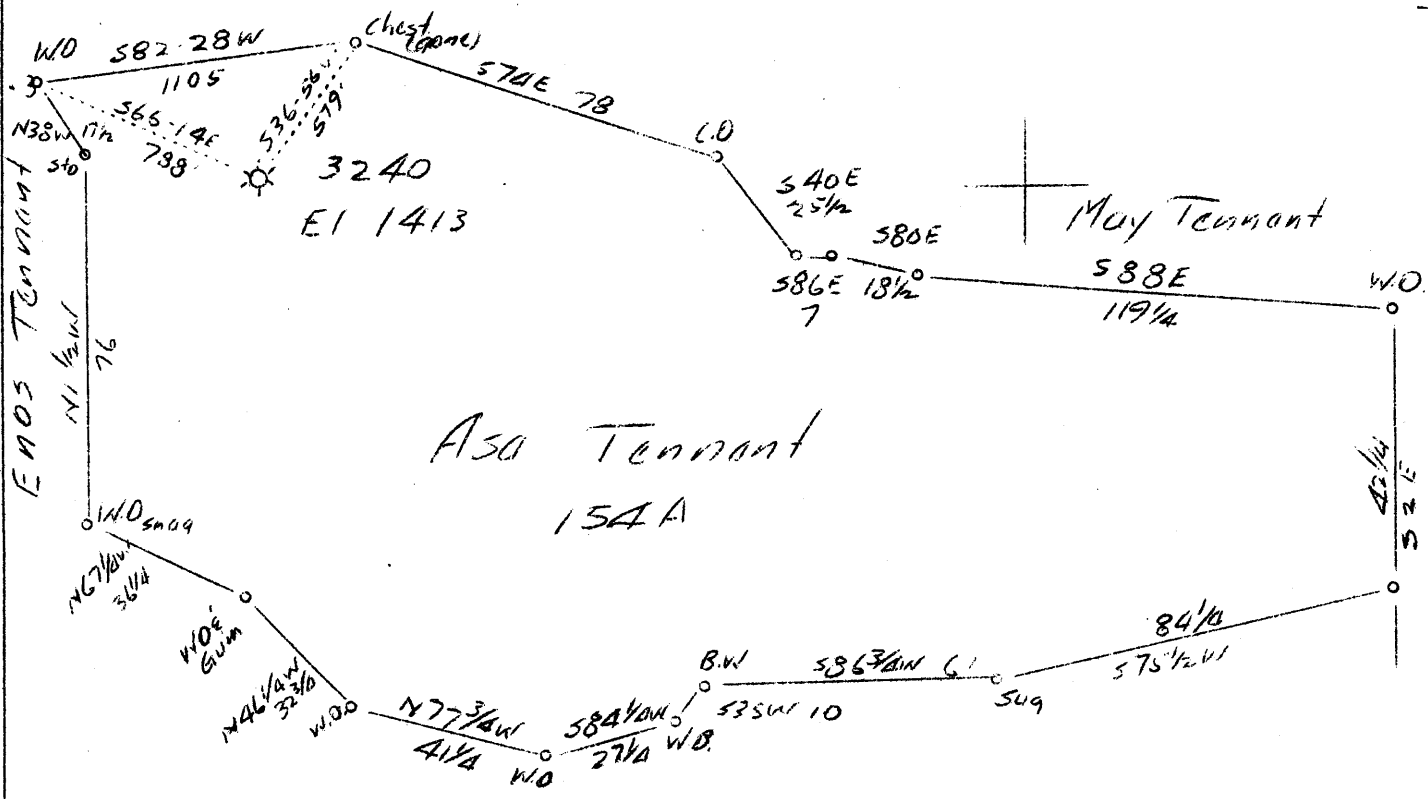

J.R. Rice

Jas. Eddy

3.645
2.18W

2.22 W.
3.7 S.

Abd

BK 652 Pg 14

Company	Hope Natural Gas Co.
Address	Clarksburg, W.Va.
Farm	Asa Tennant
Tract	1 Acres 154 Leasc No. 4597
Well (Farm) No.	1 Serial No. 3240
Elevation (Spirit Level)	1413
Quadrangle	Blacksville (N6)
County	Monongalia District Clay
Engineer	J.W. Clark
Engineer's Registration No.	744
File No.	L wing No.
Date	Sept 29, 1937 Scale 1"-40 Poles

STATE OF WEST VIRGINIA
Department of Mines
OIL AND GAS DIVISION
CHARLESTON

WELL LOCATION MAP
File No. MON-164AA

+ Denotes location of well on United States Topographic Maps, scale 1 to 62,500, latitude and longitude lines being represented by border lines as shown.

— Denotes one inch spaces on border line of original tracing.

Asa Tennant 20.1 (3240)