


LATITUDE 39° 45'

LONGITUDE 80° 05'

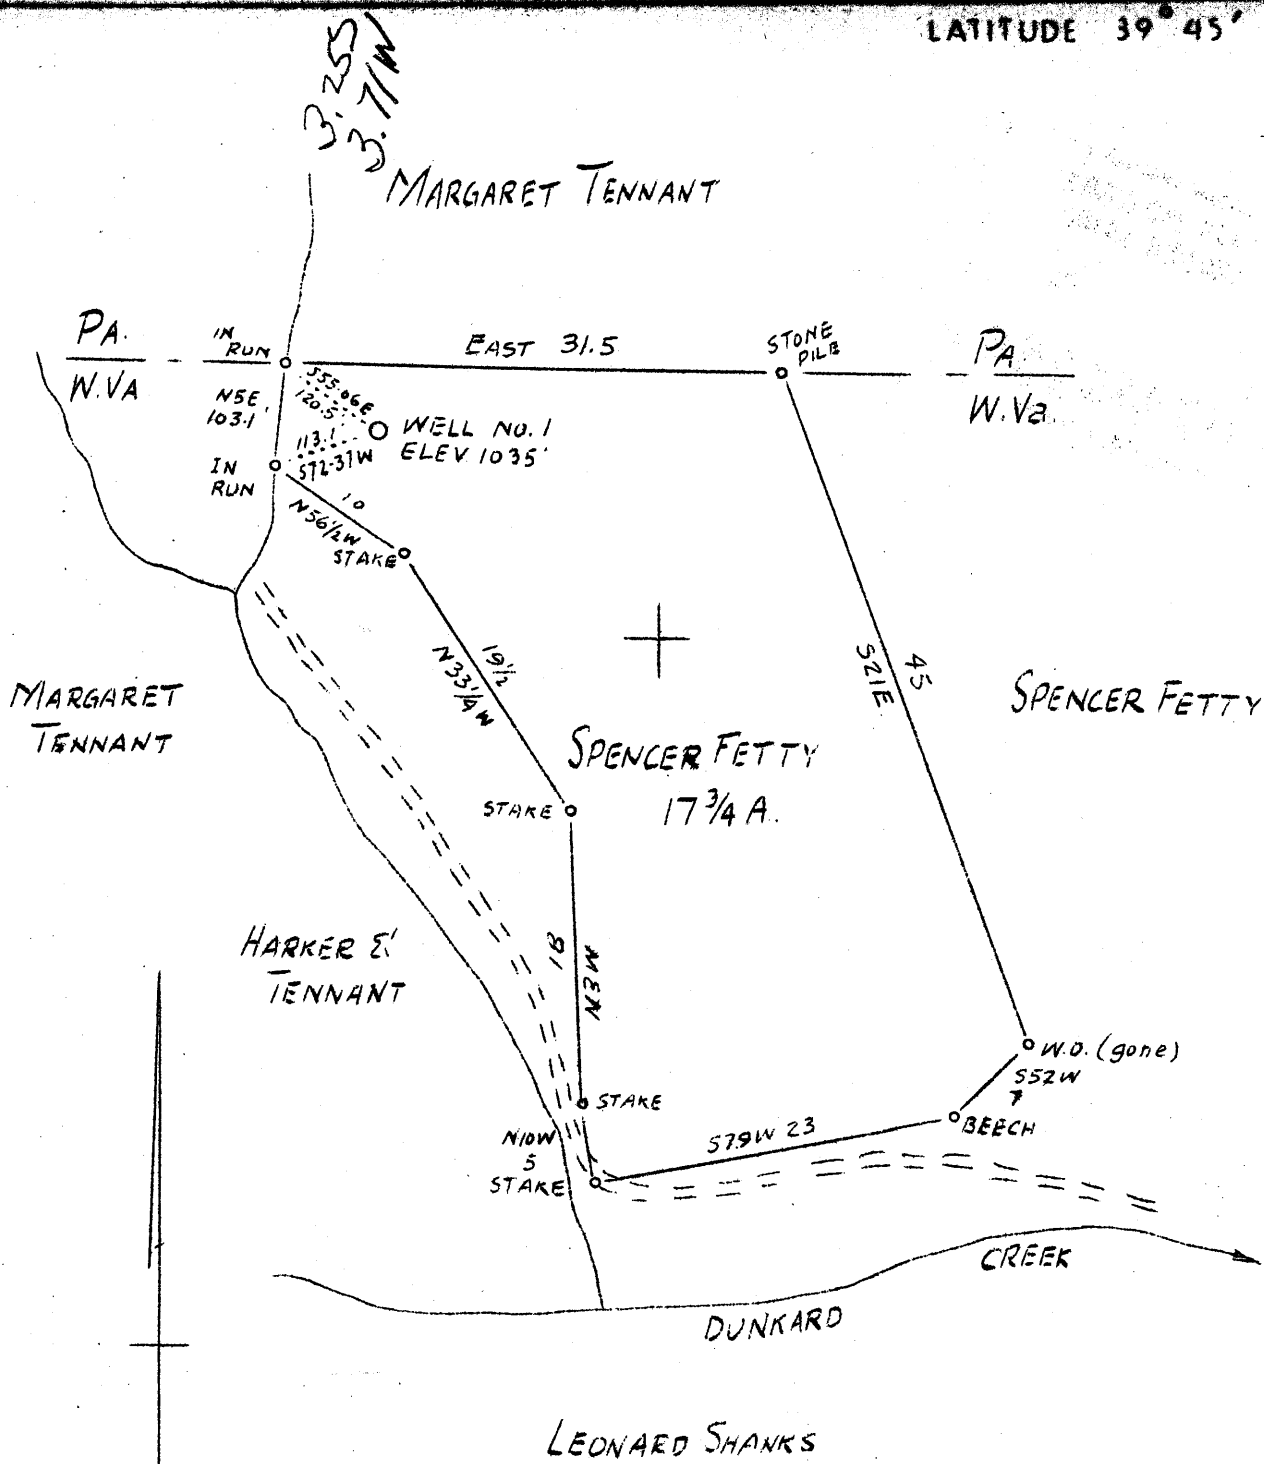

GOAL NOT OPERATED

3.25S
3.72W

3.3 S
3.8 W

ABANDONMENT

Company	John Conklin
Address	Jaynesburg, Pa.
Farm	Spencer Fetty
Tract	one
Acres	17 3/4
Well (Farm) No.	one
Elev. (Spirit Level)	1035'
Quadrangle	Blacksville N.C.
County	Monongalia
District	Clay
Eng.	A. L. Headley
Date	7-27-1938
Scale	1" = 200 ft.

STATE OF WEST VIRGINIA
Department of Mines
OIL AND GAS DIVISION
Charleston

WELL LOCATION MAP

File No. 170N-186A

x Denotes location of well on U. S. Topographic Maps, scale 1 to 62,500, latitude and longitude lines being represented by border lines as shown.

- Denotes one inch spaces on border line of original tracing.