


LATITUDE 39° 45'

LONGITUDE 79° 55'

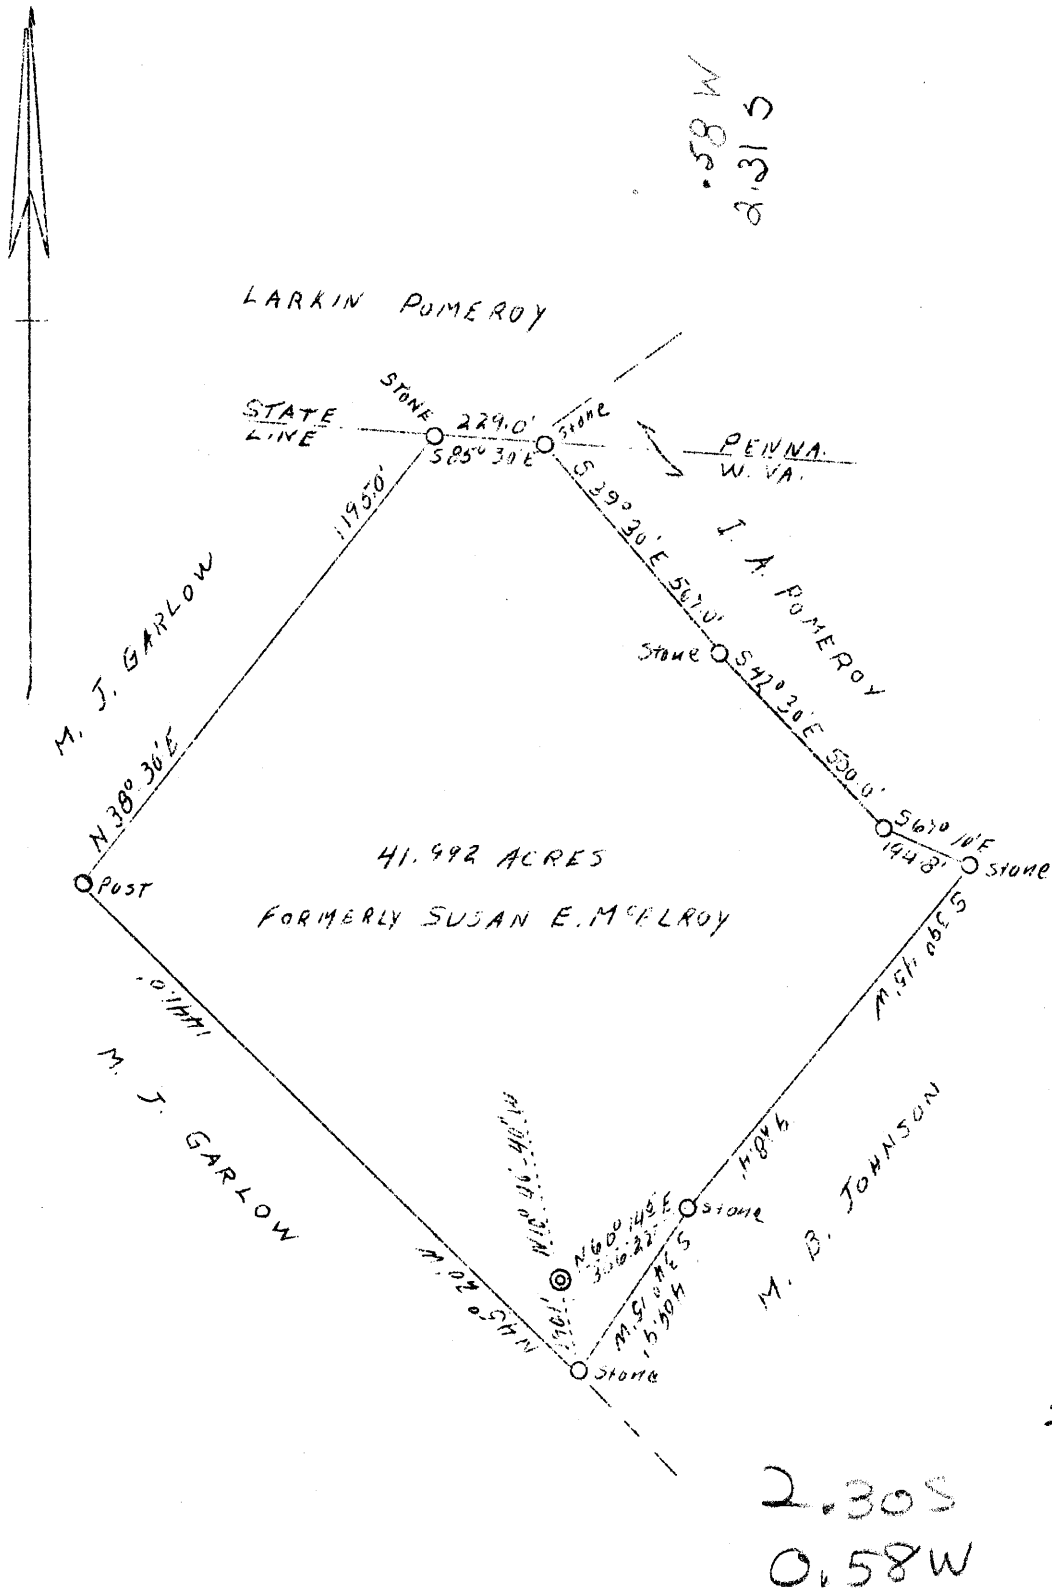

ABD.

Company	L. J. Houze Convex Glass Co.
Address	Point Marion, Pa.
Farm	M. J. Garlow
Tract	One
Acres	41-992
Well (Farm) No.	51822
Elevation (SP)	981.5
Quadrangle	Morgantown <i>N.W.</i>
County	Monongalia
District	Cass
Engineer	James M. Cabbage
Eng. Reg. No.	1358 Pa.
Drawing No.	105
Date	Oct. 26, 1938
Scale	1" = 400'

STATE OF WEST VIRGINIA
 Department of Mines
 OIL & GAS DIVISION
 Charleston

WELL LOCATION MAP
 File No. MON-189-A

x Denotes location of well on U. S. Topographic Maps, scale 1 to 62,500, latitude and longitude lines being represented by border lines as shown.

- Denotes one inch spaces on border line of original tracing.