

#25 on 1912 Co. Repd

- New Location
- Drill Deeper
- Abandonment

SEP 29 1941

Map Sheet 17 - Square N17E18 - F.B. 707 P. 26-27

Company	<u>Hope Natural Gas Co.</u>
Address	<u>Clarksburg, W. Va.</u>
Farm	<u>L. C. Shriver</u>
Tract	Acres <u>114 7/8</u> Lease No. <u>676</u>
Well (Farm) No.	<u>1</u> Serial No. <u>211</u>
Elevation (Spirit Level)	<u>1283</u>
Quadrangle	<u>N. Mannington</u> <small>Wackerstown 7 1/2</small>
County	<u>Monongalia</u> District <u>Battelle</u>
Engineer	<u>Wm. B. Bowers</u>
Engineer's Registration No.	<u>900</u>
File No.	Drawing No.
Date	<u>Sept. 9, 1941</u> Scale <u>1" = 40 P</u>

STATE OF WEST VIRGINIA
 DEPARTMENT OF MINES
 OIL AND GAS DIVISION
 CHARLESTON

WELL LOCATION MAP
 FILE NO. MON-265A
 was 70153

+ Denotes location of well on United States Topographic Maps, scale 1 to 62,500, latitude and longitude lines being represented by border lines as shown.

- Denotes one inch spaces on border line of original tracing.

L.C. SHRIVER No. 1 (211) - HOPE NAT. GAS Co. - MON-265-1888

STATE OF WEST VIRGINIA
DEPARTMENT OF MINES
OIL AND GAS DIVISION

319

WELL RECORD

Permit No. 765-A

Oil or Gas Well Gas
(KIND)


Company Hope Natural Gas Company
 Address Clarksburg, W. Va.
 Farm L. C. Shriver Acres 114-7/8
 Location (waters) 211
 Well No. 211 Elev. 1283
 District Battelle County Monongalia
 The surface of tract is owned in fee by Leo Shriver
 Address Breckenridge, Mich.
 Mineral rights are owned by _____
 Address _____
 Drilling commenced 3-8-1900
 Drilling completed 5-21-1900
 Date shot 12-6-1919 Depth of shot 5th sand
 Open Flow /10ths Water in _____ Inch
 /10ths Merc. in _____ Inch
 Volume _____ Cu. Ft.
 Rock Pressure _____ lbs. _____ hrs.
 Oil _____ bbls., 1st 24 hrs.
 Fresh water None recorded feet _____ feet
 Salt water None recorded feet _____ feet

Casing and Tubing	Used in Drilling	Left in Well	Packers
Size			
16			Kind of Packer
13			
10	175	Pulled	Size of
8 1/4	1510	Pulled	
6 5/8	2248	2248	Depth set
5 3/16	2528	2528	
3			Perf. top
2	3492	Pulled	Perf. bottom
Liners Used			Perf. top
			Perf. bottom

CASING CEMENTED _____ SIZE _____ No. Ft. _____ Date
Not cemented

COAL WAS ENCOUNTERED AT 1038 FEET ? INCHES
 _____ FEET _____ INCHES FEET _____ INCHES
 _____ FEET _____ INCHES FEET _____ INCHES

Formation	Color	Hard or Soft	Top	Bottom	Oil, Gas or Water	Depth Found	Remarks
Pittsburgh Coal			1038	Est. 1043			
Big Injun Sand			2305	2485			
Fifty Foot Sand			2996	3050			
Gordon Stray Sand			3200	3215			
Gordon Sand			3250		Gas	3294	
Fourth Sand			3327				
Fifth Sand			3425	3429	Gas	3426	
Total Depth			3492				

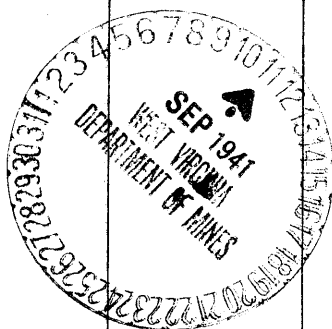

Formation	Color	Hard or Soft	Top	Bottom	Oil, Gas or Water	Depth Found	Remarks

Date September 10, 1941, 194

APPROVED Hope Natural Gas Company, Owner

By W. Reed General Supt.

(Title)