

New Location
 Drill Deeper
 Abandonment

✓ JUN - 1 1942

N12E16 Map N72E

Company South Penn Natural Gas Co.
 Address Parkersburg, W. Va.
 Farm Wm. A. Yost
 Tract _____ Acres 88 Lease No. 15910
 Well (Farm) No. 4 Serial No. _____
 Elevation (Spirit Level) 1487.00
 Quadrangle Mannington
 County Monongalia Distric. Battelle
 Engineer E.C. Tabler
 Engineer's Registration No. _____
 File No. _____ Drawing No. _____
 Date Apr. 29, 1942 Scale 1" = 400'

STATE OF WEST VIRGINIA
 DEPARTMENT OF MINES
 OIL AND GAS DIVISION
 CHARLESTON

WELL LOCATION MAP
 FILE NO. MON-276-A

+ Denotes location of well on United States Topographic Maps, scale 1 to 62,500, latitude and longitude lines being represented by border lines as shown.

- Denotes one inch spaces on border line of original tracing.

WM. A. YOST No. A - SOUTH PENN NAT. GAS CO. - MON-276-A

STATE OF WEST VIRGINIA
DEPARTMENT OF MINES
OIL AND GAS DIVISION

330

WELL RECORD

Permit No.

Oil or Gas Well **OIL**
(KIND)

Company **South Penn Natural Gas Company**
 Address **Union Trust Bldg. Parkersburg, W. Va.**
 Farm **Wm. A. Yost** Acres **88**
 Location (waters) **Dunkard Creek**
 Well No. **Battelle** Elev. **1487.**
 District **Monongalia** County **Monongalia**
 The surface of tract is owned in fee by **Elihu Yost,**
 Address **Wadestown, W. Va.**
 Mineral rights are owned by **Darka Estel et al**
 Address **Wadestown, W. Va.**
 Drilling commenced **April 11, 1907,**
 Drilling completed **June 27, 1907**
 Date Shot **See below xxx** From **xxx** To **xxx**
 With **-----**
 Open Flow /10ths Water in **---** Inch
 /10ths Merc. in **---** Inch
 Volume **---** Cu. Ft.
 Rock Pressure **7** lbs. **---** hrs.
 Oil **---** bbls., 1st 24 hrs.
 Fresh water **---** feet **---** feet
 Salt water **---** feet **---** feet


Casing and Tubing	Used in Drilling	Left in Well	Packers
Size			Kind of Packer
16			---
13			---
10	260'		Size of
8 1/4	1740'		---
6 5/8	2561'		Depth set
5 3/16	2711'		---
3			Perf. top
2 1/2 X 4	227' 9"		Perf. bottom
Liners Used			Perf. top
Cond.	16'		Perf. bottom

CASING CEMENTED **---** SIZE **---** No. Ft. **---** Date **---**
 COAL WAS ENCOUNTERED AT **1197** FEET **72?** INCHES
1298 FEET **84?** INCHES **---** FEET **---** INCHES
--- FEET **---** INCHES **---** FEET **---** INCHES

Formation	Color	Hard or Soft	Top	Bottom	Oil, Gas or Water	Depth Found	Remarks
Mapletown Coal			1197	1203?			
Pittsburgh Coal			1298	1305?			
Big Dunkard Sand			1900	-			
Gas Sand			1950	2100			
Salt Sand			2190	2300			
Big Lime			2530	2590			
Big Injun Sand			2590	2760			
50 Foot Sand			3228	3280			
30 Foot Sand			3320	3335			
Stray Sand			3390	3405			
Campbells Run Sand			3459	3489			
Gordon Sand			3505	3522	Oil	3464	
4th Sand			3548		Oil	3551	
Total Depth				3565			

SHOT RECORD:

3-30-11 10 Qt. 4th Sand
 11-8-20 20 " "
 6-9-37 20 " 3549-63

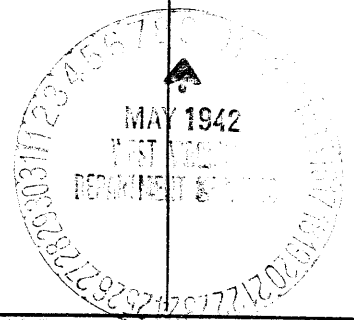

Formation	Color	Hard or Soft	Top	Bottom	Oil, Gas or Water	Depth Found	Remarks

Date **May 8, 1922**, 194 **2**

APPROVED **SOUTH PENN NATURAL GAS COMPANY**, Owner

By *Elton Spang* Land Agent
(Title)