


Latitude 39° 40'

Longitude 80° 05'

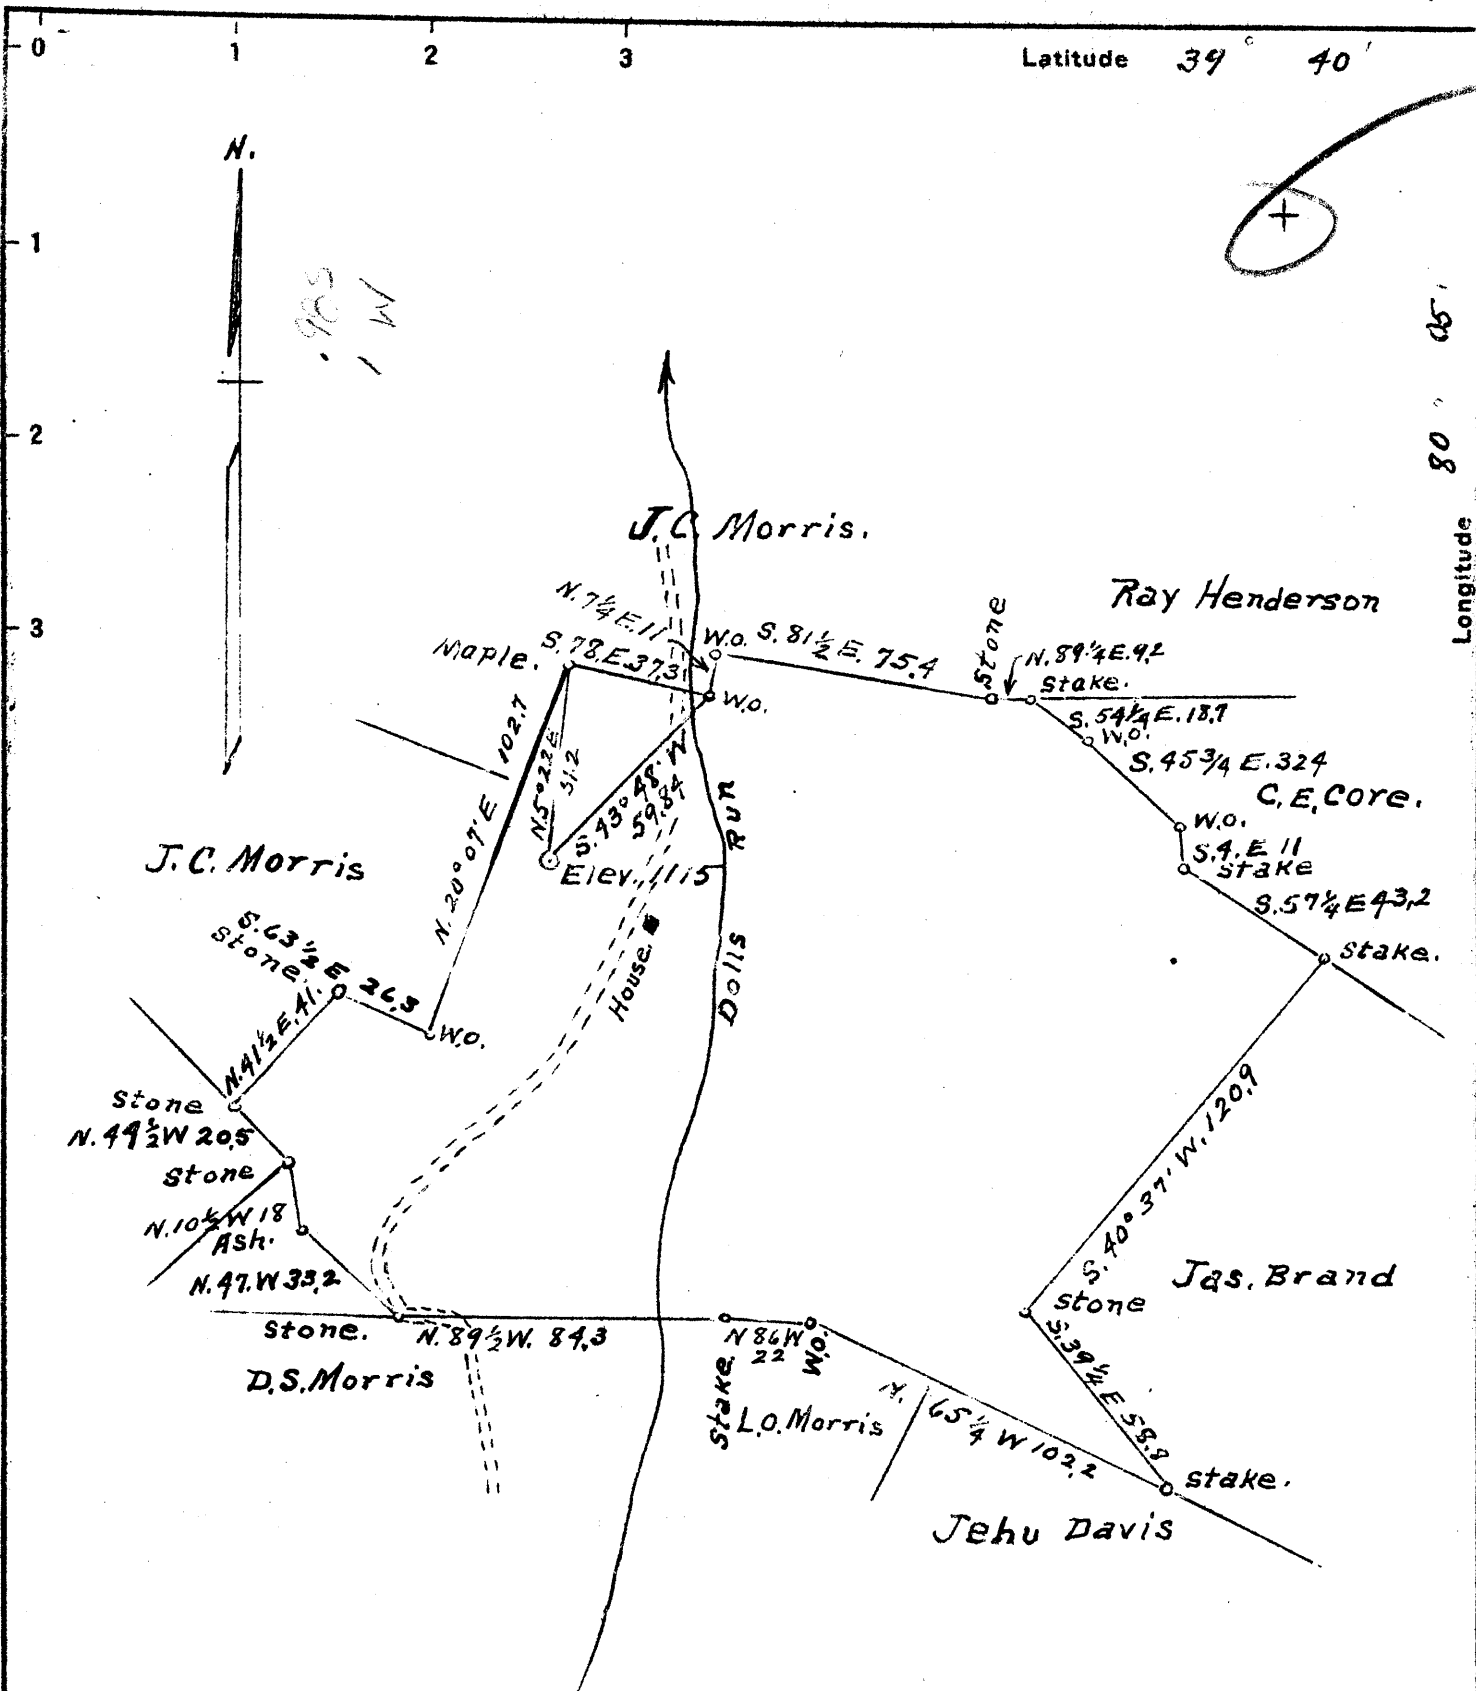

0.995
1.01W

New Location
 Drill Deeper
 Abandonment V

Company DUNN-MARR Oil & Gas Co.
 Address Waynesburg Pa.
 Farm C. G. Lemley
 Tract ONE Acres 215 Lease No. _____
 Well (Farm) No. ONE Serial No. _____
 Elevation (Spirit Level) 1115'
 Quadrangle Blacksville
 County Monongalia District Clay
 Engineer A. L. Headley
 Engineer's Registration No. _____
 File No. _____ Drawing No. _____
 Date 6-5-1942 Scale 1 in = 50 poles

STATE OF WEST VIRGINIA
 DEPARTMENT OF MINES
 OIL AND GAS DIVISION
 CHARLESTON

WELL LOCATION MAP
 FILE NO. MON-279-A

+ Denotes location of well on United States Topographic Maps, scale 1 to 62,500, latitude and longitude lines being represented by border lines as shown.

- Denotes one inch spaces on border line of original tracing.