

New Location   
 Drill Deeper   
 Abandonment

JUN 13 1943

0.83 W  
 0.73 P

Map N74E 66.4 P

Company South Penn Natural Gas Co.  
 Address Parkersburg, W. Va.  
 Farm Asa & Mahlon Tennant  
 Tract \_\_\_\_\_ Acres 40 Lease No. 12663  
 Well (Farm) No. 2 Serial No. \_\_\_\_\_  
 Elevation (Spirit Level) 1200<sup>12</sup> D.F. 1198<sup>12</sup> G  
 Quadrangle Blacksville  
 County Morgan District Clay  
 Engineer Emmon Haines  
 Engineer's Registration No. \_\_\_\_\_  
 File No. \_\_\_\_\_ Drawing No. \_\_\_\_\_  
 Date 3-18-43 Scale 1" = 400'

WC

STATE OF WEST VIRGINIA  
 DEPARTMENT OF MINES  
 OIL AND GAS DIVISION  
 CHARLESTON

WELL LOCATION MAP  
 FILE NO. MON-290-A

+ Denotes location of well on United States Topographic Maps, scale 1 to 62,500, latitude and longitude lines being represented by border lines as shown.

- Denotes one inch spaces on border line of original tracing

STATE OF WEST VIRGINIA  
DEPARTMENT OF MINES  
OIL AND GAS DIVISION

339

WELL RECORD

Permit No. 290-A

Oil or Gas Well: OIL  
(KIND)


Company: **South Penn Natural Gas Company,**  
 Address: **Union Trust Bldg. Parkersburg, W. Va.**  
 Farm: **Asa & Mahlon Tennant** Acres: **40**  
 Location (waters): **---**  
 Well No. **2** Elev. **1198.12**  
 District: **Clay** County: **Monongalia**  
 The surface of tract is owned in fee by: **Nelson Tennant**  
 R.D. No. **3**, Address: **Fairview, W. Va.**  
 Mineral rights are owned by: **Arzie Tennant et al**  
 Address: **Fairview, W. Va.**  
 Drilling commenced: **Oct. 4, 1894**  
 Drilling completed: **Nov. 23, 1894**  
 Date Shot: **8-22-10** From **---** To **---**  
 With **---**

Casing and Tubing	Used in Drilling	Left in Well	Packers
Size			
16			Kind of Packer: <b>---</b>
13			<b>---</b>
10	<b>690' (Pulled)</b>		Size of: <b>---</b>
8 1/4	<b>800'</b>		<b>---</b>
6 5/8	<b>1705'</b>		Depth set: <b>---</b>
5 3/16	<b>2000'</b>		<b>---</b>
3			Perf. top: <b>---</b>
2			Perf. bottom: <b>---</b>
Liners Used			Perf. top: <b>---</b>
			Perf. bottom: <b>---</b>

Open Flow: /10ths Water in **---** Inch  
 /10ths Merc. in **---** Inch  
 Volume: **---** Cu. Ft.  
 Rock Pressure: **---** lbs. **---** hrs.  
 Oil: **300** bbls., 1st 24 hrs.  
 Fresh water: **---** feet **---** feet  
 Salt water: **---** feet **---** feet

CASING CEMENTED: **---** SIZE **---** No. Ft. **---** Date **---**  
 COAL WAS ENCOUNTERED AT **680** FEET **96** INCHES  
**---** FEET **---** INCHES **---** FEET **---** INCHES  
**---** FEET **---** INCHES **---** FEET **---** INCHES

Formation	Color	Hard or Soft	Top	Bottom	Oil, Gas or Water	Depth Found	Remarks
<b>Pittsburgh Coal</b>			<b>680</b>	<b>688</b>			
<b>Top Big Injun</b>			<b>2000</b>				
					<b>1st Pay-Good</b>	<b>2078</b>	
					<b>2nd Pay-Good</b>	<b>2095</b>	
<b>Total Depth</b>				<b>2111</b>			

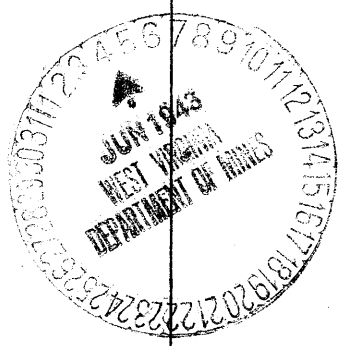

JUL 15 1943

