


Latitude

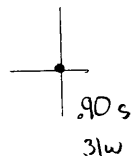

Longitude

Topo Location

7.5' Loc. _____ 15' Loc. _____
 _____ (calc.) _____

Company Hope Nat Gas Co

Farm RW Sime & LK Sime


15' Quad _____
(sec.)

7.5' Quad Blacksville

District Clay

WELL LOCATION PLAT

County Clay Permit 36297

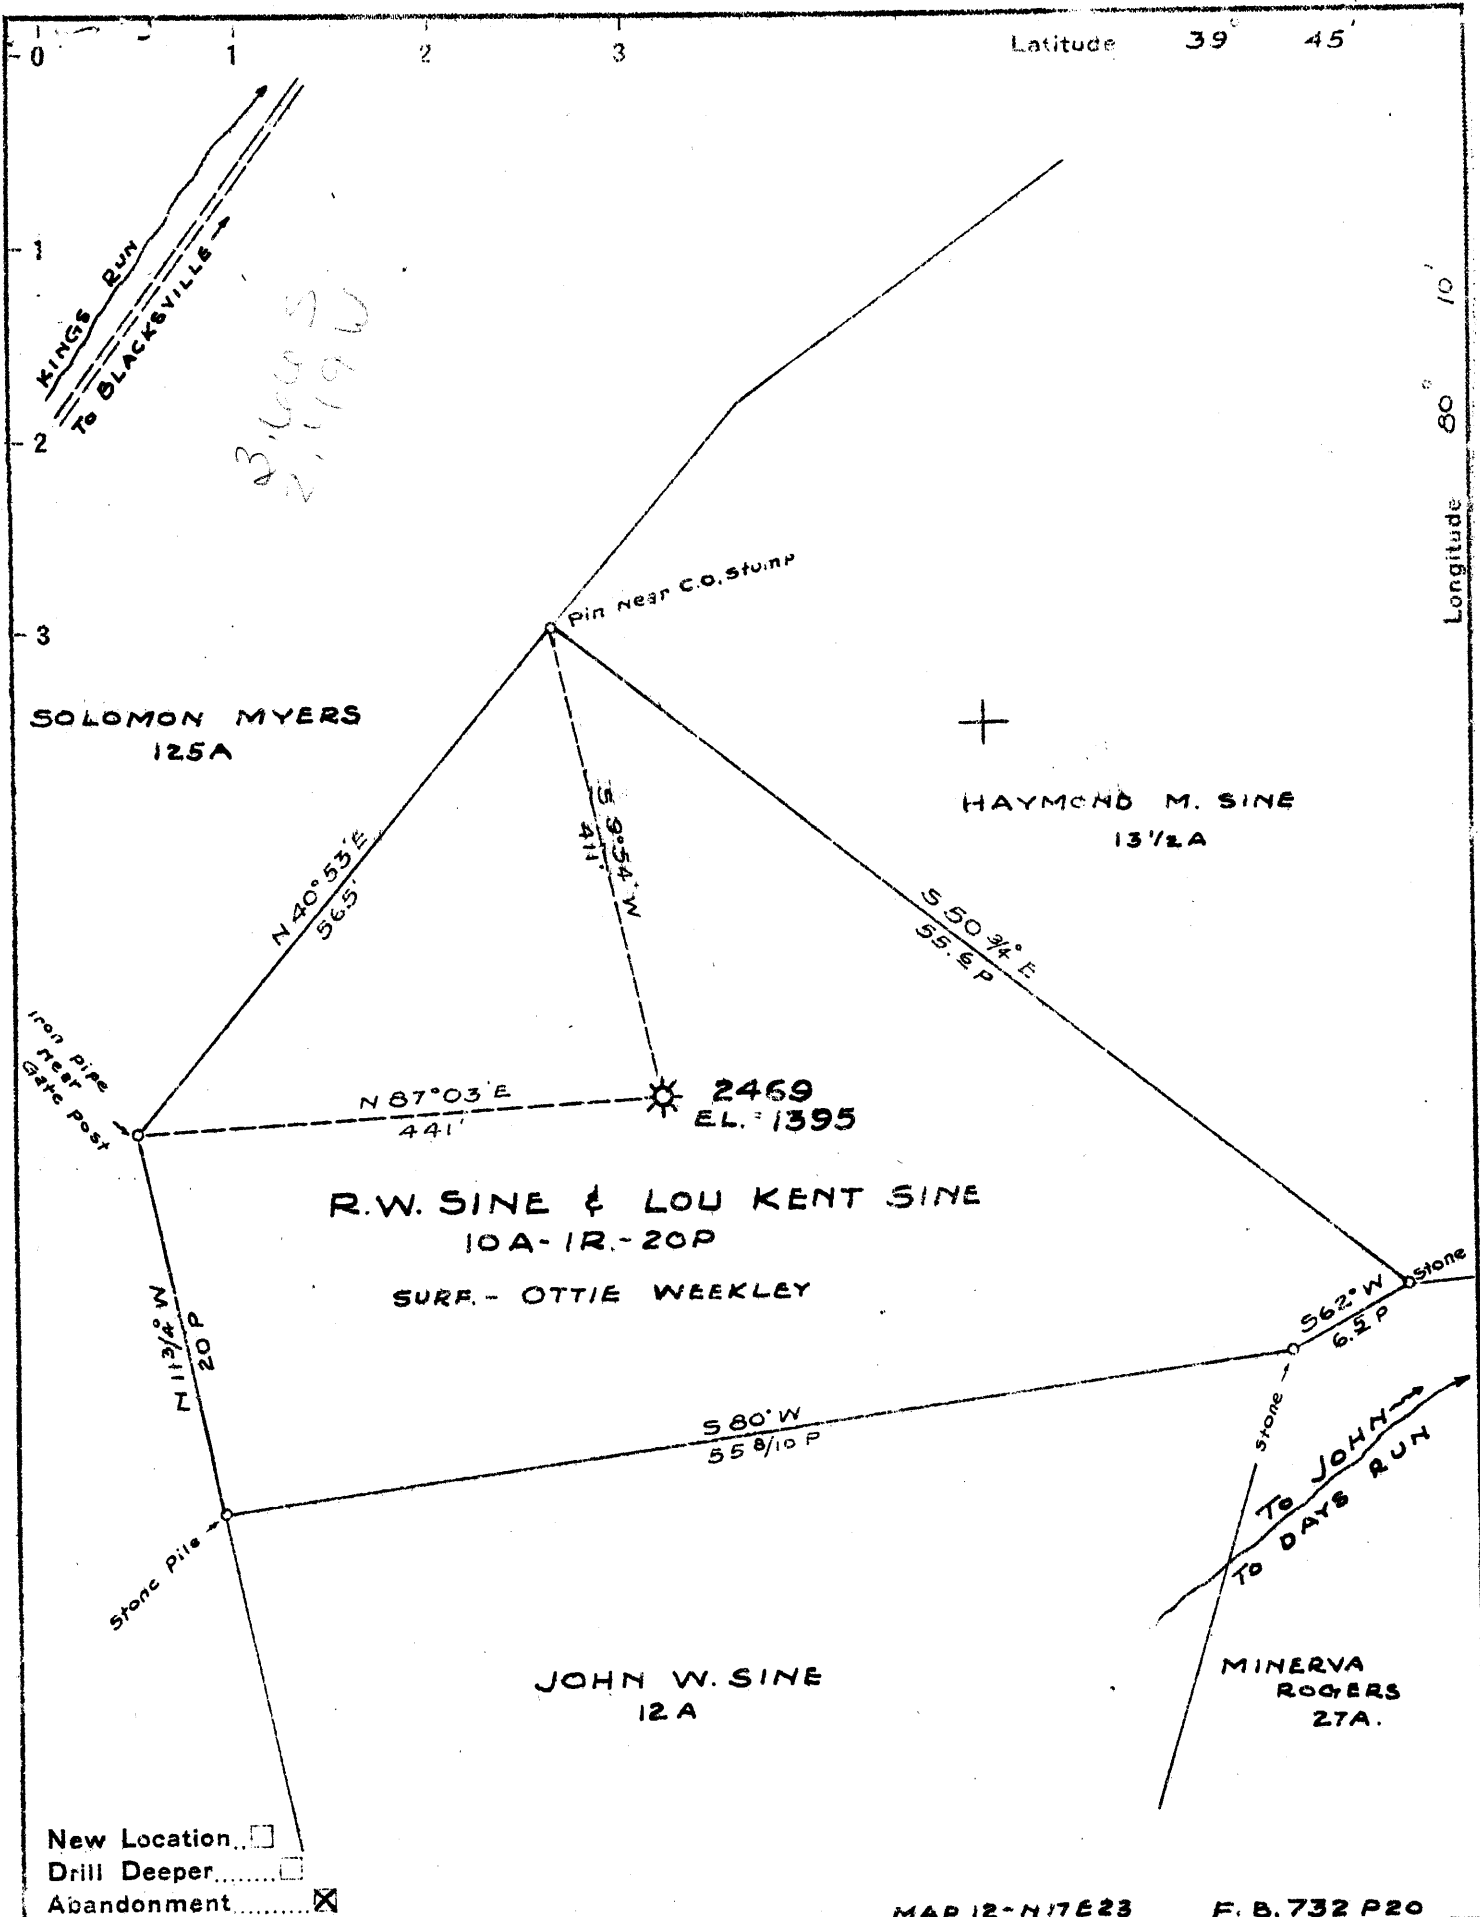

Company HOPE NATURAL GAS CO.
 Address CLARKSBURG, W. VA.
 Farm R.W. SINE & LOU KENT SINE
 Tract 1 Acres 11 Lease No. 8030
 Well (Farm) No. 1 Serial No. 2469
 Elevation (Spirit Level) 1395
 Quadrangle BLACKSVILLE
 County MONONGALIA District CLAY
 Engineer W. M. Bowler
 Engineer's Registration No. 900
 File No. _____ Drawing No. _____
 Date OCT. 20, 1943 Scale 1" = 10 FEET

STATE OF WEST VIRGINIA
 DEPARTMENT OF MINES
 OIL AND GAS DIVISION
 CHARLESTON

WELL LOCATION MAP
 FILE NO. MON-297-A

+ Denotes location of well on United States Topographic Maps, scale 1 to 62,500, latitude and longitude lines being represented by border lines as shown.

- Denotes one inch spaces on border line of original tracing.