

New Location   
 Drill Deeper   
 Abandonment

Company Dunn-Mar Oil & Gas. Co.  
 Address Waynesburg Pa.  
 Farm David B. Harker  
 Tract 037E Acres 200 Lease No. Hops  
 Well (Farm) No. 2 Serial No. 4635  
 Elevation (Spirit Level) 1360'  
 Quadrangle Mannington  
 County Monongalia District Pathe  
 Engineer A. L. Headley  
 Engineer's Registration No. 7  
 File No. \_\_\_\_\_ Drawing No. \_\_\_\_\_  
 Date 8-14-1945 Scale 1 in = 500 ft

STATE OF WEST VIRGINIA  
 DEPARTMENT OF MINES  
 OIL AND GAS DIVISION  
 CHARLESTON

**WELL LOCATION MAP**  
 FILE NO. MON-325-A

+ Denotes location of well on United States Topographic Maps, scale 1 to 62,500, latitude and longitude lines being represented by border lines as shown.

WEST VIRGINIA DEPARTMENT OF MINES  
OIL AND GAS DIVISION

373

WELL RECORD

Permit No. 325-A


Oil or Gas Well Gas  
(Kind)

Company Dunn-Mar Oil & Gas Co.  
 Address Waynesburg, Pa.  
 Farm D.B. Harker Acres 200  
 Location (waters) \_\_\_\_\_  
 Well No. 2 (11-1-135) Elev. 1360  
 District Mattelle County Monongalia  
 The surface of tract is owned in fee by D.B. Harker  
 Address Wana, W. Va.  
 Mineral rights are owned by \_\_\_\_\_  
 Address \_\_\_\_\_  
 Drilling commenced Dec 11 1916  
 Drilling completed Sept 6 1917  
 Date shot \_\_\_\_\_ Depth of shot \_\_\_\_\_  
 Open Flow /10ths Water in \_\_\_\_\_ Inch  
 /10ths Merc. in \_\_\_\_\_ Inch  
 Volume \_\_\_\_\_ Cu. Ft.  
 Rock Pressure \_\_\_\_\_ lbs. \_\_\_\_\_ hrs.  
 Oil \_\_\_\_\_ bbls., 1st 24 hrs.  
 Fresh water \_\_\_\_\_ feet \_\_\_\_\_ feet  
 Salt water \_\_\_\_\_ feet \_\_\_\_\_ feet

Casing and Tubing	Used in Drilling	Left in Well	Packers
Size			
16			Kind of Packer
13			
10	<u>1113</u>	<u>1113</u>	Size of
8 3/4	<u>1850</u>	<u>1850</u>	
6 5/8	<u>2308</u>	<u>2308</u>	Depth set
<del>5 1/2</del> <u>7/8</u>	<u>2501</u>	<u>2501</u>	
3			Perf. top
2			Perf. bottom
Liners Used			Perf. top
			Perf. bottom

CASING CEMENTED \_\_\_\_\_ SIZE \_\_\_\_\_ No. FT. \_\_\_\_\_ Date \_\_\_\_\_  
 COAL WAS ENCOUNTERED AT 1070-76 FEET \_\_\_\_\_ INCHES  
 \_\_\_\_\_ FEET \_\_\_\_\_ INCHES FEET \_\_\_\_\_ INCHES  
 \_\_\_\_\_ FEET \_\_\_\_\_ INCHES FEET \_\_\_\_\_ INCHES

Formation	Color	Hard or Soft	Top	Bottom	Oil Gas or Water	Depth Found	Remarks
Pittsburgh Coal			1070	1076			
Dunkard sand			1450	1625			
Salt sand			1820	2085			
Maxon sand			2175	2195			
Big injun sand			2360	2592	Gas	2366	
<del>Hereon</del>	"						
Gantz	"		2855	2885			
Fifty Ft	"		3006	3055			
Thirty "	"		3075	3110			
Stray	"		3260	3275			
Gordon	"		3281	3302			
Fourth	"		3318	3402			
Fifth	"		3457	3465	Gas	3463	
Bayard	"		3494	3499	Gas	3595	
Total Depth				3514			

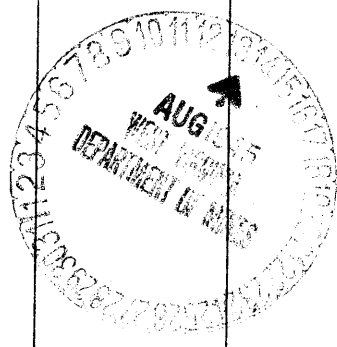

SEP 18 1945