

Surface: Harlan Fluharty; R.F.D. #1, Metz, W. Va.  
 Coal: State of West Virginia.

2.39S  
1.21W

2.37S

1.04W

N 12-13 E 15

- New Location
- Drill Deeper
- Abandonment

On App. mat 2457

JUN 22 1948

Company The Tri-State Pipe Co.  
 Address Bellaire, Ohio  
 Farm W. J. Devine  
 Tract \_\_\_\_\_ Acres 33 1/3 Lease No. \_\_\_\_\_  
 Well (Farm) No. 2 and 3 Serial No. \_\_\_\_\_  
 Elevation (Spirit Level) See above at wells  
 Quadrangle Mannington  
 County Monongalia District Battle  
 Engineer F. C. Tabler  
 Engineer's Registration No. \_\_\_\_\_  
 File No. \_\_\_\_\_ Drawing No. \_\_\_\_\_  
 Date May 25<sup>th</sup> 1948 Scale 1" = 400 Feet

STATE OF WEST VIRGINIA  
 DEPARTMENT OF MINES  
 OIL AND GAS DIVISION  
 CHARLESTON

WELL LOCATION MAP  
 FILE NO. MON-369-A

+ Denotes location of well on United States Topographic Maps, scale 1 to 62,500, latitude and longitude lines being represented by border lines as shown.

- Denotes one inch spaces on border line of original tracing.



STATE OF WEST VIRGINIA  
DEPARTMENT OF MINES  
OIL AND GAS DIVISION

407

WELL RECORD

Permit No. 369-A

Oil or Gas Well  
(KIND)


Company The Tri-State Pipe Company  
 Address Bellaire, Ohio  
 Farm W. J. Devine Acres 3 1/2  
 Location (waters).....  
 Well No. 3 Elev. 1742  
 District Battelle County Monongalia  
 The surface of tract is owned in fee by.....  
 Address.....  
 Mineral rights are owned by.....  
 Address.....  
 Drilling commenced.....  
 Drilling completed September 6, 1907  
 Date Shot From To  
 With.....  
 Open Flow /10ths Water in..... Inch  
 /10ths Merc. in..... Inch  
 Volume..... Cu. Ft.  
 Rock Pressure..... lbs..... hrs.  
 Oil..... bbls., 1st 24 hrs.  
 Fresh water..... feet..... feet  
 Salt water..... feet..... feet

Casing and Tubing	Used in Drilling	Left in Well	Packers
Size			Kind of Packer
16			
13			
10	320'	320'	Size of
8 1/4	1596'	1596'	
6 1/2	2337'	2337'	Depth set
5 3/16	2680'	2680'	
3			Perf. top
2	3529'	3529'	Perf. bottom
Liners Used			Perf. top
			Perf. bottom

CASING CEMENTED. No. SIZE No. Ft. Dat

COAL WAS ENCOUNTERED AT 1261 FEET 72 INCHES  
1160 FEET 48 INCHES FEET INCHES  
 FEET INCHES FEET INCHES

Formation	Color	Hard or Soft	Top	Bottom	Oil, Gas or Water	Depth Found	Remarks
Conductor				12'			
Mapletown Coal			1156'	1160'			
Pittsburgh Coal			1255'	1261'			
Little Dunkard			1585	1610			
Big Dunkard			1735	1760			
Gas Sand			1960	2030			
Little Lime			2450	2460			
Pencil Cave			2460	2472			
Big Lime			2472	2550			
Big Injun			2550	2715			
Water			2655		Water		
Thirty Foot			3055	3090			
Fifty Foot			3180	3278			
Campbell Run			3414	3452			
Oil			3419		Oil		
Gordon			3463	3477			
Fourth			3508				
Oil			3515		Oil		
Total Depth				3529			

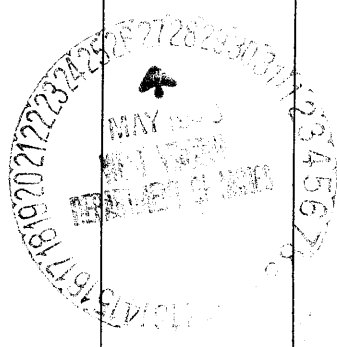

Formation	Color	Hard or Soft	Top	Bottom	Oil, Gas or Water	Depth Found	Remarks

Date May 25, 1948

APPROVED The Tri-State Pipe Company, Owner

By J. M. Read, Contractor

*J. M. Read, Contractor*