

Hannah Price		Isaac Epaw	
#1	2.26 S 4.10 W	#4	2.40 S 2.36 S
	2.30 S		3.64 W 3.60 W
#6	4.16 W	#5	2.52 S 2.50 S
	2.39 S 2.34 S		3.71 W 3.66 W
	4.17 W 4.10 W		

New Location
 Drill Deeper
 Abandonment

Company Haught Oil Co.
 Address Hundred W Va.
 Farm A. P. Haught
 Tract ONE Acres 219 Lease No. _____
 Well (Farm) No. L-4-5-4-6 Serial No. _____
 Elevation (Spirit Level) No. 1 = 1465 No. 5 = 1340
No. 4 = 1125 No. 6 = 1495
 Quadrangle Mannington
 County Monongalia District Battelle
 Engineer A. L. Headley
 Engineer's Registration No. _____
 File No. _____ Drawing No. _____
 Date 7-2-1947 Scale 1 inch = 800 ft

STATE OF WEST VIRGINIA
 DEPARTMENT OF MINES
 OIL AND GAS DIVISION
 CHARLESTON

WELL LOCATION MAP
 FILE NO. MON-391-A-#4
MON-392-A-#5

+ Denotes location of well on United States Topographic Maps, scale 1 to 62,500, latitude and longitude lines being represented by border lines as shown.
 - Denotes one inch spaces on border line of original tracing.



426

STATE OF WEST VIRGINIA
DEPARTMENT OF MINES
OIL AND GAS DIVISION

WELL RECORD

Permit No. 391-A

Oil or Gas Well Oil

(KIND)


Company Haught Oil Co., A. M. Snider Opr.
 Address Hundred, West Virginia
 Farm A. P. Haught Acres 219
 Location (waters) _____
 Well No. 4 Elev. 1125
 District Battelle County Monongalia
 The surface of tract is owned in fee by _____
 Address _____
 Mineral rights are owned by _____
 Address _____
 Drilling commenced 1906
 Drilling completed No Record
 Date Shot _____ From _____ To _____
 With _____
 Open Flow _____ /10ths Water in _____ Inch
 _____ /10ths Merc. in _____ Inch
 Volume _____ Cu. Ft.
 Rock Pressure _____ lbs. _____ hrs.
 Oil 40 bbls., 1st 24 hrs.
 Fresh water No Record feet _____ feet
 Salt water No Record feet _____ feet

Casing and Tubing	Used in Drilling	Left in Well	Packers
Size			
16			Kind of Packer _____
13			
10	<u>225</u>	<u>225</u>	Size of _____
8 1/4	<u>1400</u>	<u>1400</u>	
6 1/2	<u>2155</u>	<u>2155</u>	Depth set _____
5 3/16	<u>1448 sets liner</u>		
3			Perf. top _____
2			Perf. bottom _____
Liners Used			Perf. top _____
			Perf. bottom _____

CASING CEMENTED _____ SIZE _____ No. Ft. _____ Date _____

COAL WAS ENCOUNTERED AT 910 FEET ? INCHES
 _____ FEET _____ INCHES _____ FEET _____ INCHES
 _____ FEET _____ INCHES _____ FEET _____ INCHES

Formation	Color	Hard or Soft	Top	Bottom	Oil, Gas or Water	Depth Found	Remarks
<u>Pittsburgh Coal</u>			<u>910</u>	<u>?</u>			
<u>Big Dunkard</u>			<u>1400</u>	<u>?</u>			
<u>Big Lime</u>			<u>2155</u>	<u>?</u>			
<u>Big Injun</u>			<u>2210</u>				
<u>Total Depth</u>				<u>3250</u>			

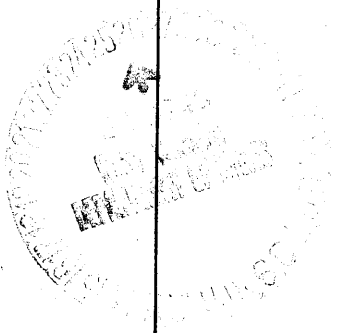

A. P. HAUGHT NO. 4 WELL.

391A

Battelle District, Monongalia County, W. Va.
By Haught Oil Co., A. W. Snider, Cpr., Hundred, W. Va.
Abandoned under permit Mon-..... -A7
On 219 acres.
Elevation, 1125' L.
Drilling commenced in 1906; no record of date of completion.
Oil, 40 bbls., 1st 24 hrs.
No record of water.
10" casing, 225'; 8", 1400'; 6", 2155'; 5", 1448', set as liner.
Coal was encountered at 910'.
Oil well. Record to Dept. of Mines stamped July 26, 1948.
Record to NCF from Mrs. Griffith Oct. 11, 1948. Old File No. 436.

	Top.	Bottom.
Pittsburgh Coal	910	-
Big Buckard Sand	1400	-
Big Line	2155	-
Big Injan Sand	2210	-
Total depth		3250