


Latitude 39 40'

Longitude 80 20'

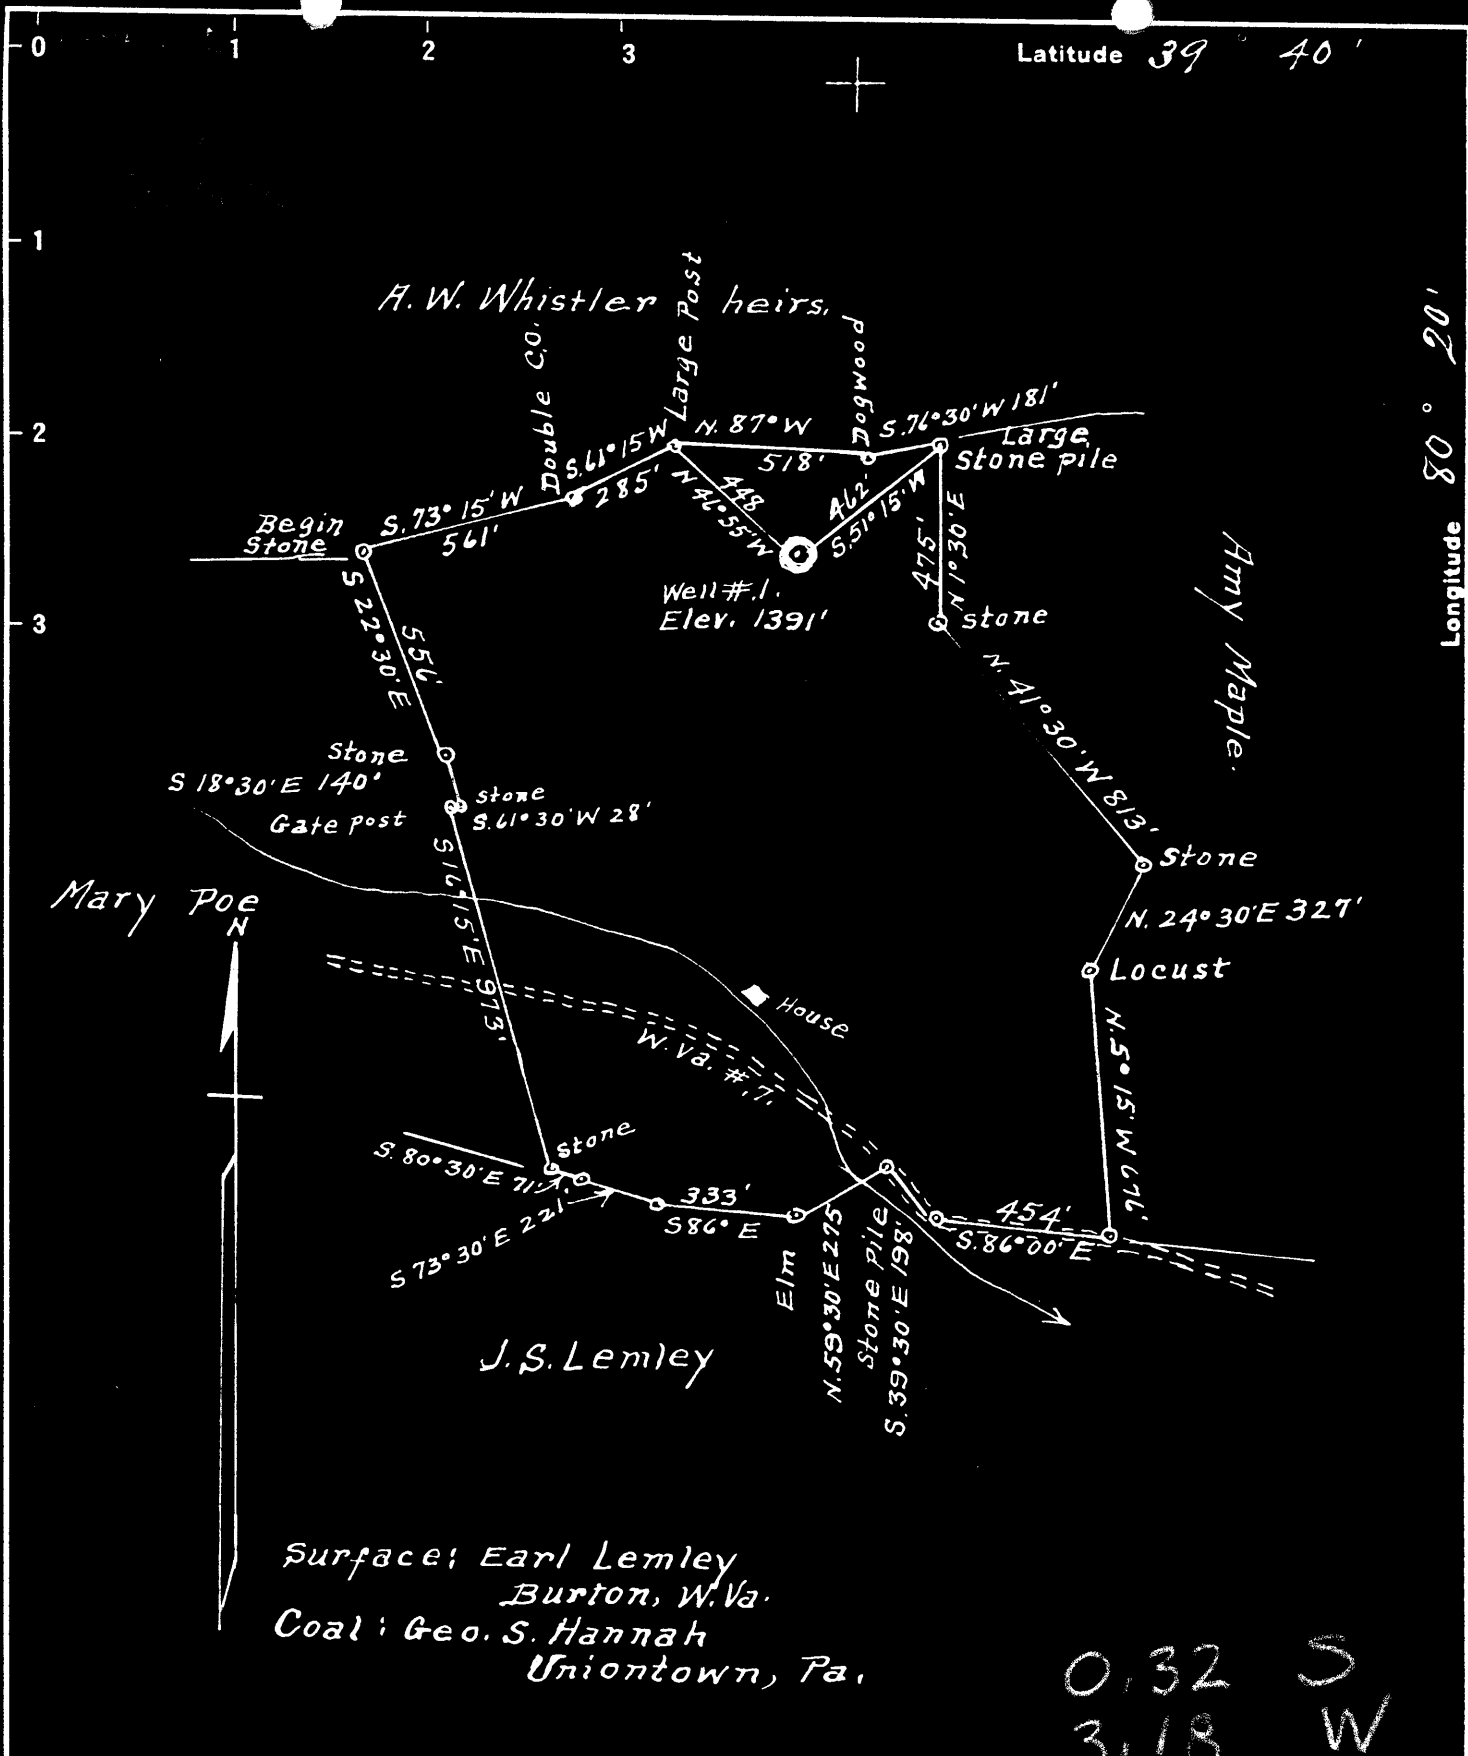

Surface; Earl Lemley
 Burton, W. Va.
 Coal; Geo. S. Hannah
 Uniontown, Pa.

0.32 S
 3.18 W

New Location
 Drill Deeper
 Abandonment

Company D. F. Bell
 Address Hundred, W. Va.
 Farm John H. Liming
 Tract 1 Acres 66 Lease No. _____
 Well (Farm) No. 1 Serial No. _____
 Elevation (Spirit Level) 1391'
 Quadrangle Mannington
 County Monongalia District Battelle
 Engineer A. L. Headley
 Engineer's Registration No. _____
 File No. _____ Drawing No. _____
 Date 10-12-1948 Scale 1" = 500'

STATE OF WEST VIRGINIA
 DEPARTMENT OF MINES
 OIL AND GAS DIVISION
 CHARLESTON

WELL LOCATION MAP
 FILE NO. MON-442-A

+ Denotes location of well on United States Topographic Maps, scale 1 to 62,500, latitude and longitude lines being represented by border lines as shown.

- Denotes one inch spaces on border line of original tracing.



STATE OF WEST VIRGINIA
DEPARTMENT OF MINES
OIL AND GAS DIVISION

152

WELL RECORD

Permit No. Y42-A

Oil or Gas Well

(KIND)


Company D. F. Bell
Address Hundred, W. Va.,
Farm John H. Living Acres 66
Location (waters) _____
Well No. _____ Elev. 1391'
District Battelle County Monongalia
The surface of tract is owned in fee by _____
Address _____
Mineral rights are owned by Earl Lemley
Address Burton, W. Va.,
Drilling commenced _____
Drilling completed _____
Date Shot _____ From _____ To _____
With _____
Open Flow _____ /10ths Water in _____ Inch
_____ /10ths Merc. in _____ Inch
Volume _____ Cu. Ft.
Rock Pressure _____ lbs. _____ hrs.
Oil _____ bbls., 1st 24 hrs.
Fresh water _____ feet _____ feet
Salt water _____ feet _____ feet

Casing and Tubing	Used in Drilling	Left in Well	Packers
Size			
16			Kind of Packer
13			
10	292	292	Size of
8 1/4	1750	1750	
6 3/4	2490	2490	Depth set
5 3/16	2702	2702	
3			Perf. top
2			Perf. bottom
Liners Used			Perf. top
			Perf. bottom

CASING CEMENTED _____ SIZE _____ No. Ft. _____ Date _____

COAL WAS ENCOUNTERED AT _____ FEET _____ INCHES
_____ FEET _____ INCHES
_____ FEET _____ INCHES

Formation	Color	Hard or Soft	Top	Bottom	Oil, Gas or Water	Depth Found	Remarks
Coal			1227	1235			
Murphy Sand			1400	1420			
Little Dunkard			1625	1650			
Big Dunkard			1735	1795			
Gas Sand			1860	1885			
First Salt Sand			1900	1985			
Second Salt Sand			2060	2110			
Third Salt Sand			2190	2235			
Maxon Sand			2400	2415			
Big Lime			2442	2500			
Big Injun			2500	2718			
Water in Injun very salty			2618	2626	Gas 2580-2586		
50 Ft.			3148	3230	Gas 3156-3162		
30 Ft.			3252	3285			
Stray Sand			3289	3302			
Gordon			3303	3328			
Fourth Sand			3353	3415	Gas 3393		
Fifth Sand			3423	3454			
Bayard Sand			3656	3661			
Total Depth			3668				
Hole bridged		(3520-3412)					

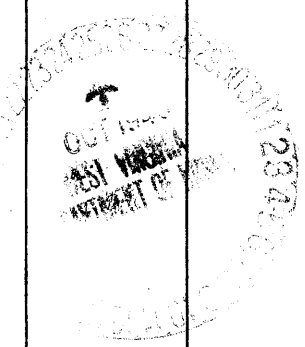

(Over)

JAN - 5 1949