


Latitude 39° 40'

Longitude 80° 10'

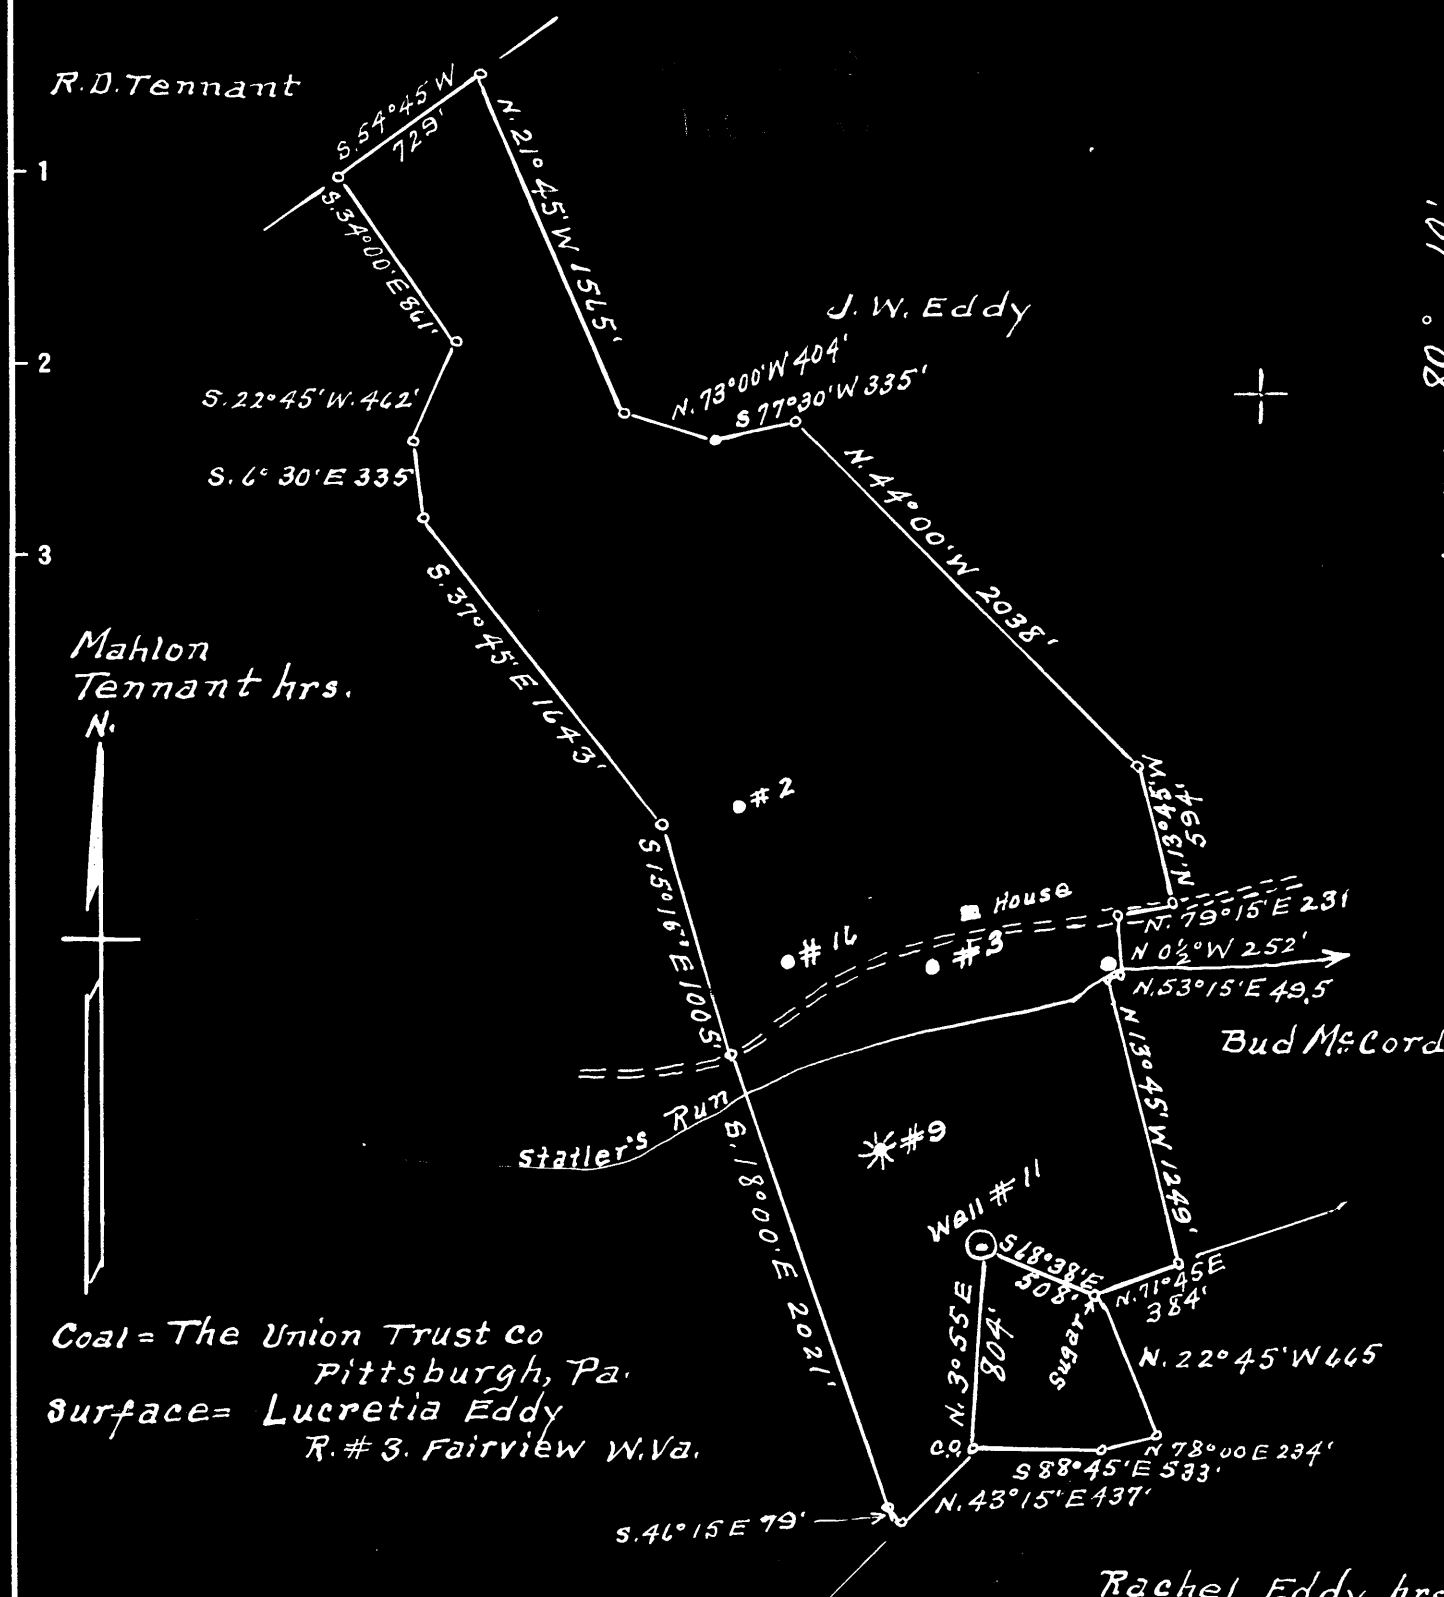

Coal = The Union Trust Co  
Pittsburgh, Pa.  
Surface = Lucretia Eddy  
R. # 3, Fairview W.Va.

2139 S  
108 W

New Location...   
Drill Deeper...   
Abandonment...

Company A. M. Snider  
Address Hundred, W.Va.  
Farm Simeon Tennant  
Tract 1 Acres 260 Lease No. 1396  
Well (Farm) No. 11 Serial No. \_\_\_\_\_  
Elevation (Spirit Level) 1335'  
Quadrangle Blacksville  
County Monongalia District Clay  
Engineer A. L. Headley, C.E.  
Engineer's Registration No. 2021  
File No. \_\_\_\_\_ Drawing No. \_\_\_\_\_  
Date Dec. 10, 1941 Scale 1" = 800'


STATE OF WEST VIRGINIA  
DEPARTMENT OF MINES  
OIL AND GAS DIVISION  
CHARLESTON

WELL LOCATION MAP  
FILE NO. MON-457-A

+ Denotes location of well on United States Topographic Maps, scale 1 to 62,500, latitude and longitude lines being represented by border lines as shown.  
- Denotes one inch spaces on border line of original tracing.

Latitude

Longitude

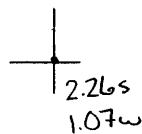

Topo Location

7.5' Loc. \_\_\_\_\_ 15' Loc. \_\_\_\_\_  
 \_\_\_\_\_ (calc.) \_\_\_\_\_

Company AM Smider

Farm Sumner Tenant #11

15' Quad \_\_\_\_\_  
(sec.)

7.5' Quad Blacksville

District Clay

WELL LOCATION PLAT

County Del Permit 30457