

Company Dunn-Mar Oil & Gas Co.
 Address Waynesburg Pa.
 Farm R. S. Thomas
 Tract 1 Acres 161+ Lease No. _____
 Well (Farm) No. 3 Serial No. 621
 Elevation (Spirit Level) 983
 Quadrangle Blacksville
 County Monongalia District Clay
 Engineer A. L. Headley
 Engineer's Registration No. 2021
 File No. _____ Drawing No. _____
 Date 3-14-1950 Scale 1" = 600'

STATE OF WEST VIRGINIA
 DEPARTMENT OF MINES
 OIL AND GAS DIVISION
 CHARLESTON

WELL LOCATION MAP
 FILE NO. MON-467-A

+ Denotes location of well on United States Topographic Maps, scale 1 to 62,500, latitude and longitude lines being represented by border lines as shown.
 - Denotes one inch spaces on border line of original tracing.



533

STATE OF WEST VIRGINIA
DEPARTMENT OF MINES
OIL AND GAS DIVISION

WELL RECORD

Ab
Permit No. WV-467-A


Oil or Gas Well Oil
(KIND)

Company Dunn-Mar Oil & Gas Co.
 Address Waynesburg, Pennsylvania.
 Farm R. Saul Thomas. Acres _____
 Location (waters) Miracle Run.
 Well No. 3 Elev. _____
 District Clay County Monongalia
 The surface of tract is owned in fee by Ralph M Thomas, Jr
 Address Blacksville, Wva.
 Mineral rights are owned by Union Gas & Oil Co.
 Address Washington, Pa.
 Drilling commenced June 27 19 30
 Drilling completed August 6 19 30
 Date Shot October 17 From 2075 To 2082
 With 15 Qts Nitroglycerene.
 Open Flow _____ /10ths Water in _____ Inch
 _____ /10ths Merc. in _____ Inch
 Volume _____ Cu. Ft.
 Rock Pressure _____ lbs. _____ hrs.
 Oil No Data. _____ bbls., 1st 24 hrs.
 Fresh water No Record feet _____ feet
 Salt water No Record feet _____ feet

Casing and Tubing	Used in Drilling	Left in Well	Packers
Size			
16			Kind of Packer
13			
10			Size of
8 1/4	1604	1604	
6 5/8	1905	1905	Depth set
5 3/16			
3			Perf. top
2			Perf. bottom
Liners Used			Perf. top
			Perf. bottom

CASING CEMENTED _____ SIZE _____ No. Ft. _____ Date _____
 COAL WAS ENCOUNTERED AT 650 FEET _____ INCHES
 _____ FEET _____ INCHES FEET _____ INCHES
 _____ FEET _____ INCHES FEET _____ INCHES

Formation	Color	Hard or Soft	Top	Bottom	Oil, Gas or Water	Depth Found	Remarks
Pitts Coal	Black	Soft	650	658			
Sand	Gray	Hard	1164	1216			
Gas Sand	Gray	Hard	1386	1426			
Big Injun	Gray	Hard	1944	2180	Oil	2077-2082	
Sand			Total Depth 2092				

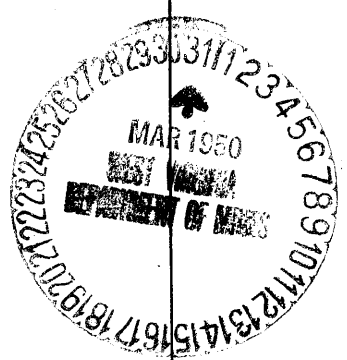

(Over) JUN 24 1951