

See Section 2
See Section 3
Continued

SEE THE OTHER SIDE

Company None
 Address Blacksville
 City Blacksville
 State Ark. Zone No. 41000
 Well Head No. _____ Serial No. 300
 Location (State town) Ark Blacksville
 County Blacksville
 County Blacksville Zone 4100
 Company Blacksville
 Engineer's Registration No. 300
 Fee No. _____ Section No. _____

State of West Virginia
Department of State
Oil and Gas Control

WELL LOCATION MAP
FILE NO. 300-300

• Symbols locate all wells shown State
Department Maps, zone 1 to 41000, on
this and adjacent maps being represented
by border lines as shown.
• Symbols are not shown on border line
of original survey.

LATITUDE 39° 37' 30"

75'

80° 07' 30"

LONGITUDE

7'5 OGIS topo location

7.5' loc	<u>0.585</u>	15' loc	<u>3.465</u>
	<u>0.250</u>	(calc.)	<u>2.470</u>

Company _____

Farm _____

Quad Grant Town (Brille C)

County Monongahela

District Clay

WELL LOCATION MAP

File No. 061-485A



STATE OF WEST VIRGINIA
DEPARTMENT OF MINES
OIL AND GAS DIVISION

555

WELL RECORD

Permit No. M 02-485-A


Gas Well (KIND)

Company Haps Natural Gas Company.
Address 445 West Main St. Clarksburg, W. Va.
Farm Thornton Miller Hrs. Acres _____
Location (waters) _____
Well No. 9508 M.P. 251 Elev. _____
District Clay County Monongalia.
The surface of tract is owned in fee by _____
Address _____
Mineral rights are owned by _____
Address _____
Drilling commenced Oct. 24, 1910
Drilling completed December 10, 1910
Date Shot _____ From _____ To _____
With _____
Open Flow _____ /10ths Water in _____ Inch
_____ /10ths Merc. in _____ Inch
Volume _____ Cu. Ft.
Rock Pressure _____ lbs. _____ hrs.
Oil _____ bbls., 1st 24 hrs.
Fresh water none recorded feet _____ feet
Salt water none recorded feet _____ feet

Casing and Tubing	Used in Drilling	Left in Well	Packers
Size			
16			Kind of Packer
13			
10	??	Pulled	Size of
8 1/4	??	Pulled	
6 5/8			Depth set
5 3/16	1704	1704	
3			Perf. top
2	1858	1858	Perf. bottom
Liners Used			Perf. top
			Perf. bottom

No record
CASING CEMENTED _____ SIZE _____ No. Ft. _____ Date _____
COAL WAS ENCOUNTERED AT 282 FEET 48 INCHES
412 FEET 84 INCHES FEET INCHES
FEET INCHES FEET INCHES

Formation	Color	Hard or Soft	Top	Bottom	Oil, Gas or Water	Depth Found	Remarks
Mapleton Coal			282	286			
Pittsburgh Coal			412	419			
Big Dunkard			997	1033			
First Salt			1286	1314			
Second Salt			1334	1499			
Little Lime			1583	1594			
Pencil c. ve			1594	1600			
Big Lime			1600	1670			
BIG INJUN			1670		gas	1757	
Total depth				1858			

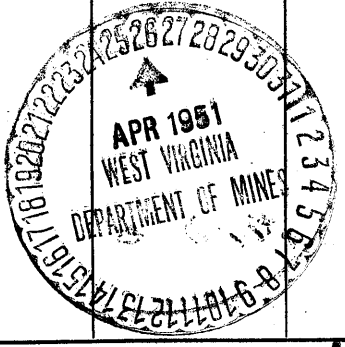

(Over) JUN 28 1951

