

New Location  
 Drill Chaser  
 Abandonment

MONSIEUR NO. 6 32 FB 1008 P 12.

Company	Hope Natural Gas Co
Address	Climksburg Wvs.
Farm	MARA Weaver
Treat	Acres 180 1/2 Lease No. 61895
Well (Farm) No.	Serial No. 9585
Elevation (Depth Level)	1254'
Geography	Blackville
County	Marshall

STATE OF WEST VIRGINIA  
 DEPARTMENT OF MINES  
 OIL AND GAS DIVISION  
 CHARLESTON

**WELL LOCATION MAP**  
 FILE NO. MON-492-8

⊕ Denotes location of well on United States

LATITUDE 39° 42' 30"

39° 42' 30"

75'

LONGITUDE

7.5 OGIS topo location

7.5' loc	<u>1.005</u>	15' loc	<u>3.885</u>
	0.180	(calc.)	2.400

Company \_\_\_\_\_

Farm \_\_\_\_\_

Quad Osage (Bulle NE)

County Monongahela

District Cass

WELL LOCATION MAP

File No. 061-493A

#262 in R12 Co Rpt

061-70348

MARK WEAVER NO. 9585 (MP-232) WELL.

Gas District, Mason Dixon County, W. Va.

By Howe Natural Gas Co., 445 E. Main St., Clarksburg, W. Va.

Abandoned under permit No. ....-A?

On 160 acres.

Elevation, 1254' L.

Drilling commenced March 20, 1909; completed July 2, 1909.

No water recorded.

10" casing, 507' (pulled); 8", 1153' (pulled); 6", 1510' (pulled);  
5", 1786'; 2" tubing, 2405'.

Casing not cemented.

Coal was encountered at 385-390 and 477-485'.

Gas well. Record to Dept. of Mines dated May 15, 1951.

Record to WCT from Mrs. Griffith Aug. 17, 1951. Old file No. 551.

	Top.	Bottom.
Marietta (Sawtooth) Coal	385	390
Pittsburgh Coal	477	485
Salt Sand	1378	1428
Big Line	1725	1786
Big Injun Sand (gas, 1875, 1890')	1786	1951
Berea Sand (gas, 2350')	2337	2385
Gordon Sand	2695	2723
Fourth Sand	2759	2782
Fifth Sand	2816	2852
Seventh Sand	2895	2963
Total depth		2993
Filled back to		2405

**MAHE WEAVER NO. 1 (232) WELL.**

**Gas District, Manngalia County, W. Va.  
By Manngalia West Penn Public Service Co.  
Commenced Drilling Mar. 29, 1909; completed, July 2, 1909.  
No.....in Gas Report.**

**For well log, see p. 494, Manngalia-Marian-Taylor Report of Survey.**

**Total depth 2993 ft.**

**Producing from Big Injun and Berea Sands.**



STATE OF WEST VIRGINIA  
DEPARTMENT OF MINES  
OIL AND GAS DIVISION

551

WELL RECORD

Permit No. MON-493A


~~Oil~~ Gas Well (KIND)

Company Hope Natural Gas Company.  
Address 445 West Main St. Clarksburg, W. Va.  
Farm Mark Weaver. Acres 180 1/2  
Location (waters) \_\_\_\_\_  
Well No. 9585 M.P. 232 Elev. 1254  
District Cass County Monongalia  
The surface of tract is owned in fee by \_\_\_\_\_  
Address \_\_\_\_\_  
Mineral rights are owned by \_\_\_\_\_  
Address \_\_\_\_\_  
Drilling commenced March 20, 1909  
Drilling completed July 2, 1909  
Date Shot \_\_\_\_\_ From \_\_\_\_\_ To \_\_\_\_\_  
With \_\_\_\_\_  
Open Flow \_\_\_\_\_ /10ths Water in \_\_\_\_\_ Inch  
\_\_\_\_\_ /10ths Merc. in \_\_\_\_\_ Inch  
Volume \_\_\_\_\_ Cu. Ft.  
Rock Pressure \_\_\_\_\_ lbs. \_\_\_\_\_ hrs.  
Oil \_\_\_\_\_ bbls., 1st 24 hrs.  
Fresh water none recorded feet \_\_\_\_\_ feet  
Salt water none recorded feet \_\_\_\_\_ feet

Casing and Tubing	Used in Drilling	Left in Well	Packers
Size			Kind of Packer
16			
13			
10	507	Pulled	Size of
8 1/2	1153	Pulled	
6 1/2	1510	Pulled	Depth set
5 3/16	1736	1736	
3			Perf. top
2	2405	2405	Perf. bottom
Liners Used			Perf. top
			Perf. bottom

~~NOT~~  
CASING CEMENTED \_\_\_\_\_ SIZE \_\_\_\_\_ No. Ft. \_\_\_\_\_ Dat \_\_\_\_\_  
COAL WAS ENCOUNTERED AT 385 FEET 60 INCHES  
477 FEET 96 INCHES FEET INCHES  
FEET INCHES FEET INCHES

Formation	Color	Hard or Soft	Top	Bottom	Oil, Gas or Water	Depth Found	Remarks
Mapletown Coal			385	390			
Pittsburgh Coal			477	485			
Salt sands			1338	1428			
Big Lime			1725	1786			
Big Injun			1786	1951	gas	1875 1890	
Berea			2332	2385	gas	2350	
Gordon			2695	2723			
Fourth			2759	2782			
Fifth			2816	2852			
Bayard			2895	2963			
Total depth				2993			
Filled back to				2405			

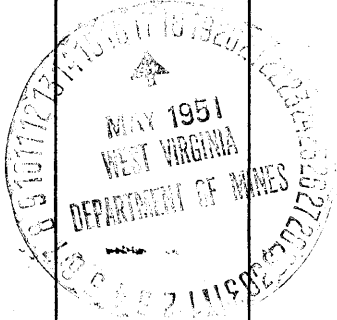

AUG 17 1951  
(Over)

Formation	Color	Hard or Soft	Top	Bottom	Oil, Gas or Water	Depth Found	Remarks

Date **May 15, 1951**

, 19

**Hope Natural Gas Company.**

APPROVED \_\_\_\_\_, Own

By \_\_\_\_\_

(Title)  
