

Show Location
 Drill Deep
 Abandonment

Map No. 2, 30 N 10 E 24, T8 100 R 16

Company	NORG NATUREL GAS CO	
Address	CHARLESTON, W. VA.	
Form	SPENCER M. BONLEY	
Tract	Acres 28	Less No. 61870
Well (Form) No.	Serial No. 2576	
Shallies (Right Level)	1066'	
Geobridge	BLACKSHALE	
County	MORGANTHAU	District C 282
Engineer	W. H. [Signature]	

STATE OF WEST VIRGINIA
 DEPARTMENT OF MINES
 OIL AND GAS DIVISION
 CHARLESTON

WELL LOCATION MAP
 FILE NO. NON-2576

◆ Denotes location of well on United States Topographic Maps, scale 1 to 62,500, latitude and longitude lines being represented by border lines as shown.

LATITUDE 39° 45' 00"

LONGITUDE 78° 00' 00"

LONGITUDE

7.5'

7.5 OGIS topo location

7.5' loc $\frac{2.075}{0.67W}$

15' loc $\frac{2.075}{0.67W}$
(calc.)

Company _____

Farm _____

Quad Osage (Buile NE)

County Monongahela

District Cass

WELL LOCATION MAP

File No. 061-494A

Cane District, Monongalia County, W. Va.
 By Hope Natural Gas Co., 445 W. Main St., Clarksburg, W. Va.
 Abandoned under permit Mon-.....-A1
 On 25 acres.
 Elevation, 1246' L.
 Drilling commenced Nov. 22, 1910; completed Feb. 3, 1911.
 Salt water at 1285'.
 10" casing, 445' (pulled); 8 1/2", 1065' (pulled); 6 3/4", 1445' (pulled);
 5", 1720'; 2" tubing, 1775'.
 Casing not cemented.
 Coal was encountered at 314-320 and 415-424'.
 Gas well. Record to Dept. of Mines dated May 10, 1951.
 Record to DOT from Mrs. Griffith Aug. 17, 1951. Old File No. 538.

	Top.	Bottom.
Mapletown (Sewickley) Coal	314	320
Pittsburgh Coal	415	424
Little Tucker Sand	900	925
Gas Sand	1215
Salt Sand (water, 1285')	1275	1445
Big Lime	1645	1720
Big Injun Sand (gas, 1813, 1820, and 1850')	1790	1895
Fifty-foot Sand (gas, 2355')	2335
Garden Sand	2615
Total depth		2923



538

STATE OF WEST VIRGINIA
DEPARTMENT OF MINES
OIL AND GAS DIVISION

WELL RECORD

Permit No. Monk 494-A


ZZZ
Oil or Gas Well (KIND)

Company Hope Natural Gas Company.
 Address 445 West Main St. Clarksburg, W. Va.
 Farm S.M. Bowby. Acres 25
 Location (waters) _____
 Well No. 9574 M.P. 281 Elev. 1246
 District Cass County Monongalia.
 The surface of tract is owned in fee by _____
 Address _____
 Mineral rights are owned by _____
 Address _____
 Drilling commenced November 22, 1910
 Drilling completed February 3, 1911
 Date Shot _____ From _____ To _____
 With _____
 Open Flow _____ /10ths Water in _____ Inch
 _____ /10ths Merc. in _____ Inch
 Volume _____ Cu. Ft.
 Rock Pressure _____ lbs. _____ hrs.
 Oil _____ bbls., 1st 24 hrs.
 Fresh water _____ feet _____ feet
 Salt water 1285 feet _____ feet

Casing and Tubing	Used in Drilling	Left in Well	Packers
Size			Kind of Packer
16			
13			
10	<u>445</u>	<u>Pulled</u>	Size of
8 3/4	<u>1065</u>	<u>Pulled</u>	
6 5/8	<u>1445</u>	<u>Pulled.</u>	Depth set.
5 3/16	<u>1720</u>	<u>1720</u>	
3			Perf. top
2	<u>1775</u>	<u>1775</u>	Perf. bottom
Liners Used			Perf. top
			Perf. bottom

NOT
 CASING CEMENTED _____ SIZE _____ No. Ft. _____ Date _____
 COAL WAS ENCOUNTERED AT 314 FEET 72 INCHES
415 FEET 108 INCHES FEET INCHES
 FEET INCHES FEET INCHES

Formation	Color	Hard or Soft	Top	Bottom	Oil, Gas or Water	Depth Found	Remarks
Mapletown coal			<u>314</u>	400			
Pittsburgh Coal			<u>415</u>	<u>424</u>			
Little Dunkard			<u>900</u>	<u>925</u>			
Gas sand			<u>1215</u>				
Salt sand			<u>1275</u>	<u>1445</u>	water	<u>1285</u>	
Big Lime			<u>1645</u>	<u>1720</u>			
Big Injun			<u>1790</u>	<u>1895</u>	gas	<u>1813</u>	<u>-20- 50</u>
Fifty foot			<u>2335</u>		gas	<u>2355</u>	
Gordon			<u>2615</u>				
Total depth				<u>2923</u>			

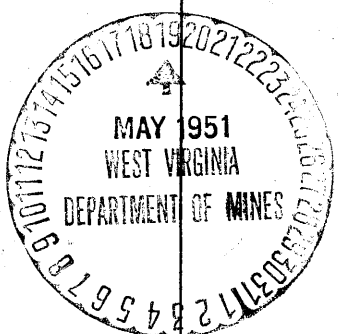

AUG 17 1951

Formation	Color	Hard or Soft	Top	Bottom	Oil, Gas or Water	Depth Found	Remarks

Date **May 10, 1951**, 19

APPROVED **Hope Natural Gas Company**, Owner

By _____ (Title)

[Handwritten Signature]

DEPARTMENT OF MINES
OIL AND GAS DIVISION

AFFIDAVIT OF PLUGGING AND FILLING WELL.

AFFIDAVIT SHOULD BE MADE IN TRIPPLICATE, ONE COPY MAILED TO THE DEPARTMENT, ONE COPY TO BE RETURNED BY THE WELL OPERATOR AND THE THIRD COPY LAST COPIED COPY IF NECESSARY, SHOULD BE MAILED TO EACH LOCAL OPERATOR OF THEIR RESPECTIVE JURISDICTION.

Christopher McCoal Company,
WELL OPERATOR OR OWNER
Forsyth, W. Va.
ADDRESS

Hope Natural Gas Company,
WELL OPERATOR
145 West Main St., Clarksburg, W. Va.
COMPLETE ADDRESS
June 9, 1931
WELL AND LOCATION

Cass, District
Monongalia, County
Well No. 9775
S. M. Smully Farm

STATE INSPECTOR SUPERVISING PLUGGING

AFFIDAVIT

STATE OF WEST VIRGINIA.

County of Monongalia

vs:

Charles A. Tashman and John J. Mumby
being first duly sworn according to law depose and say that they are experienced in the work of plugging and filling oil and gas wells and were employed by Hope Natural Gas Company well operator, and participated in the work of plugging and filling the above well, that said work was commenced on the 28th day of June, 1931, and that the well was plugged and filled in the following manner:

DRAIN OR BORE NUMBER	FILLING MATERIAL		FLUIDS USED		GASOLINE	
	DEPTH	FEET	WATER	WELL OIL	400 POUNDS	500 LBS. IN
<u>Right Coal 314-328</u>	<u>Asphalt</u>	<u>2000</u>	<u>2000</u>			<u>2 1/2"</u>
<u>Right Coal 412-426</u>	<u>Gravel</u>	<u>2000</u>	<u>2000</u>			<u>1700'</u>
<u>Little Redford 500-514</u>	<u>Asphalt</u>	<u>2000</u>	<u>1700</u>			<u>2 1/2"</u>
<u>Gas Coal 1012</u>	<u>Gravel</u>	<u>1700</u>	<u>1700</u>			<u>1700'</u>
<u>Salt Coal 1872-1886</u>	<u>Coal</u>	<u>1700</u>	<u>Surface</u>			
<u>Big Lane 1886-1790</u>						
<u>Big Lane 1790-1886</u>	<u>Water</u>	<u>2 1/2"</u>	<u>under 100' in well on west. side of hole</u>			
<u>SO St.</u>	<u>2000</u>		<u>none at 200' 500' and</u>			
<u>Garrett</u>	<u>2000</u>	<u>400'</u>				
<u>Total Depth</u>	<u>2000</u>					

*some water from 2012 to bottom of hole, water is distinguish.



DESCRIPTION OF EQUIPMENT
Equipment erected, model 2000 411
No. 9775. Manual equipped with
vent pipe to air.

and that the work of plugging and filling said well was completed on the 9th day of June, 1931

And further deponents oath not.

Sworn to and subscribed before me this 11

Charles A. Tashman
John J. Mumby
John A. Mumby
Richard W. Mumby
Secretary Public

My commission expires:
July 22, 1936

Permit No. 14521-494