



Company **Hoke Natural Gas Co**
 Address **Charleston, W. Va.**
 Farm **John Sanders Mrs**
 Tract _____ Acres **160** Lease No. **61200**
 Well (Farm) No. _____ Serial No. **2521**
 Elevation (Rough Level) **800**
 Quadrangle **MORGANTOWN**
 County **MORGANTOWN** District **CASE**
 Date **11/14/1911**

STATE OF WEST VIRGINIA
 DEPARTMENT OF MINES
 OIL AND GAS DIVISION
 CHARLESTON

WELL LOCATION MAP
 FILE NO. **MO. 542-9**

⊕ Denotes location of well on United States
 Topographic Maps, scale 1 to 62,500, lat-
 itude and longitude lines unless mentioned

LATITUDE 39°42'30"

75'
+

79°57'30"

LONGITUDE

7'5 OGIS topo location

7.5' loc	<u>0.1605</u>	15' loc	<u>3.485</u>
	<u>1.92 W</u>	(calc.)	<u>4.14 W</u>

Company _____

Farm _____

Quad Morgantown North

County Monongahela

District Cass

(Morgan
New)

WELL LOCATION MAP

File No. 061-500A

JOHN SANDERS WELLS NO. 9621 (NW-325) WELL.

Gas District, Monongalia County, W. Va.
 By Hope Natural Gas Co., 445 W. Main St., Clarksburg, W. Va.
 Abandoned under permit non-.....-A7
 On.....
 Elevation, L.
 Drilling completed May 30, 1911.
 No water recorded.
 10" casing, 285' (pulled); 8", 746' (pulled); 6", 1085'; 2" tubing, 1492'
 Casing not cemented.
 Coal was encountered at 10-19'.
 Gas well. Record to Dept. of Mines dated May 28, 1951.
 Record to NCT from Mrs. Griffith Aug. 17, 1951. Old file No. 549.

	Top.	Bottom.
Pittsburgh Coal	10	19
Little Buckard Sand	435	455
Salt Sand	872	1055
Little Line	1240	1257
Pencil Core	1257	1262
Big Line	1262	1335
Big Injun Sand (gas, 1340, 1363, 1453')	1335	1492
Total depth		1492



STATE OF WEST VIRGINIA
DEPARTMENT OF MINES
OIL AND GAS DIVISION

549

Permit No. M 8 W 500-A

WELL RECORD


Other Gas Well (KIND)

Company Hope Natural Gas Company.
Address 445 West Main St. Clarksburg, W. Va.
Farm John Sanders Hrs. Acres _____
Location (waters) _____
Well No. 9621 M.P. 325 Elev. _____
District Cass County Monongalia.
The surface of tract is owned in fee by _____
Address _____
Mineral rights are owned by _____
Address _____
Drilling commenced _____
Drilling completed may 30, 1911
Date Shot _____ From _____ To _____
With _____
Open Flow _____ /10ths Water in _____ Inch
_____ /10ths Merc. in _____ Inch
Volume _____ Cu. Ft.
Rock Pressure _____ lbs. _____ hrs.
Oil _____ bbls., 1st 24 hrs.
Fresh water none recorded feet _____ feet
Salt water none recorded feet _____ feet

Casing and Tubing	Used in Drilling	Left in Well	Packers
Size			Kind of Packer
16			
13			
10	<u>285</u>	<u>Pulled</u>	Size of
8 1/4	<u>746</u>	<u>Pulled</u>	
6 5/8	<u>1085</u>	<u>1085</u>	Depth set
5 3/16			
3			Perf. top
2	<u>1492</u>	<u>1492</u>	Perf. bottom
Liners Used			Perf. top
			Perf. bottom

CASING CEMENTED NOT SIZE _____ No. Ft. _____
COAL WAS ENCOUNTERED AT 10 FEET 100 INCHES
FEET INCHES FEET INCHES
FEET INCHES FEET INCHES

Formation	Color	Hard or Soft	Top	Bottom	Oil, Gas or Water	Depth Found	Remarks
Pittsburgh Coal			<u>100</u>	<u>19</u>			
Little Dunkard			<u>435</u>	<u>455</u>			
Salt sand			<u>872</u>	<u>1055</u>			
Little Lins			<u>1240</u>	<u>1257</u>			
Pencil cave			<u>1257</u>	<u>1262</u>			
Big Lins			<u>1262</u>	<u>1335</u>			
Big Injun			<u>1335</u>	<u>1492</u>	<u>gas</u>	<u>1340 1363 1453</u>	
Total depth				<u>1492</u>			

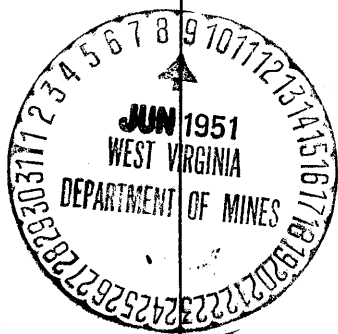

Formation	Color	Hard or Soft	Top	Bottom	Oil, Gas or Water	Depth Found	Remarks

Date May 28, 1951, 19

APPROVED Hope Natural Gas Company, Own

By E. H. Tolbert

E. H. Tolbert
 General Superintendent

STATE OF WEST VIRGINIA
DEPARTMENT OF MINES
OIL AND GAS DIVISION

AFFIDAVIT OF PLUGGING AND FILLING WELL

AFFIDAVIT SHOULD BE MADE IN TRIPPLICATE, ONE COPY MAILED TO THE DEPARTMENT, ONE COPY TO BE RETURNED BY THE WELL OPERATOR AND THE THIRD COPY (AND SEVERAL COPIES IF NECESSARY) SHOULD BE MAILED TO EACH COAL OPERATOR AT THEIR RESPECTIVE ADDRESS.

Delbert Coal Company Hoge Natural Gas Company
COAL OPERATOR OR OWNER NAME OF WELL OPERATOR
Fairmont, W. Va. 445 West Main St., Clarinsburg, W. Va.
ADDRESS COMPLETE ADDRESS
_____ 8-28-53 _____ IS
WELL AND LOCATION
DISTRICT _____ Case _____ District
COUNTY _____ Monongalia _____ County
WELL No. 9601
John Sanders Mrs. _____ Form

Mr. Bender Chas Leadsle et al
LESSOR OR PROPERTY OWNER
Hargershom, W. Va. _____
ADDRESS

STATE INSPECTOR SUPERVISING PLUGGING _____

AFFIDAVIT

STATE OF WEST VIRGINIA,

County of Monongalia)Charles A. Swineman andJohn F. Murphy

being first duly sworn according to law depose and say that they are experienced in the work of plugging and filling oil and gas wells and was employed by Hoge Natural Gas Company well operator, and participated in the work of plugging and filling the above well, that said work was commenced on the 28th day of June, 1953, and that the well was plugged and filled in the following manner:

DATE OF WORK BEGUN	TIME	MATERIAL	FILLING INTERVAL		FLOOD DEPTH	GAINING	
			FROM	TO		ONE FEET	ONE FOOT IN
<u>Feb. 28th</u>	<u>10- 10</u>	<u>Asphalt</u>	<u>1000</u>	<u>1018</u>			<u>90</u>
<u>1-11-53</u>	<u>400- 400</u>	<u>Cement</u>	<u>1000</u>	<u>1000</u>			<u>None - 1000'</u>
<u>1st. Salt</u>	<u>070-2000</u>	<u>Asphalt</u>	<u>1000</u>	<u>1100</u>			
<u>2nd. Salt</u>		<u>Cement</u>	<u>1000</u>	<u>1000</u>			<u>2-3/4" Spine</u>
<u>2. Lime</u>	<u>1800-1800</u>	<u>Wet 10" pipe to surface.</u>				<u>1400'</u>	<u>None</u>
<u>Final Core</u>	<u>1827-1828</u>	<u>7" pipe, left in well for</u>					
<u>2. Lime</u>	<u>1828-1828</u>	<u>used to surface and post-</u>					
<u>2. Lime</u>	<u>1828-1828</u>	<u>used at 400' on the well</u>					
<u>Final Spine</u>	<u>1828</u>	<u>5/8" x 7' pipe, cement from</u>					
		<u>to 20', with 20' mud pipe</u>					
		<u>through mud pipe into air.</u>					

COAL OPERATOR

DESCRIPTION OF MESSUREMENT

NAME

NAME

NAME

NAME

Charles Will Muncie created
near top of hole sealed H.W.G.Co.
Well # 9601.

and that the work of plugging and filling said well was completed on the 28th day of June

And further deponent saith not.

Sworn to and subscribed before me this 1st day of July, 1953.