

See Location   
 See Diagram   
 Abandonment

WELL LOCATION MAP

Company North American Gas Co  
 Address Charleston, W. Va.  
 Farm John Sanders  
 Tract Acres 60 Lease No. 41000  
 Well (Farm) No.          Serial No. 2000  
 Elevation (Feet Lbsl) 1120'  
 Geologic Allegheny

STATE OF WEST VIRGINIA  
 DEPARTMENT OF MINES  
 OIL AND GAS DIVISION  
 CHARLESTON

WELL LOCATION MAP  
 FILE NO. 10341-2000

◆ Denotes location of well on United States

LATITUDE 39°42'30"

75° 15' 30"

LONGITUDE



7'5 OGIS topo location

7.5' loc	<u>1.025</u>	15' loc	<u>3.905</u>
	<u>1.25W</u>	(calc.)	<u>3.47W</u>

Company \_\_\_\_\_

Farm \_\_\_\_\_

Quad Morgantown North (North NW)

County Mahoning

District Cass

WELL LOCATION MAP

File No. DL61-503A

Cass District, Monongalia County, W. Va.  
 By Hope Natural Gas Co., 445 W. Main St., Clarksburg, W. Va.  
 Abandoned under permit No. ....-A1  
 On 68 acres.

Elevation, .....<sup>1</sup> L.  
 Drilling completed about May 1906.  
 No water reported.

10" casing, ....<sup>1</sup>; 8"<sup>1</sup>, .....<sup>1</sup>; 6"<sup>1</sup>, 1453'; 3" tubing, 1550'.  
 Casing not cemented.

Coal was encountered at 65-70, 145-149, 170-177, and 833-839'.

Gas well. Record to Dept. of Mines dated June 12, 1951.

Record to RCE from Mrs. Griffith Aug. 27, 1951. Old File No. 557.

	Top.	Bottom.
Mapletown (Sewickley) Coal	65	70
Bedstone Coal	145	149
Pittsburgh Coal	170	177
Freeport (?) Coal	833	839
Salt Sand	996	1179
Big Injun Sand (gas, 1581 and 1629')	1436	.....
Total depth		1710



557

STATE OF WEST VIRGINIA  
DEPARTMENT OF MINES  
OIL AND GAS DIVISION

WELL RECORD

Permit No. MON-503-A

~~Oil~~ Gas Well (KIND)


Company Hope Natural Gas Company.  
 Address 445 West Main St. Clarksburg, W. Va.  
 Farm John Sanders Acres 68  
 Location (waters) \_\_\_\_\_  
 Well No. 9603 M.P. 216 Elev. \_\_\_\_\_  
 District Cass County Monongalia  
 The surface of tract is owned in fee by \_\_\_\_\_  
 Address \_\_\_\_\_  
 Mineral rights are owned by \_\_\_\_\_  
 Address \_\_\_\_\_  
 Drilling commenced \_\_\_\_\_  
 Drilling completed about May, 1906  
 Date Shot \_\_\_\_\_ From \_\_\_\_\_ To \_\_\_\_\_  
 With \_\_\_\_\_  
 Open Flow \_\_\_\_\_ /10ths Water in \_\_\_\_\_ Inch  
 \_\_\_\_\_ /10ths Merc. in \_\_\_\_\_ Inch  
 Volume \_\_\_\_\_ Cu. Ft.  
 Rock Pressure \_\_\_\_\_ lbs. \_\_\_\_\_ hrs.  
 Oil \_\_\_\_\_ bbls., 1st 24 hrs.  
 Fresh water no feet \_\_\_\_\_ feet  
 Salt water no feet \_\_\_\_\_ feet

Casing and Tubing	Used in Drilling	Left in Well	Packers
Size			
16			Kind of Packer
13			
10	?	?	Size of
8 3/4	?	?	
6 3/4	1453	1453	Depth set
5 3/16			
3	1590	1590	Perf. top
2			Perf. bottom
Liners Used			Perf. top
			Perf. bottom

CASING CEMENTED NOT SIZE \_\_\_\_\_ No. Ft. \_\_\_\_\_ Date \_\_\_\_\_

COAL WAS ENCOUNTERED AT 65 FEET 60 INCHES  
145 FEET 48 INCHES 170 FEET 84 INCHES  
833 FEET 72 INCHES FEET INCHES

Formation	Color	Hard or Soft	Top	Bottom	Oil, Gas or Water	Depth Found	Remarks
Mapletown Coal			65	70			
Redstone			145	149			
Pittsburgh Coal			170	177			
Fresport Coal			833	839			
Salt sand			996	1179			
Big Injun			1486		gas	1581 1629	
Total depth				1710			

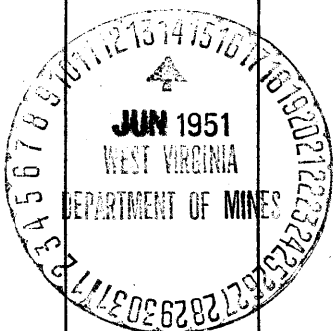

Formation	Color	Hard or Soft	Top	Bottom	Oil, Gas or Water	Depth Found	Remarks

Date 6-12, 1957

APPROVED \_\_\_\_\_, Own

By \_\_\_\_\_

*(Signature)*  
 (Title)

*(Signature)*

STATE OF WEST VIRGINIA  
DEPARTMENT OF MINES  
OIL AND GAS DIVISION

AFFIDAVIT OF PLUGGING AND FILLING WELL

AFFIDAVIT SHOULD BE MADE IN TRIPPLICATE, ONE COPY MAILED TO THE DEPARTMENT, ONE COPY TO BE RETAINED BY THE WELL OPERATOR AND THE THIRD COPY (AND EXTRA COPIES IF REQUIRED) SHOULD BE MAILED TO EACH WELL OPERATOR AT THEIR RESPECTIVE ADDRESSES.

Christopher Coal Company, Hops Natural Gas Company,  
COAL OPERATOR OR OWNER NAME OF WELL OPERATOR  
Farmdale, W. Va. 445 West Main St., Clarksburg, W. Va.  
ADDRESS COMPLETE ADDRESS  
\_\_\_\_\_  
COAL OPERATOR OR OWNER WELL AND LOCATION 196  
\_\_\_\_\_  
ADDRESS Case, District  
\_\_\_\_\_  
LEASE OR PROPERTY OWNER Monongalia, County  
\_\_\_\_\_  
ADDRESS Well No. 9283  
John Sanders, Farm

STATE INSPECTOR SUPERVISING PLUGGING

AFFIDAVIT

STATE OF WEST VIRGINIA,

County of Monongalia ) ss:

Virgil L. Snodgrass and Forrest E. Snider  
being first duly sworn according to law depose and say that they are experienced in the work of plugging and filling oil and gas wells and were employed by Hops Natural Gas Co. well operator, and participated in the work of plugging and filling the above well, that said work was commenced on the 18th day of July, 1961, and that the well was plugged and filled in the following manner:

BAND OR STRIKE DESIGNATION	FILLING MATERIAL			PLUGS USED	GAS-ING	
	POSITION	CONTENT	FEET TO		SEE PAGE	SEE LEFT IN
<u>Maple Hill</u>	<u>68-70</u>	<u>Agucanal</u>	<u>1710</u>	<u>1668</u>		<u>70</u>
<u>Redstone Coal</u>	<u>148-149</u>	<u>Cement</u>	<u>1668</u>	<u>1668</u>		<u>None - 1668'</u>
<u>Pgh. Coal</u>	<u>170-177</u>	<u>None left open to surface</u>				
<u>Freeport Coal</u>	<u>228-229</u>	<u>Perforated 7" cas. at</u>				<u>1708' - None</u>
<u>1st Sale</u>	<u>206-210</u>	<u>900', 820' and 174'</u>				
<u>2nd Sale</u>		<u>Note: Records showed well</u>				
<u>In Jan</u>	<u>1958</u>	<u>to have 1850' of 8" thg.</u>				
<u>Total Depth</u>	<u>1710</u>	<u>in it. We plugged 1708'.</u>				
		<u>This well was purchased</u>				
		<u>from the Monaca Power Co.</u>				
		<u>Marker set over top of</u>				
		<u>7" cas. with 8" vent through</u>				
		<u>marker into air.</u>				
COAL DESIGNATION	DESCRIPTION OF WORK					
Serial	Concrete well marker created over					
Serial	top of hole with 8" vent into air					
Serial	marked H.N.G.Co. Well # 9283.					
Serial						



and that the work of plugging and filling said well was completed on the 24th day of July, 1961

And further deponents oath not.

Subscribed before me this 11 day of August, 1961

*Virgil L. Snodgrass*  
*Forrest E. Snider*  
*John Sanders*