



Well Location   
 Well Depth   
 Measurement

Scale of 1" = 1000'

Company Henry Albrecht Gas Co  
 Address Cherryvale Ave  
 Town J. R. ...  
 Well (Face) No. 1000 Date No. 1000  
 Elevation (Spot Level) 1000'  
 County ... ..  
 Engineer W. H. ...  
 Engineer's Registration No. 90

STATE OF WEST VIRGINIA  
 DEPARTMENT OF MINES  
 OIL AND GAS DIVISION  
 CHARLESTON

**WELL LOCATION MAP**  
 FILE NO. 1000-1000

◆ Shows location of well on United States  
 Topographic Maps, scale 1 to 62,500, latitude  
 and longitude lines being represented  
 by longer lines as shown.

75'

LATITUDE 39° 40' 00"

80° 02' 30"

LONGITUDE

7.5 OGIS topo location

|          |              |         |              |
|----------|--------------|---------|--------------|
| 7.5' loc | <u>0.085</u> | 15' loc | <u>0.085</u> |
|          | <u>1.65W</u> | (calc.) | <u>3.87W</u> |

Company \_\_\_\_\_

Farm \_\_\_\_\_

Quad Deage (Bulle EC)

County Monongahela

District Cass

WELL LOCATION MAP

File No. 061-505A

J. K. BARRICKMAN NO. 9586 (MP-241) WELL.

Cass District, Monongalia County, W. Va.  
By Hope Natural Gas Co., 445 W. Main St., Clarksburg, W. Va.  
Abandoned under permit Mon-.....-A7  
On 6 acres.

Elevation, 1069' L.

Drilling completed about 1901.

10", 8", and 6" casing, pulled; 5", 1500'; 2" tubing, 1700'; left in?  
Casing not cemented.

Coal was encountered at 239-246 (Est.) and 329-336' (Est.)

Gas well. Record to Dept. of Mines stamped July 3, 1951.

Record to ROT from Mrs. Griffith Aug. 27, 1951. Old File No. 552.

NO LOG OF WELL.

Top. Bottom.

TAKEN FROM ELEVATIONS:

Sevickley Coal

239 - 246 (Est. thickness).

Pittsburgh Coal

329 - 336 (Est. thickness)

PRODUCING FROM BIG INJUR SAND ABOUT 1600 - 1700

Total depth

1700



STATE OF WEST VIRGINIA  
DEPARTMENT OF MINES  
OIL AND GAS DIVISION

552

WELL RECORD

Permit No. NON 505-A

Oil or Gas Well (KIND)


Company Hope Natural Gas Company.  
 Address 445 West Main St., Clarkburg, W. Va.  
 Farm J.K. Barrickman Acres 6  
 Location (waters) \_\_\_\_\_  
 Well No. 9586 M.D. 241 Elev. 1069  
 District Cass County Monongalia.  
 The surface of tract is owned in fee by \_\_\_\_\_  
 Address \_\_\_\_\_  
 Mineral rights are owned by \_\_\_\_\_  
 Address \_\_\_\_\_  
 Drilling commenced \_\_\_\_\_  
 Drilling completed about 1901  
 Date Shot \_\_\_\_\_ From \_\_\_\_\_ To \_\_\_\_\_  
 With \_\_\_\_\_  
 Open Flow \_\_\_\_\_ /10ths Water in \_\_\_\_\_ Inch  
 \_\_\_\_\_ /10ths Merc. in \_\_\_\_\_ Inch  
 Volume \_\_\_\_\_ Cu. Ft.  
 Rock Pressure \_\_\_\_\_ lbs. \_\_\_\_\_ hrs.  
 Oil \_\_\_\_\_ bbls., 1st 24 hrs.  
 Fresh water \_\_\_\_\_ feet \_\_\_\_\_ feet  
 Salt water \_\_\_\_\_ feet \_\_\_\_\_ feet

| Casing and Tubing | Used in Drilling | Left in Well  | Packers        |
|-------------------|------------------|---------------|----------------|
| Size              |                  |               |                |
| 16                |                  |               | Kind of Packer |
| 13                |                  |               |                |
| 10                |                  | <b>Pulled</b> | Size of        |
| 8 3/4             |                  | <b>Pulled</b> |                |
| 6 5/8             |                  | <b>Pulled</b> | Depth set      |
| 5 3/16            | <b>1500</b>      | <b>1500</b>   |                |
| 3                 |                  |               | Perf. top      |
| 2                 | <b>1700</b>      | <b>1700</b>   | Perf. bottom   |
| Liners Used       |                  |               | Perf. top      |
|                   |                  |               | Perf. bottom   |

**NOT**  
CASING CEMENTED \_\_\_\_\_ SIZE \_\_\_\_\_ No. Ft. \_\_\_\_\_ Date \_\_\_\_\_

COAL WAS ENCOUNTERED AT 239 FEET 8 1/2 INCHES  
329 FEET 8 1/2 INCHES FEET INCHES  
 FEET INCHES FEET INCHES

| Formation             | Color                     | Hard or Soft | Top        | Bottom  | Oil, Gas or Water | Depth Found | Remarks       |
|-----------------------|---------------------------|--------------|------------|---------|-------------------|-------------|---------------|
| No log of well        |                           |              |            |         |                   |             |               |
| Taken from elevations |                           |              |            |         |                   |             |               |
|                       | Sewickly Coal             |              | 239        | 246     |                   |             | Est thickness |
|                       | Pittsburgh Coal           |              | 329        | 336     |                   |             | Est thickness |
|                       | Producing from Injun sand |              | about 1600 | to 1700 |                   |             |               |
|                       | Total depth               |              |            | 1700    |                   |             |               |

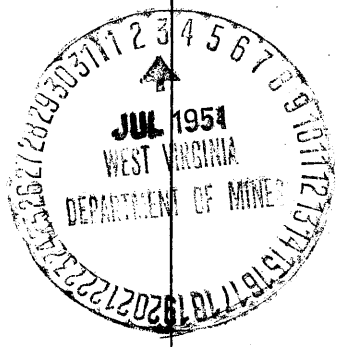

(Over) AUG 27 1951