

Company Pittsburgh & W.V. Gas Co
 Address Clarksburg W.Va
 Name John Mastfuter
 Tract Area 1.8 Lease No. 12297
 Well (Farm) No. 1 Serial No. 2022
 Elevation (Right Level) 1279.0 M
 Gasworks Mannington W.V.
 County Morgan Town Bethell
 Engineer James P. Hoff
 Engineer's Registration No. 1088

STATE OF WEST VIRGINIA
 DEPARTMENT OF MINES
 OIL AND GAS DIVISION
 CHARLESTON

WELL LOCATION MAP
 FILE NO. 2022-511A

♦ Denotes location of well on United States
 Topographic Maps, scale 1 to 62,500, the
 latitude and longitude lines being represented
 by border lines as shown.

LATITUDE 39° 42' 30"

80° 22' 08"

LONGITUDE

7.5
+



7.5 OGIS topo location

7.5' loc	<u>0.945</u>	15' loc	<u>3.825</u>
	<u>1.418</u>	(calc.)	<u>3.634</u>

Company _____

Farm _____

Quad Hundred (Mountfort, NC)

County Monongakela

District Battelle

WELL LOCATION MAP

File No. 061-514A

Battelle District, Monongalia County, W. Va.
 By Pittsburgh & W. Va. Gas Co., Clarksburg, W. Va.
 Abandoned under permit Mon-.....-A1
 On 18 acres; Mannington N/W 2-3-4.
 Elevation, 1279' L.
 Surface owned by Nancy C. Clevis, R. D. No. 1, Burton, W. Va., and
 minerals by Nancy Catherine Clevis, R. D. No. 1, Burton, W. Va.
 Drilling commenced May 30, 1913; completed July 5, 1913.
 10" casing, 214'; 8", 1555'; 6", 2290'; all left in.
 Coal was encountered at 675-679, 970-974, and 1067-1074'.
 Gas well. Record to Dept. of Mines dated Oct. 3, 1944. Stamped,
 Aug. 14, 1951.
 Record to RCT from Mrs. Griffith Feb. 29, 1952. Old File No. 564.

	Top.	Bottom.
Unrecorded	0	675
Swapsburg (Waynesburg) Coal	675	679
Unrecorded	679	970
Hopkinton (Sewickley) Coal	970	974
Unrecorded	974	1067
Pittsburgh Coal	1067	1074
Unrecorded	1074	1475
Little Dunkard Sand	1475	1500
Unrecorded	1500	1588
Big Dunkard Sand	1588	1638
Unrecorded	1638	1740
Gas Sand	1740	1800
Unrecorded	1800	1848
Salt Sand	1848	1936
Unrecorded	1936	2005
Salt Sand	2005	2067
Unrecorded	2067	2273
Big Lime	2273	2340
Big Injun Sand (gas, 2342') (gas, 2352-2354') (gas, 2405')	2340	2554
Unrecorded	2554	3008
Fifty-foot Sand	3008	3043
Unrecorded	3043	3045
Thirty-foot Sand	3045	3095
Unrecorded	3095	3100
Gordon Stray Sand (gas, 3100-3102')	3100	3121
Unrecorded	3121	3140
Gordon Sand	3140	3166
Unrecorded	3166	3205
4th Sand	3205	3249
Unrecorded	3249	3270
5th Sand	3270	3296
Unrecorded	3296	3325
Sand (hole reduced to 5" at 3339')	3325	3345
Unrecorded	3345	3471
Bayard Sand	3471	3479
Unrecorded	3479	3496
Total depth		3496



564

STATE OF WEST VIRGINIA
DEPARTMENT OF MINES
OIL AND GAS DIVISION

WELL RECORD

Permit No. MON-514-A

Oil or Gas Well **"GAS"**
(KIND)


Company Pittsburgh & West Va Gas Company.
Address Clarksburg, West Va.,
Farm John Hostutler Acres 18
Location (waters) Mann. N/W. 2-3-4
Well No. 5058 Elev. 1279' L
District Battelle County Monongalia
The surface of tract is owned in fee by Nancy C. Clovis
R.D.#1 Address Burton, W. Va.
Mineral rights are owned by Nancy Catherine Clovis
R.D.#1 Address Burton, W. Va.
Drilling commenced May 30, 1913
Drilling completed July 5th, 1913
Date Shot _____ From _____ To _____
With _____

Casing and Tubing	Used in Drilling	Left in Well	Packers
Size			
16			Kind of Packer
13			
10	<u>214'</u>	<u>214'</u>	Size of
8 1/4	<u>1555'</u>	<u>1555'</u>	
6 3/8	<u>2290'</u>	<u>2290'</u>	Depth set
5 3/16			
3			Perf. top
2			Perf. bottom
Liners Used			Perf. top
			Perf. bottom

Open Flow /10ths Water in _____ Inch
/10ths Merc. in _____ Inch
Volume _____ Cu. Ft.
Rock Pressure _____ lbs. _____ hrs.
Oil _____ bbls., 1st 24 hrs.
Fresh water _____ feet _____ feet
Salt water _____ feet _____ feet

CASING CEMENTED _____ SIZE _____ No. Ft. _____ Date _____
COAL WAS ENCOUNTERED AT 675 FEET 48 INCHES
970 FEET 48 INCHES 1067 FEET 84 INCHES
_____ FEET _____ INCHES _____ FEET _____ INCHES

Formation	Color	Hard or Soft	Top	Bottom	Oil, Gas or Water	Depth Found	Remarks
Un-recorded			0	675			
Freeport Coal			675	679			
Un-recorded			679	970			
M.T. Coal			970	974			
Un-recorded			974	1067			
Pgh. Coal			1067	1074			
Un-recorded			1074	1475			
Little Dunkard			1475	1500			
Un-recorded			1500	1588			
Big Dunkard			1588	1638			
Un-recorded			1638	1740			
Gas Sand			1740	1800			
Un-recorded			1800	1848			
Salt Sand			1848	1936			
Un-recorded			1936	2005			
Salt Sand			2005	2067			
Un-recorded			2067	2273			
Big Lime			2273	2340			
Big Injun			2340	2554	Gas	2342'	
Un-recorded			2554	3008	Gas	2352-2354'	
Fifty Foot Sand			3008	3043	Gas	2405'	
Un-recorded			3043	3045			
Thirty Foot Sand			3045	3095			
Un-recorded			3095	3100			
Gordon Stray			3100	3121	Gas	3100-3102'	
Un-recorded			3121	3140			
Gordon Sand			3140	3166			
Un-recorded			3166	3205			
4th. Sand			3205	3249			
Un-recorded			3249	3270			
5th. Sand			3270	3296			
Un-recorded			3296	3325			
Sand			3325	3345			
Un-recorded			3345	3471			
Bayard Sand			3471	3479			
Un-recorded			3479	3496			
Total Depth				3496			

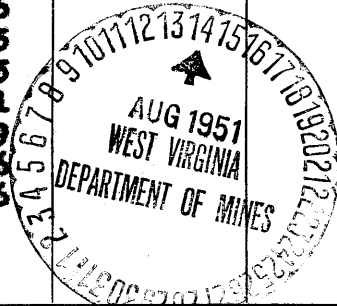

Hole reduced to 5-3/16" at 3339'

FEB 29 1952

Formation	Color	Hard or Soft	Top	Bottom	Oil, Gas or Water	Depth Found	Remarks

Date **October 3rd, 1944**, 194

PITTSBURGH & WEST VA GAS COMPANY.

APPROVED _____, Owner

By *W. H. McMaster*
(Title)

Record of Well No. 5058 Located on John Hostuttler's ex. Farm Apr. 9
Ratholle District Monongalia County W. Va.
 Division 10 District No. 11 Drilled under well Order 642
 Rig built by John Craig Began May 15 1913 Completed May 21 1913
 Well drilled by J. H. Funk Began May 30 1913 Completed July 5 1913
 Depth of Well 3496 feet Size of Hole 6 5/8 Producing Gas
 Elev: 1299 G

Cased With			REMARKS
Amount	Size	Kind	
16 ft.	13"	Wood	
2 1/4 "	10"	Old.	
555 "	8 1/4 "	"	
1000 "	8 1/4 "	New	
952 "	8 1/4 "	"	
1338 "	6 5/8 "	Old.	
2427	5"	New.	Reelined. 3068' 2" tubing 89' - 3" tubing 2427'

COAL VEINS Fairview 675-679 Mapletown 970-974 Pgh. 1067-1074.

FORMATIONS					
FORMATION	COLOR	OPEN OR CLOSE HARD OR SOFT	TOP	BOTTOM	REMARKS GAS-OIL-WATER (thickness of feet)
<u>Little Round</u>			<u>1475</u>	<u>1500</u>	<u>Gas at 1475</u>
<u>Big "</u>			<u>1688</u>	<u>1637</u>	" " "
<u>Big sand</u>			<u>1740</u>	<u>1800</u>	" " "
<u>Salt. "</u>			<u>1848</u>	<u>1936</u>	" "3011"
<u>2nd "</u>			<u>2005</u>	<u>2067</u>	<u>Water at 2005</u>
<u>Big lime</u>			<u>2273</u>	<u>2340</u>	" " "
<u>Big sand</u>			<u>2340</u>	<u>2554</u>	<u>Gas at 2340</u>
<u>Big sand</u>			<u>3008</u>	<u>3043</u>	<u>Begin drilling</u>
<u>Thin sand</u>			<u>3100 to 3102</u>	<u>3121</u>	<u>Completed</u>
<u>Hard sand</u>			<u>3140</u>	<u>3166</u>	<u>Hard sand</u>
<u>Sandstone</u>			<u>3205</u>	<u>3249</u>	<u>1/2 W 6% gas</u>
<u>Fract. "</u>			<u>3270</u>	<u>3296</u>	<u>1/2 W "</u>
<u>Fifth. "</u>			<u>3326</u>	<u>3346</u>	<u>5 W 2"</u>
<u>Sand.</u>			<u>3471</u>	<u>3471</u>	<u>5 W 2"</u>
<u>Big sand</u>					<u>Water at 3471</u>

PRESSURE TEST IN <u>6 9/8</u> CASING		REMARKS
25	lbs. 1.6	12/10 water 6 5/8" of un flow July 3-13. 1637 MCF
45	" 3.2	
75	" 4.6	June 1918. 2 W 2" 67,392 176-72 hrs.
165	" 5	
270	" 9	
300	20 14	
30	" 23	
60	" 43	
Rock Pressure	" in 126-22 hrs.	
Taken	July 3, 1913 6-16-19	
By	Sore Bradley	

WELL TUBED AND PACKED July 5 1913. 6-19-19.

VIZ: 110 lbs 2427 ft. 3" Tubg.
 1-6 5/8 X 3" Hook anchor packer.
 59 lbs 89 ft. of anchor.
 All reclaimed.

148 lbs 3068 ft. 2"
 59 lbs. 89 ft. 3"
 1-6 5/8 X 3" Hook Well Packer
 59 lbs. 89 ft. of anchor.
 1-2" R 2X.

FIRST PRESSURE TEST IN <u>3"</u> TUBING		REMARKS
30 Sec.	45 lbs. 2	
1 Min.	75 " 3	
2 "	125 " 6	
5 "	220 " 17	
10 "	260 " 34	
15 "	275 " 66	
20 "	285 " "	
Pressure	315 " in 24 hrs 358-16 hrs.	
Taken	July 6, 1913 6-19-19	
By	S. T. Bradley	

MATERIAL FOR THIS WELL RECEIVED FROM FOLLOWING SOURCES:

5000 ft. lumber old Well # 1850 Himelrich.
 1 set of rig irons " " "
 " " " timbers " " "
 300# nails stock.
 4759 ft. of lumber @ \$18.00 per M # 8746 C. Bell.
 1 partial set timbers \$35.00 John Hostuttle Sr.
 April-1919 Nail Dupon W.O. 1421
 Rig standings
 672 ft. lumber new @ \$35.23 52 Ches. C. Bradley.
 1 par. set of timbers \$20.00 John Hostuttle.
 3093 ft. of 2" 89 ft. of 3"

STATE OF WEST VIRGINIA
DEPARTMENT OF MINES
OIL AND GAS DIVISION

AFFIDAVIT OF PLUGGING AND FILLING WELL

AFFIDAVIT SHOULD BE MADE IN TEMPLATE, ONE COPY MAILED TO THE COMMISSIONER, ONE COPY TO BE KEPT BY THE WELL OPERATOR AND THE THIRD COPY, LONGER PERIODS OF SERVICE SHOULD BE MAILED TO EACH LOCAL OPERATOR AT THEIR RESPECTIVE ADDRESSES.

Ruby Catherine Glavin, Pittsburgh & West Va. Gas Company,
WELL OPERATOR OR OWNER
Barton, West Va. Clarksburg, West Va.
COUNTY WHEELING
DATE STOPPED OR CURED September 27, 1911.
WELL AND LOCATION Buttelle District
COUNTY Putnam
Ruby Catherine Glavin, Buttelle County
WELL NO. 2128
John Buchanan Firm

STATE INSPECTOR SUPERVISING PLUGGING Not Inspected

AFFIDAVIT

STATE OF WEST VIRGINIA,
County of Putnam
I, John A. Adams and Samuel A. Justice
being first duly sworn according to law depose and say that they are experienced in the work of
plugging and filling of oil and gas wells and were employed by Pittsburgh & West Va. Gas Co.
and participated in the work of plugging and filling the above well, that said well
was completed on the 27 day of September 1911. and that the well was plugged
and filled in the following manner:

DATE	DEPTH	PLUGGING MATERIAL	AMOUNT USED	REMARKS
Sept 27	100	200 lbs. cement	200	Plugged to 100 ft.
Sept 27	150	200 lbs. cement	200	Plugged to 150 ft.
Sept 27	200	200 lbs. cement	200	Plugged to 200 ft.
Sept 27	250	200 lbs. cement	200	Plugged to 250 ft.
Sept 27	300	200 lbs. cement	200	Plugged to 300 ft.
Sept 27	350	200 lbs. cement	200	Plugged to 350 ft.
Sept 27	400	200 lbs. cement	200	Plugged to 400 ft.
Sept 27	450	200 lbs. cement	200	Plugged to 450 ft.
Sept 27	500	200 lbs. cement	200	Plugged to 500 ft.
Sept 27	550	200 lbs. cement	200	Plugged to 550 ft.
Sept 27	600	200 lbs. cement	200	Plugged to 600 ft.
Sept 27	650	200 lbs. cement	200	Plugged to 650 ft.
Sept 27	700	200 lbs. cement	200	Plugged to 700 ft.
Sept 27	750	200 lbs. cement	200	Plugged to 750 ft.
Sept 27	800	200 lbs. cement	200	Plugged to 800 ft.
Sept 27	850	200 lbs. cement	200	Plugged to 850 ft.
Sept 27	900	200 lbs. cement	200	Plugged to 900 ft.
Sept 27	950	200 lbs. cement	200	Plugged to 950 ft.
Sept 27	1000	200 lbs. cement	200	Plugged to 1000 ft.

and that the work of plugging and filling said well was completed on the 27 day of
September
And further depose that such
Oaths to and subscribed before me this 15 day of October
My commission expires 15/1912
John A. Adams
Samuel A. Justice
Notary Public.
Permit No. 111-114.