

Surface owned by the Lessee William Smith, 2012 Grand  
 Street, Administration, Box 611, Morgantown, W. Va.  
 By Attorney and owned by Lessee William Smith  
 10 " " " W. C. HOFFMAN  
 All other land owned by Lessee William Smith

New Location   
 Salt Drip   
 Abandonment

Company VALLEY STEEL PRODUCTS CO.  
 Address 25 Lewis, W.Va.  
 Firm John C. Morris  
 Tract Area 18,843 Lease No.  
 Well (Farm) No. 12 Serial No.  
 Elevation (Birth Level) 1448  
 Quadrangle Blacksville  
 County Mason District Clay  
 Engineer Hubert J.

STATE OF WEST VIRGINIA  
 DEPARTMENT OF MINES  
 OIL AND GAS DIVISION  
 CHARLESTON

**WELL LOCATION MAP**  
 FILE NO. 1628.531-A

✦ Denotes location of well on United States  
 Topographic Maps, scale 1 to 62,500, in-  
 clude and longitude lines being represented  
 by border lines as shown.

15' + LATITUDE 39°40'00"

100.5002

LONGITUDE

7.5 OGIS topo location

7.5' loc	<u>0.13 S</u>	15' loc	<u>0.13 S</u>
	<u>1.30 W</u>	(calc.)	<u>1.30 W</u>

Company \_\_\_\_\_

Farm \_\_\_\_\_

Quad OSAGE (Bulle C)

County Monongahela

District Clay

WELL LOCATION MAP

File No. 061-521A

JOHN C. MORRIS NO. 12 WELL.

Clay District, Monongalia County, W. Va.  
By Valley Steel Products Co., St. Louis, Mo.  
Abandoned under permit Mon-----A7  
On 10.843 acres.

Elevation, 1446' L.

Date of completion, etc., not given.

10" casing, 8/8" (pulled); 8", 1679'; 6", 1864'; 5", 247'; 2" tubing,  
2232'.

Oil well. Record to Dept. of Mines stamped Sept. 8, 1951.

Record to ROT from Mrs. Griffith Feb. 29, 1952. Old File No. 571.

	Top.	Bottom.
Pittsburgh Coal	820	....
Top, of sand (Big Injun) (show of gas, 2190'; second pay best, 2201')	2086	....
Total depth		2232

Makes 6" per week oil 100 B. tank.

Good heavy pipe rig.

Good wood beam.

Wood wheels not much good, single tag.

Rods in well.

Note liner set at 2064'.

Note full string of 5" .

Casing set on wall packer (in 1919).



STATE OF WEST VIRGINIA  
DEPARTMENT OF MINES  
OIL AND GAS DIVISION

591

WELL RECORD

Permit No. WVON-521-A

Oil or Gas Well \_\_\_\_\_ (KIND)


Company Valley Steel Products Co.  
 Address St. Louis, Mo.  
 Farm John C. Morris Acres 10.843  
 Location (waters) \_\_\_\_\_  
 Well No. 12 Elev. 1446  
 District Clay County Monongalia  
 The surface of tract is owned in fee by \_\_\_\_\_  
 Address \_\_\_\_\_  
 Mineral rights are owned by \_\_\_\_\_  
 Address \_\_\_\_\_  
 Drilling commenced \_\_\_\_\_  
 Drilling completed \_\_\_\_\_  
 Date Shot \_\_\_\_\_ From \_\_\_\_\_ To \_\_\_\_\_  
 With \_\_\_\_\_  
 Open Flow \_\_\_\_\_ /10ths Water in \_\_\_\_\_ Inch  
 \_\_\_\_\_ /10ths Merc. in \_\_\_\_\_ Inch  
 Volume \_\_\_\_\_ Cu. Ft.  
 Rock Pressure \_\_\_\_\_ lbs. \_\_\_\_\_ hrs.  
 Oil \_\_\_\_\_ bbls., 1st 24 hrs.  
 Fresh water \_\_\_\_\_ feet \_\_\_\_\_ feet  
 Salt water \_\_\_\_\_ feet \_\_\_\_\_ feet

Casing and Tubing	Used in Drilling	Left in Well	Packers
Size			
16			Kind of Packer
13			
10	<b>848</b>	<b>Pulled</b>	Size of
8 1/4	<b>1679</b>	<b>1679</b>	
6 1/2	<b>1864</b>	<b>1864</b>	Depth set
5 3/16	<b>247</b>	<b>247</b>	
3			Perf. top
2	<b>2232</b>	<b>2232</b>	Perf. bottom
Liners Used			Perf. top
			Perf. bottom

CASING CEMENTED \_\_\_\_\_ SIZE \_\_\_\_\_ No. Ft. \_\_\_\_\_ Date \_\_\_\_\_

COAL WAS ENCOUNTERED AT \_\_\_\_\_ FEET \_\_\_\_\_ INCHES  
 \_\_\_\_\_ FEET \_\_\_\_\_ INCHES FEET \_\_\_\_\_ INCHES  
 \_\_\_\_\_ FEET \_\_\_\_\_ INCHES FEET \_\_\_\_\_ INCHES

Formation	Color	Hard or Soft	Top	Bottom	Oil, Gas or Water	Depth Found	Remarks
Pittsburgh Coal			820				
Top of Sand			2086				
Show of oil			2190				
Second pay best			2201				
Total Depth				2232			
Makes 6" per week oil							100 B. tank
Good heavy pipe rig							
Good wood beam							
Wood wheels not much good,							single tug
Rods in well.							
Note liner set at 2064							
Note full string of 5 3/16"							
Casing set on wall packer (in 1919)							

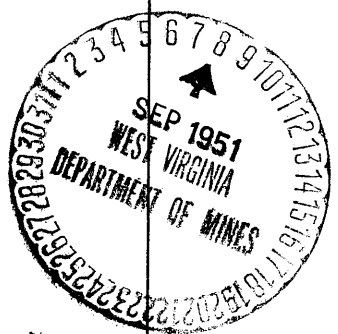

(Over)

SEP 29 1952

STATE OF WEST VIRGINIA  
DEPARTMENT OF MINES  
OIL AND GAS DIVISION

WELL RECORD

Permit No. \_\_\_\_\_

Oil or Gas Well \_\_\_\_\_

Company Valley Steel Products Company  
 Address Sh. Leoda, W. Va.  
 Firm John S. Morris Area 10.563  
 Location (owners) Hall's Run  
 Well No. Slav 418 No. 1144  
 District Slav County Monroe  
 The surface of tract is owned in fee by \_\_\_\_\_  
 Address \_\_\_\_\_  
 Mineral rights are owned by \_\_\_\_\_  
 Address \_\_\_\_\_  
 Drilling commenced \_\_\_\_\_  
 Drilling completed \_\_\_\_\_  
 Date Shot From To \_\_\_\_\_  
 With \_\_\_\_\_  
 Open Flow /100th Water in \_\_\_\_\_  
 /20th Max. in \_\_\_\_\_  
 Volume \_\_\_\_\_ Cu. Ft.  
 Rod Pressure \_\_\_\_\_ lbs.  
 Oil \_\_\_\_\_ lbs. at 24 hrs.  
 Fresh water \_\_\_\_\_ feet  
 Salt water \_\_\_\_\_ feet

Casing and Tubing	Used in Drilling	Left in Well	Feet
2 1/2"			Kind of Packer
2"			
1 1/2"	267'	267'	Kind of
1 1/4"	1679'	1679'	
1 1/8"	1864'	1864'	Depth set
1 1/16"	267'	267'	
2"			Foot top
2"	2238'	2238'	Foot bottom
Lines Used			Foot top
			Foot bottom

CASING CEMENTED \_\_\_\_\_ INCH No. Ft. \_\_\_\_\_

COAL WAS ENCOUNTERED AT FEET \_\_\_\_\_ INCHES  
 FEET \_\_\_\_\_ INCHES FEET \_\_\_\_\_ INCHES  
 FEET \_\_\_\_\_ INCHES FEET \_\_\_\_\_ INCHES

Formation	Color	Start or End	Top	Bottom	Oil, Gas or Water	Depth Feet	Remarks
Pittsburgh Coal			820				
Top of Sand			2056'				
Show of Oil			2190				
Second day - hard			2201				
Total Depth				2238'			
Note - liner set at 2056' Note full string of 5-3/16" Casing set on well packer (in 1919)							



STATE OF WEST VIRGINIA  
DEPARTMENT OF MINES  
OIL AND GAS DIVISION

NOTICE OF INTENTION TO PLUG AND ABANDON WELL

ISSUED BY SECTION 5, ARTICLE 4, CHAPTER 22 OF THE CODE

To The Department of Mines,  
Charleston, W. Va.

Christopher Paul Sawyer  
OIL OPERATOR OF OIL WELL  
c/o S Co. S. Flagg, Chief Eng.  
Birmingham, N. Va.

\_\_\_\_\_

\_\_\_\_\_

\_\_\_\_\_

\_\_\_\_\_

WILLIAM JAMES JENNINGS  
OIL OPERATOR

c/o Wayne S. Flagg  
P. O. Box 1111 - Co. Charleston, N. Va.

SEPTEMBER 4, 1928 IS --  
WELL TO BE ABANDONED

State

County

Well No. 10

Foot

**NOTE: INSURE CLERK V. LINDSAY - HUNTING - TELEPHONE 5127**  
**IS HERE IN ADVANCE OF PLUGGING INFO**  
The undersigned well operator is about to abandon the above described well and will commence

the work of plugging and abandoning said well on the \_\_\_\_\_ day of \_\_\_\_\_, 19\_\_ (which date shall not be less than five days after the day on which this notice as mailed is received, or in due course should be received by the Department of Mines.)

This notice is given you in order that your respective representations may be present at the plugging and filling of said well. You are further notified that whether you are represented or not represented the undersigned will proceed on that date, or shortly thereafter, to plug and fill said well in the manner required by Section 14, Article 4, Chapter 22 of the Code and given in detail on the reverse side of this notice, in "Work Order."

This notice is being mailed by registered mail to each of you at the above addresses on the above date.

Very truly yours,

WILLIAM JAMES JENNINGS  
Well Operator.



**NOTE:** The Department of all wells drilled prior to June 1, 1928, a plat prepared by a competent engineer, showing the location and capacity in which the well is located, the point and bearing of location to corner, and the location of the shaft or its abandoned well, shall be submitted with this notice.