

New Location   
 Old Deepen   
 Abandonment

OLD NEWS FARM #12

Company	<u>NOPE NATURAL GAS CO</u>
Address	<u>CLARKSBURG, W. VA.</u>
Form	<u>J. H. Hagan</u>
Tract	<u>Area 2</u>
Lease No.	<u>2365</u>
Well (Form) No.	<u>2365</u>
Elevation (Spot Level)	<u>2365</u>
Geographic	<u>Mountain</u>
County	<u>MORGAN</u>
Engineer	<u>[Signature]</u>
Engineer's Registration No.	<u>2365</u>

STATE OF WEST VIRGINIA  
 DEPARTMENT OF MINES  
 OIL AND GAS DIVISION  
 CHARLESTON

**WELL LOCATION MAP**  
 FILE NO. NOPE-2365

+ Denotes location of well on United States Topographic Map, scale 1 to 62,500, latitude and longitude lines being represented by border lines as shown.

- Denotes one tenth acres on border line

LATITUDE 39°42'30"

80°17'30"

LONGITUDE

75'  
+

7.5 OGIS topo location

7.5' loc	<u>0.895</u>	15' loc	<u>3.775</u>
	<u>1.100</u>	(calc.)	<u>3.320</u>

Company \_\_\_\_\_

Farm \_\_\_\_\_

Quad Wadestown (Manston NE)

County Monongahela

District Battelle

WELL LOCATION MAP

File No. 061-524A

Battelle District, Monongalia County, W. Va.  
 By Hope Natural Gas Co., 445 W. Main St., Clarksburg, W. Va.  
 Abandoned under permit Mon-.....-A7  
 On 51 acres.  
 Elevation, 1043' L.  
 Drilling commenced Nov. 24, 1911; completed Feb. 16, 1912.  
 Salt water at 1745'.  
 10" casing, 1327' (pulled); 8½", 1810' (pulled); 6⅝", 2201'; 5⅜", 2862';  
 4½" liner, 201'.  
 Casing not cemented.  
 Coal was encountered at 798-808'.  
 Gas well. Record to Dept. of Mines dated Sept. 6, 1951.  
 Record to RCT from Mrs. Griffith Jan. 16, 1952. Old File No. 563.

	Top.	Bottom.
Pittsburgh Coal	798	808
Dunkard Sand	1150	1380
Salt Sands (water, 1745')	1655	1932
Big Injun Sand (show oil and gas, 2135')	2105	2325
Gantz Sand	2620	2643
Fifty-foot Sand (gas, 2727')	2717	2757
Thirty-foot Sand	2776	2800
Gordon Sand	2880	2923
Fourth Sand (oil and gas, 2973')	2969	3027
Fifth Sand (gas, 3063')	3060	3085
Bayard Sand (show oil and gas, 3212')	3216	3218
Total depth		3300
Filled back to		3132



STATE OF WEST VIRGINIA  
DEPARTMENT OF MINES  
OIL AND GAS DIVISION

563

WELL RECORD

Permit No. MON-524-A


~~Rock~~ Gas Well (KIND)

Company Hope Natural Gas Company.  
Address 445 West Main St. Clarksburg, W. Va.  
Farm J.H. Hagan Acres 51  
Location (waters) \_\_\_\_\_  
Well No. 2365 Elev. 1043  
District Bayelle County Monongalia  
The surface of tract is owned in fee by \_\_\_\_\_  
Address \_\_\_\_\_  
Mineral rights are owned by \_\_\_\_\_  
Address \_\_\_\_\_  
Drilling commenced Nov. 24, 1911  
Drilling completed Feb, 16, 1912  
Date Shot \_\_\_\_\_ From \_\_\_\_\_ To \_\_\_\_\_  
With \_\_\_\_\_  
Open Flow \_\_\_\_\_ /10ths Water in \_\_\_\_\_ Inch  
\_\_\_\_\_ /10ths Merc. in \_\_\_\_\_ Inch  
Volume \_\_\_\_\_ Cu. Ft.  
Rock Pressure \_\_\_\_\_ lbs. \_\_\_\_\_ hrs.  
Oil \_\_\_\_\_ bbls., 1st 24 hrs.  
Fresh water \_\_\_\_\_ feet \_\_\_\_\_ feet  
Salt water 1745 feet \_\_\_\_\_ feet

Casing and Tubing	Used in Drilling	Left in Well	Packers
Size			Kind of Packer
16			
13			
10	1327	Pulled	Size of
8 1/4	1810	Pulled	
6 5/8	2101	2101	Depth set
5 3/16	2862	2862	
3 1/2 liner	201	201	Perf. top
2			Perf. bottom
Liners Used			Perf. top
			Perf. bottom

**Net**  
CASING CEMENTED \_\_\_\_\_ SIZE \_\_\_\_\_ No. Ft. \_\_\_\_\_ Date \_\_\_\_\_  
COAL WAS ENCOUNTERED AT 798 FEET 120 INCHES  
\_\_\_\_\_ FEET \_\_\_\_\_ INCHES \_\_\_\_\_ FEET \_\_\_\_\_ INCHES  
\_\_\_\_\_ FEET \_\_\_\_\_ INCHES \_\_\_\_\_ FEET \_\_\_\_\_ INCHES

Formation	Color	Hard or Soft	Top	Bottom	Oil, Gas or Water	Depth Found	Remarks
Pittsburgh Coal			798	808			
Dunkard			1190	1380			
Salt sands			1655	1932	water	1745	
Injun			2105	2325	show oil gas	2135	
Gantz			2620	2643			
Fifty foot		6	2717	2757	gas	2727	
Thirty foot			2776	2800			
Gordon			2880	2923			
Fourth			2969	3027	oil gas	2973	
Fifth			3060	3085	gas	3063	
Bayard			3216	3218	show oil gas	3212	
Total depth				3300			
Filled back to				3132			

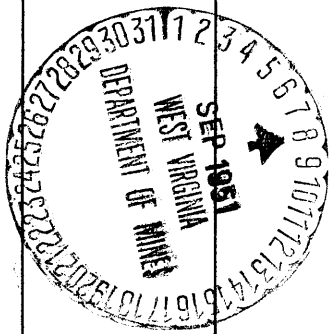

Formation	Color	Hard or Soft	Top	Bottom	Oil, Gas or Water	Depth Found	Remarks

Date September 6, 1951, 19\_\_

APPROVED Hope Natural Gas Company, Owner

By \_\_\_\_\_

(Title) 

**AFFIDAVIT OF PLUGGING AND FILLING WELL**

AFFIDAVIT SHOULD BE MADE IN TRIPLICATE. ONE COPY MAILED TO THE DEPARTMENT, ONE COPY TO BE RETURNED BY THE WELL OPERATOR AND THE THIRD COPY (AND EXTRA COPIES IF REQUIRED) SHOULD BE MAILED TO EACH SEAL OPERATOR AT THEIR RESPECTIVE ADDRESSES.

**No seal operations.**

WELL OPERATOR OR OWNER: Hope Natural Gas Company,  
NAME OF WELL OPERATOR

ADDRESS: 115 West Main St., Clarkburg, W. Va.  
COMPLETE ADDRESS

WELL AND LOCATION: IS

District: Rattelle,

County: Monongalia,

Well No. 2361

J.H. Hagan Farm

STATE INSPECTOR SUPERVISING PLUGGING

**AFFIDAVIT**

STATE OF WEST VIRGINIA,

County of Monongalia

George F. Freeland

and Judson Mett

being first duly sworn according to law depose and say that they are experienced in the work of plugging and filling of oil and gas wells and were employed by Hope Natural Gas Co. well operator, and participated in the work of plugging and filling the above well, that said work was commenced on the 30th day of AUGUST, 1951, and that the well was plugged and filled in the following manner:

GAS OR OIL BEING STOPPED	FILLING MATERIAL		PLUGS USED	GASOL	
	QUANTITY	FROM TO		SIZE & KIND	ODD SIZES
Native Coal 445-450	Acquagel	3258 3272			
Fgh. Coal 790-800	Cement	2872 2882		70	
Little Dunk 1150-1170	Acquagel	2862 2111		7 1/2"	120 7'
Big Dunk. 1271-1280	Cement	2111 2101			
Gas Sand 1427-1430	Acquagel	2101 1630			
1st Salt 1625-1625	Cement	1625 1625		200 1'	24 1'
2nd Salt 1770-1845	Acquagel	1625 828			
Mason 1905-1925	Cement	828 770		4" x 4" LINES	
Little Line 2000-2020	Acquagel	770 100		None	" 20 1'
Pencil Cave 2020-2025	Cement	100 90			
Big Line 2025-2100	Acquagel	90	Surf 200		
Injun 2100-2220					
Ganta 2210-2245	Cement plug placed at 100'				
50 ft. 2711-2720	added to W.O. by wash Newell				
30 ft. 2775-2800	9-11-51.				
Cor. Mary 2825-2825					
Cor. Ann 2825-2825					
4th Ann 2825-2825					
5th Ann 2825-2825					
Raymond 2815-2815					
Total Depth 2825					

DESCRIPTION OF WORK DONE  
 Concrete Well Inaugural erected over top of hole marked H.N.G.Co. Well # 2365



I declare that the work of plugging and filling of the above well was completed on the 2nd day of October

And further deponents with me

Sworn to and subscribed before me this 23 day of October

My commission expires:

July 22, 1956

G. F. Freeland  
Judson Mett  
James W. [Signature]  
 Notary Public

Permit No. 1111-24