


Oct 532A

Latitude 39 40

Longitude 80 05

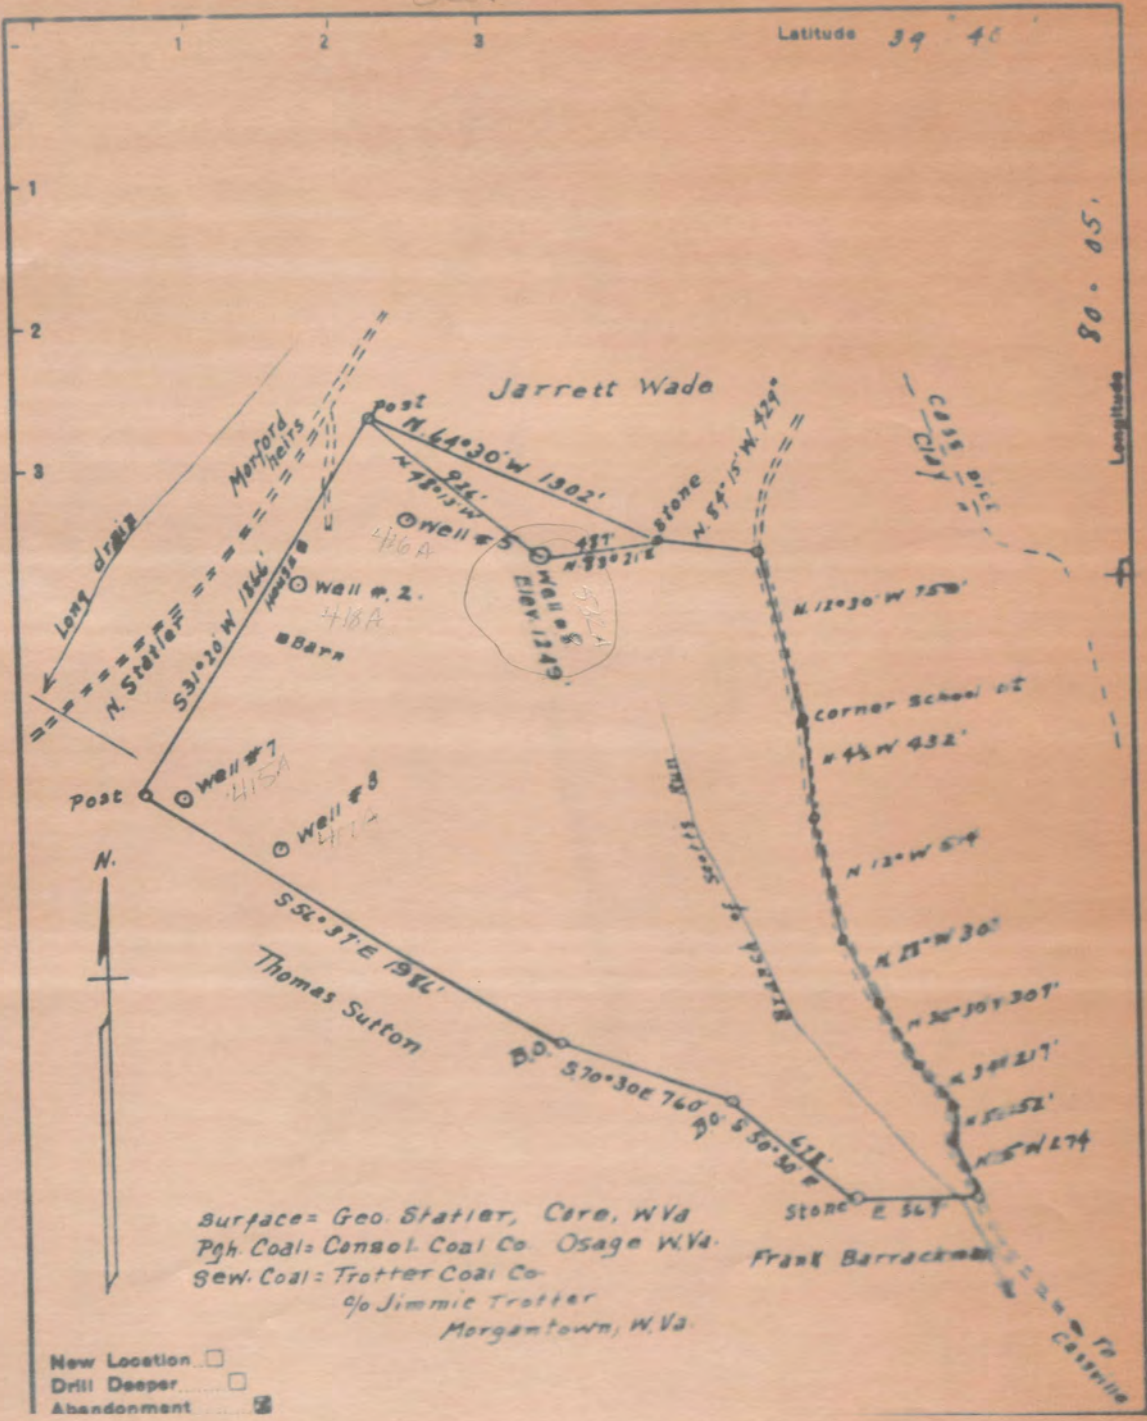

LATITUDE 39°42'30"

00' 50" 08"



1.25s
.05w

LONGITUDE

Gas
Oil well
Total depth 2149'

7'5 OGIS topo location

7.5' loc 1.258 15' loc 3.825
 .05 W (calc.) 0.01 W

Company Valley Steel Products

Farm C.C. Cove 8

Quad Osage (Bulle NC)

County Monongalia

District CASS

WELL LOCATION MAP

File No. 061-532A

