



Company RIMMER JOHNSON

Address HAMLIN, W. VA.

For MARY SWYDER, ET AL.

Treat Acres 224 Lease No. 57

Well (Form) No. 1 Serial No. 2

Elevation (Spirit Level) 1982

Geodangle BLACKSVILLE

County MORGAN District GRANT

Engineer PAUL E. JOACHIM

Engineer's Registration No. 662

File No. _____ Drawing No. _____

Jan. 12, 1932 Scale 1" = 400'

STATE OF WEST VIRGINIA
DEPARTMENT OF MINES
OIL AND GAS DIVISION
CHARLESTON

WELL LOCATION MAP

FILE NO. MAN-537-2

• Denotes location of well on United States Topographic Map, scale 1 to 62,500, latitude and longitude lines being represented by border lines as shown.

— Denotes one inch spaces on border line of original tracing.

LATITUDE 39°37'30"

80°07'30"

LONGITUDE

7.5'

7.5 OGIS topo location

7.5' loc	<u>1.80S</u>	15' loc	<u>4.68S</u>
	<u>0.08W</u>	(calc.)	<u>2.30W</u>

Company _____

Farm _____

Quad Grant Town

County Monongahela

District GRANT

WELL LOCATION MAP

File No. 061-537A

Grant District, Monongalia County, W. Va.

By Wilkes & Jackson, Merlin, W. Va.

Abandoned under permit No.-A?

On 2 3/4 acres.

Elevation, 1087' l.

Drilling commenced Dec. 16, 1915; completed Jan. 29, 1916.

Volume, 1,500,000 cu. ft.

10" casing, 310'; 8 1/2", 1200'; 6 3/4", 1326'; all left in.

Gas well. Record to Dept. of Mines stopped Jan. 18, 1952.

Record to MCF from Mrs. Griffith July 9, 1952. G. P. No. 5811.

	Top.	Bottom.
Line (water at 25')	20	100
Sand (show of oil)	200	220
Mapleton (Sewickley) Coal	222	225
Pittsburgh Coal	310	317
Little Bankard Sand (show of oil)	680	704
Big Bankard Sand	783	808
Gas Sand	905	955
1st Salt Sand	1110	1156
2nd Salt Sand	1175	1225
3rd Salt Sand	1277	1310
Little Line	1555	1570
Pencil Core	1570	1575
Big Line	1575	1660
Big Injan Sand (show of oil at 1800', oil)	1660	1808
Squaw Sand	1885	1950
Centre Sand (gas at 2192-2194-2200' (oil at 2200', good for 10 hrs.)	2191	2209
Total depth		2209



STATE OF WEST VIRGINIA
DEPARTMENT OF MINES
OIL AND GAS DIVISION

581

Permit No. MD N-537-A

WELL RECORD

Oil or Gas Well _____ (KIND)

Company Wilhelm and Jackson
 Address Hamlin, W. Va.
 Farm Mary Snyder et al Acres 23 1/2
 Location (waters) _____
 Well No. 1, Serial 5 Elev. 1083.'
 District Grant County Monongalia
 The surface of tract is owned in fee by _____
 Address _____
 Mineral rights are owned by _____
 Address _____
 Drilling commenced December 16, 1915
 Drilling completed January 29, 1916
 Date Shot _____ From _____ To _____
 With _____
 Open Flow /10ths Water in _____ Inch
 /10ths Merc. in _____ Inch
 Volume 1,500,000 Cu. Ft.
 Rock Pressure _____ lbs. _____ hrs.
 Oil _____ bbls., 1st 24 hrs.
 Fresh water _____ feet _____ feet
 Salt water _____ feet _____ feet

Casing and Tubing	Used in Drilling	Left in Well	Packers
Size			Kind of Packer
16			
13			
10	310'	310'	Size of
8 1/4	1204'	1204'	
6 5/8	1326'	1326'	Depth set
5 3/16			
3			Perf. top
2			Perf. bottom
Liners Used			Perf. top
			Perf. bottom


CASING CEMENTED _____ SIZE _____ No. Ft. _____ Date _____

COAL WAS ENCOUNTERED AT _____ FEET _____ INCHES

_____ FEET _____ INCHES FEET _____ INCHES

_____ FEET _____ INCHES FEET _____ INCHES

Formation	Color	Hard or Soft	Top	Bottom	Oil, Gas or Water	Depth Found	Remarks
Line			20	100	water at 25'		
Sand			200	220	show of oil		
Mapletown Coal			222	225			
Pittsburgh Coal			310	317			
Little Dunkard Sand			680	704	show of oil		
Big Dunkard			783	808			
Gas Sand			905	955			
1st Salt Sand			1110	1156			
2nd Salt Sand			1175	1225			
3rd. Salt Sand			1277	1310			
Little line			1555	1570			
Pencil Cave			1570	1575			
Big Line			1575	1660			
Big Injun			1660	1808	show of oil at 1800' - Steel L. M.		
Squaw Sand			1885	1950			
Gantz Sand			2191	2209	Gas at 2192'-2194'-2200'		
Total Depth				2209	Oil at 2200', good for 10 b ls.		

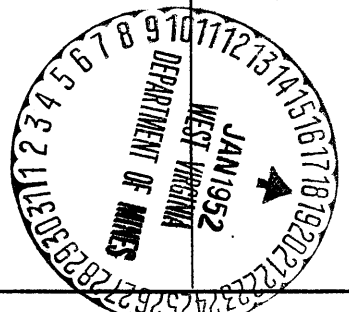

(Over)

91852

DEPARTMENT OF MINES
 OIL AND GAS DIVISION

AFFIDAVIT OF PLUGGING AND FILLING WELL

 AFFIDAVIT SHOULD BE MADE IN TRIPLICATE, ONE COPY MAILED TO THE DEPARTMENT, ONE COPY TO BE RETURNED BY THE
 WELL OPERATOR AND THE OTHER COPY, AND EXTRA COPIES IF REQUIRED, SHOULD BE MAILED TO EACH LOCAL OPERATOR AT THEIR RESPECTIVE
 ADDRESSES.

CONSOLIDATION COAL COMPANY	WILHELM AND JACKSON
FAIRMONT, W. VA.	HAMLIN, W. VA.
	FEBRUARY 11, 19 00
	WELL AND LOCATION
	GRANT District
	MORONGALIA County
	Well No. 1, SERIAL B
	MARY SWYDER, ET AL Firm
STATE INSPECTOR SUPERVISING PLUGGING	D. F. DESIST - FAIRMONT - TEL. 8961

AFFIDAVIT

STATE OF WEST VIRGINIA.

County of LEE

George Adams

and

James A. Taylor

being first deponents according to law depose and say that they are experienced in the work of
 plugging and filling oil and gas wells and were employed by Wilhelm & Jackson
 well operator, and participated in the work of plugging and filling the above well, that said work
 was completed on the 30 day of January, 19 00, and that the well was plugged
 and filled in the following manner:

DEPTH OR DEPTH RANGE	FILLING MATERIAL	PLUGGED DEPTH	REMARKS
300'	Best cement and 3' crushed stone on bridge, filled with clay to 300', best cement 300' to 200', 3' crushed stone on cement plug - sealing hole completely to low water level.	200'	
200'	Best cement and 3' crushed stone on bridge, filled with clay to 100' - 2' below 2-1/2" casing, seal cement 100' - 100' 1' crushed stone on cement plug - sealing all sands below Salt Sands and 2-1/2" casing. 100'	100'	
100'	PERMANENT BRIDGE AT CASINO SHAY (1204'), 3' best cement and 3' crushed stone on bridge, filled with clay to 50' - 50' above salt sands, best cement 50' - 50' - SET A PERMANENT BRIDGE AT 50' - top of the Dunk. rd. 3' best cement and 3' crushed stone on bridge, filled with clay to 20' - 20' above Little Dunkard, seal cement 20' - 20' 1' crushed stone on cement and filled with clay to 0' - 10' of 1" casing was left in the hole (cemented in) for a vent to the surface as a precaution to the coal seams. At the surface, the outlet pipe was equipped with a device to permit the free passage of gas and prevent obstruction.	0'	
	Specified such as is described in Rule 10, 1901 Co. Statutes.		
COAL SEAM			DESCRIPTION OF SEAM
DEPTH			W. & J.
DEPTH			Well No.
DEPTH			Date of Abandonment

and that the work of plugging and filling said well was completed on the 30 day of February, 19 00.

And further deponents saith not.

Sworn and subscribed before me this

day of February, 19 00.

My commission expires

Aug 4, 1905


 Notary Public
 Permit No. 808-007