

New Location...
 Drill Deeper.....
 Abandonment.....

MAP SH. 13: 50. N. 13 E. 30: F.B. 1075 P. 1-2.

Company HOPE NATURAL GAS CO.
 Address CLARKSBURG, W.VA.
 Farm MARY W. LOUGH
 Tract _____ Acres 51 Lease No. 2881
 Well (Farm) No. _____ Serial No. 2665
 Elevation (Spirit Level) 1310'
 Quadrangle BLACKSVILLE
 County MONONGALIA District GRANT
 Engineer Guy H. Bradley
 Engineer's Registration No. 2425
 File No. _____ Drawing No. _____
 Date FEB. 26, 1953 Scale 1" = 20 POLES

STATE OF WEST VIRGINIA
 DEPARTMENT OF MINES
 OIL AND GAS DIVISION
 CHARLESTON

WELL LOCATION MAP
 FILE NO. MON-565-A

+ Denotes location of well on United States Topographic Maps, scale 1 to 62,500, latitude and longitude lines being represented by border lines as shown.

- Denotes one inch spaces on border line of original tracing.



STATE OF WEST VIRGINIA
DEPARTMENT OF MINES
OIL AND GAS DIVISION

599

WELL RECORD

Permit No. 565A

Oil Gas Well (KIND)


Company Hope Natural Gas Company.
Address 445 West Main St. Clarksburg, W. Va.
Farm Mary W. Lough Acres 51
Location (waters) _____
Well No. 2665 Elev. _____
District Grant, County Monongalia.
The surface of tract is owned in fee by _____
Address _____
Mineral rights are owned by _____
Address _____
Drilling commenced July 29, 1912
Drilling completed November 4, 1912
Date Shot _____ From _____ To _____
With _____
Open Flow _____ /10ths Water in _____ Inch
_____ /10ths Merc. in _____ Inch
Volume _____ Cu. Ft.
Rock Pressure _____ lbs. _____ hrs.
Oil _____ bbls., 1st 24 hrs.
Fresh water 235 feet _____ feet
Salt water 1600 1620 feet _____ feet

Casing and Tubing	Used in Drilling	Left in Well	Packers
Size			
16			Kind of Packer
13			
10	643	643	Size of
8 1/4	1430	1430	
6%	1850	1850	Depth set
5 3/16	1975	1975	
3			Perf. top
2			Perf. bottom
Liners Used			Perf. top
			Perf. bottom

CASING CEMENTED 10 SIZE 643 No. Ft. July 1912

COAL WAS ENCOUNTERED AT 142 FEET 48 INCHES
235 FEET 96 INCHES 575 FEET 96 INCHES
FEET INCHES FEET INCHES

Formation	Color	Hard or Soft	Top	Bottom	Oil, Gas or Water	Depth Found	Remarks
Coal			142	146			
Coal			235	243	water	235	
Pitts. Coal			575	583			
Big Dunkard			1205	1230			
Gas sand			1255	1284			
First Salt			1410	1423			
Second Salt			1430	1633	water	1600 1620	
Little Lime			1812	1828			
Pencil cave			1828	1833			
Big Lime			1833	1900			
Big Injun			1900	1985			
Squaw			2000	2040	gas	2010	
Gantz			2434	2490	gas	2438	
Thirty Foot			2529	2561	gas	2451	
Fourth			2880	2892			
Fifth			2940	2948			
Total depth				3168			
Filled back to				2465			

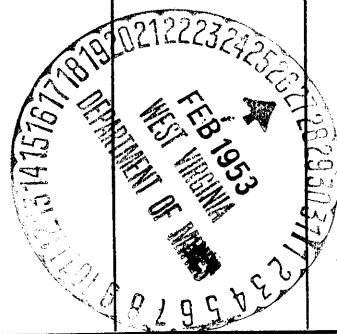

Formation	Color	Hard or Soft	Top	Bottom	Oil, Gas or Water	Depth Found	Remarks

Date February 25, 1953., 19__

APPROVED Hope Natural Gas Company., Owner

By _____

(Title) *JNJ*