


Latitude 39° 40'

Longitude 80° 00'

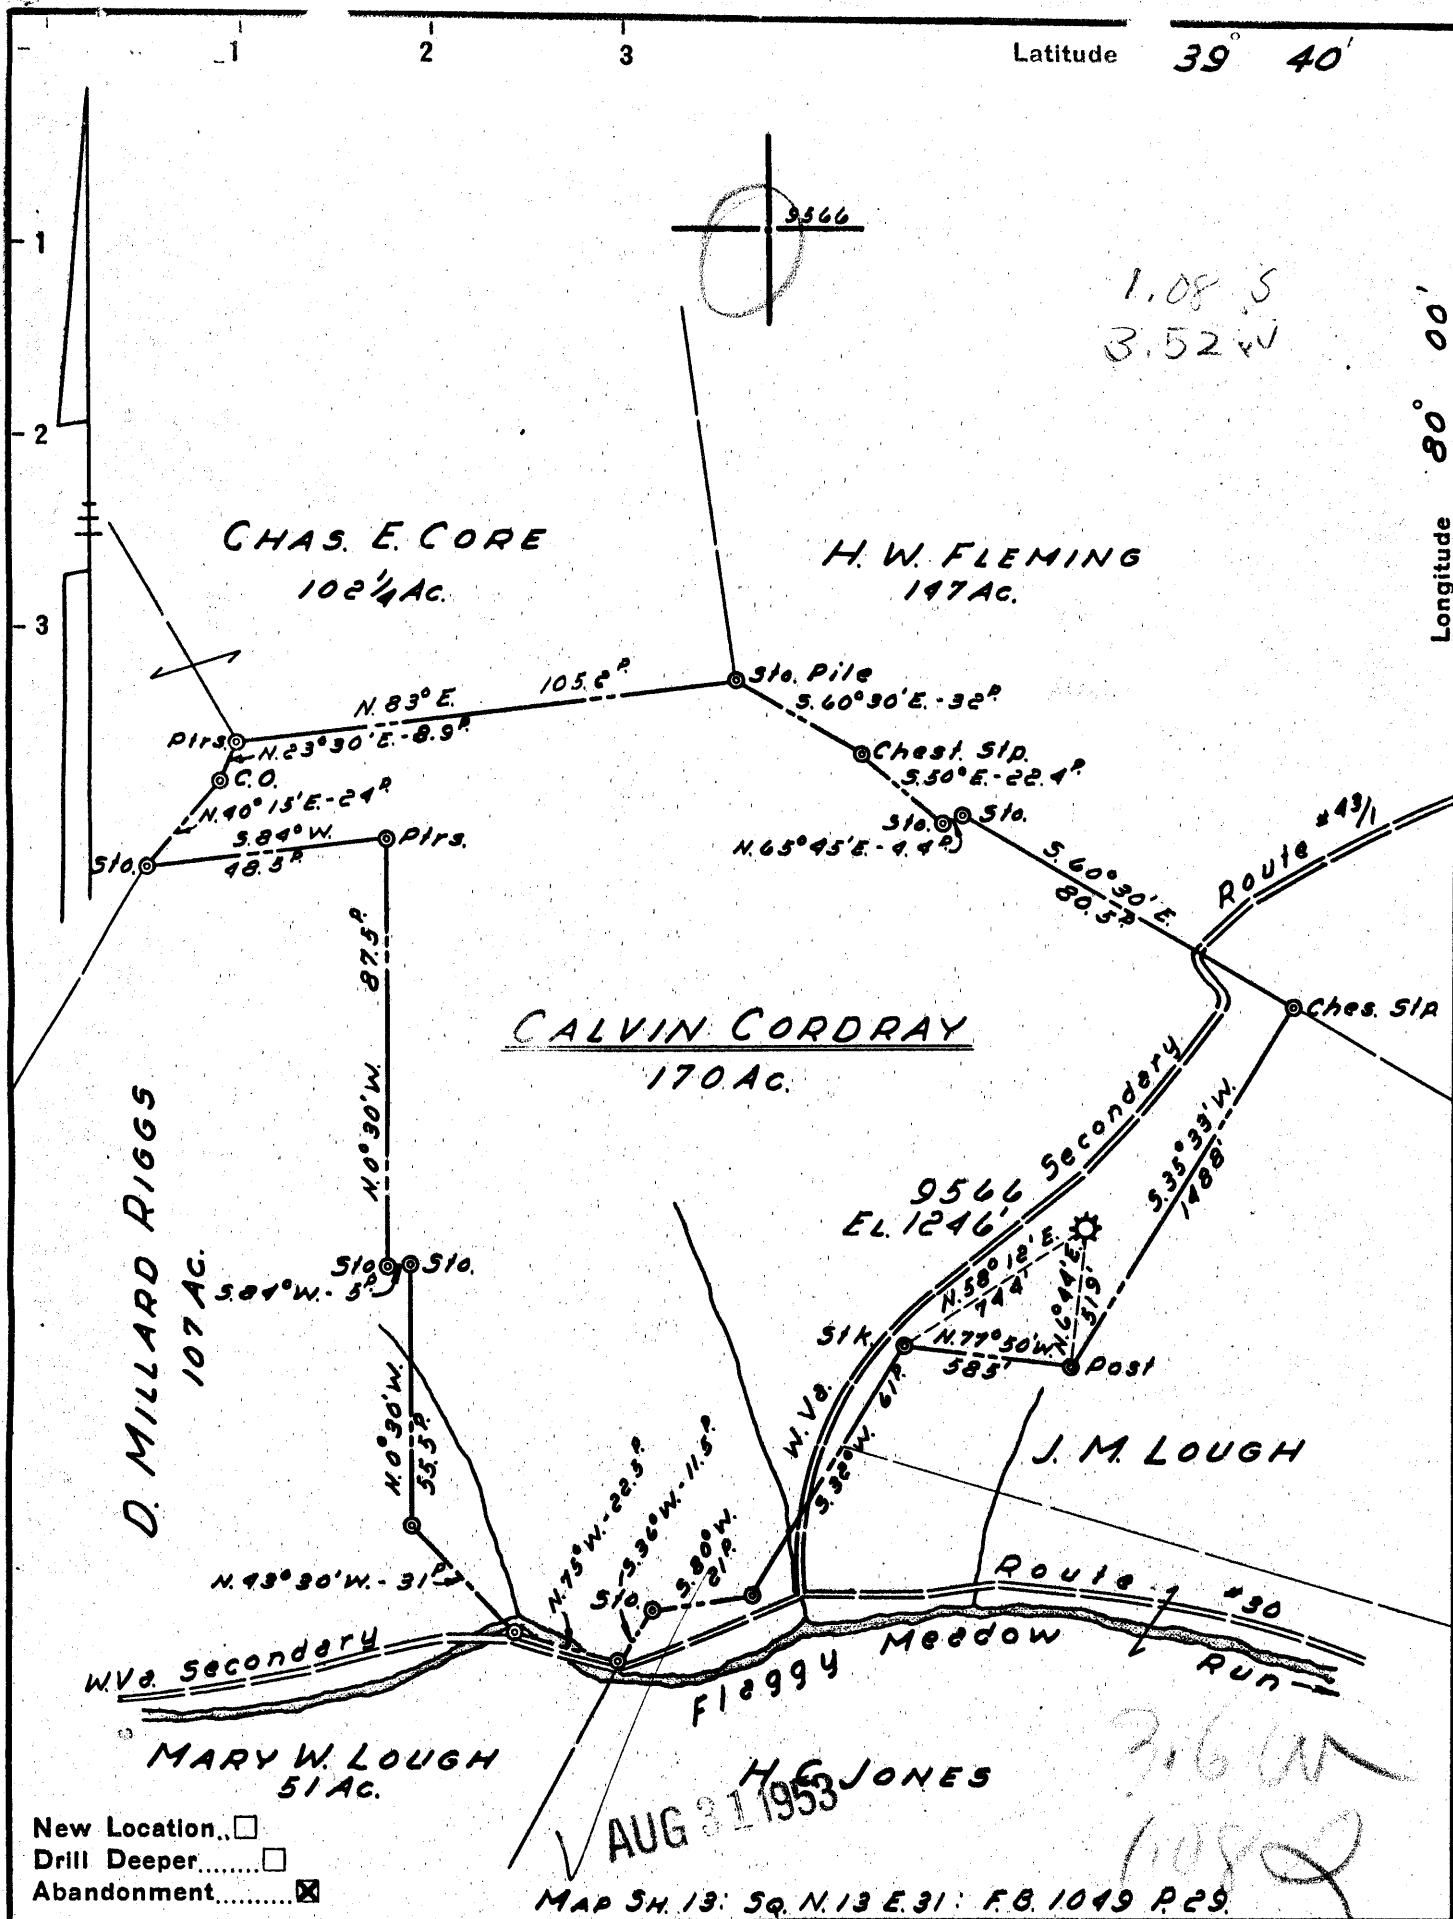

1.08 S
3.52 W

3.6 W
1.08 S

- New Location...
- Drill Deeper.....
- Abandonment.....

MAP SH. 13: SQ. N. 13 E. 31: F.B. 1049 P. 29

Company	HOPE NATURAL GAS CO.
Address	CLARKSBURG, W.VA.
Farm	CALVIN GORDRAY
Tract	Acres 170 Lease No. 61866
Well (Farm) No.	Serial No. 9566
Elevation (Spirit Level)	1246'
Quadrangle	BLACKSVILLE
County	MONONGALIA District GRANT
Engineer	Guy H. Bradley
Engineer's Registration No.	2425
File No.	Drawing No.
Date	AUG. 12 1953 Scale 1" = 40 POLES

STATE OF WEST VIRGINIA
DEPARTMENT OF MINES
OIL AND GAS DIVISION
CHARLESTON

WELL LOCATION MAP
FILE NO. MON-567-A

- + Denotes location of well on United States Topographic Maps, scale 1 to 62,500, latitude and longitude lines being represented by border lines as shown.
- Denotes one inch spaces on border line of original tracing.

CALVIN GORDRAY M. 9566 — HOPE N. G. Co. — MON-567-A



STATE OF WEST VIRGINIA
DEPARTMENT OF MINES
OIL AND GAS DIVISION

WELL RECORD

623

Permit No. 567-A


Gas Well (KIND)

Company Hope Natural Gas Company
Address 445 West Main St. Clarksburg, W.Va.
Farm Calvin Cordray Acres 170
Location (waters) _____
Well No. 9566 Elev. 1246'
District Grant County Monongalia
The surface of tract is owned in fee by _____
Address _____
Mineral rights are owned by _____
Address _____
Drilling commenced _____
Drilling completed August 22, 1912
Date Shot _____ From _____ To _____
With _____
Open Flow _____ /10ths Water in _____ Inch
_____ /10ths Merc. in _____ Inch
Volume _____ Cu. Ft.
Rock Pressure _____ lbs. _____ hrs.
Oil None _____ bbls., 1st 24 hrs.
Fresh water None _____ feet _____ feet
Salt water 1420' _____ feet _____ feet

Casing and Tubing	Used in Drilling	Left in Well	Packers
Size			
16			Kind of Packer
13			
10			Size of
8 3/4			
6 5/8	1782	1782	Depth set
5 3/16			
3			Perf. top
2	XXXX	XXXX Pulled	Perf. bottom
Liners Used			Perf. top
			Perf. bottom

CASING CEMENTED _____ SIZE _____ No. Ft. _____ Date _____
No cementing
COAL WAS ENCOUNTERED AT 406 FEET 60 INCHES
492 FEET 96 INCHES FEET INCHES
FEET INCHES FEET INCHES

Formation	Color	Hard or Soft	Top	Bottom	Oil, Gas or Water	Depth Found	Remarks
Surface			0	16			
Coal			406	411			
Pitts. Coal			492	500			
Little Dunkard			1018	1043			
1st SALT SAND			1336	1361			
2nd SaLT SAND			1390	1488	Water	1420	
LITTLE LIME			1725	1735			
Pencil Cave			1735	1750			
BIG LIME			1750	1809			
BIG INJUN			1809	1924	(Gas	(1889	
SQUAW			2031	2066	(Gas	(1899	
GANTZ			2343	2388	Gas	2348	
50 Foot			2400	2431			
Total Depth				2464'			

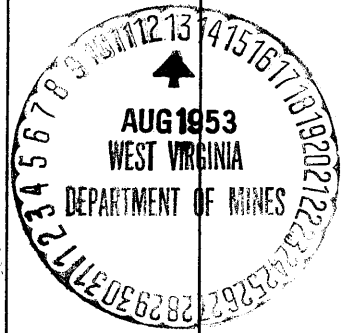

(Over)

MAY 10 1954

Formation	Color	Hard or Soft	Top	Bottom	Oil, Gas or Water	Depth Found	Remarks

Date July 27, _____, 1953

APPROVED Hope Natural Gas Company, Owner

By _____ (Title)

Boily