



Latitude 39° 40'

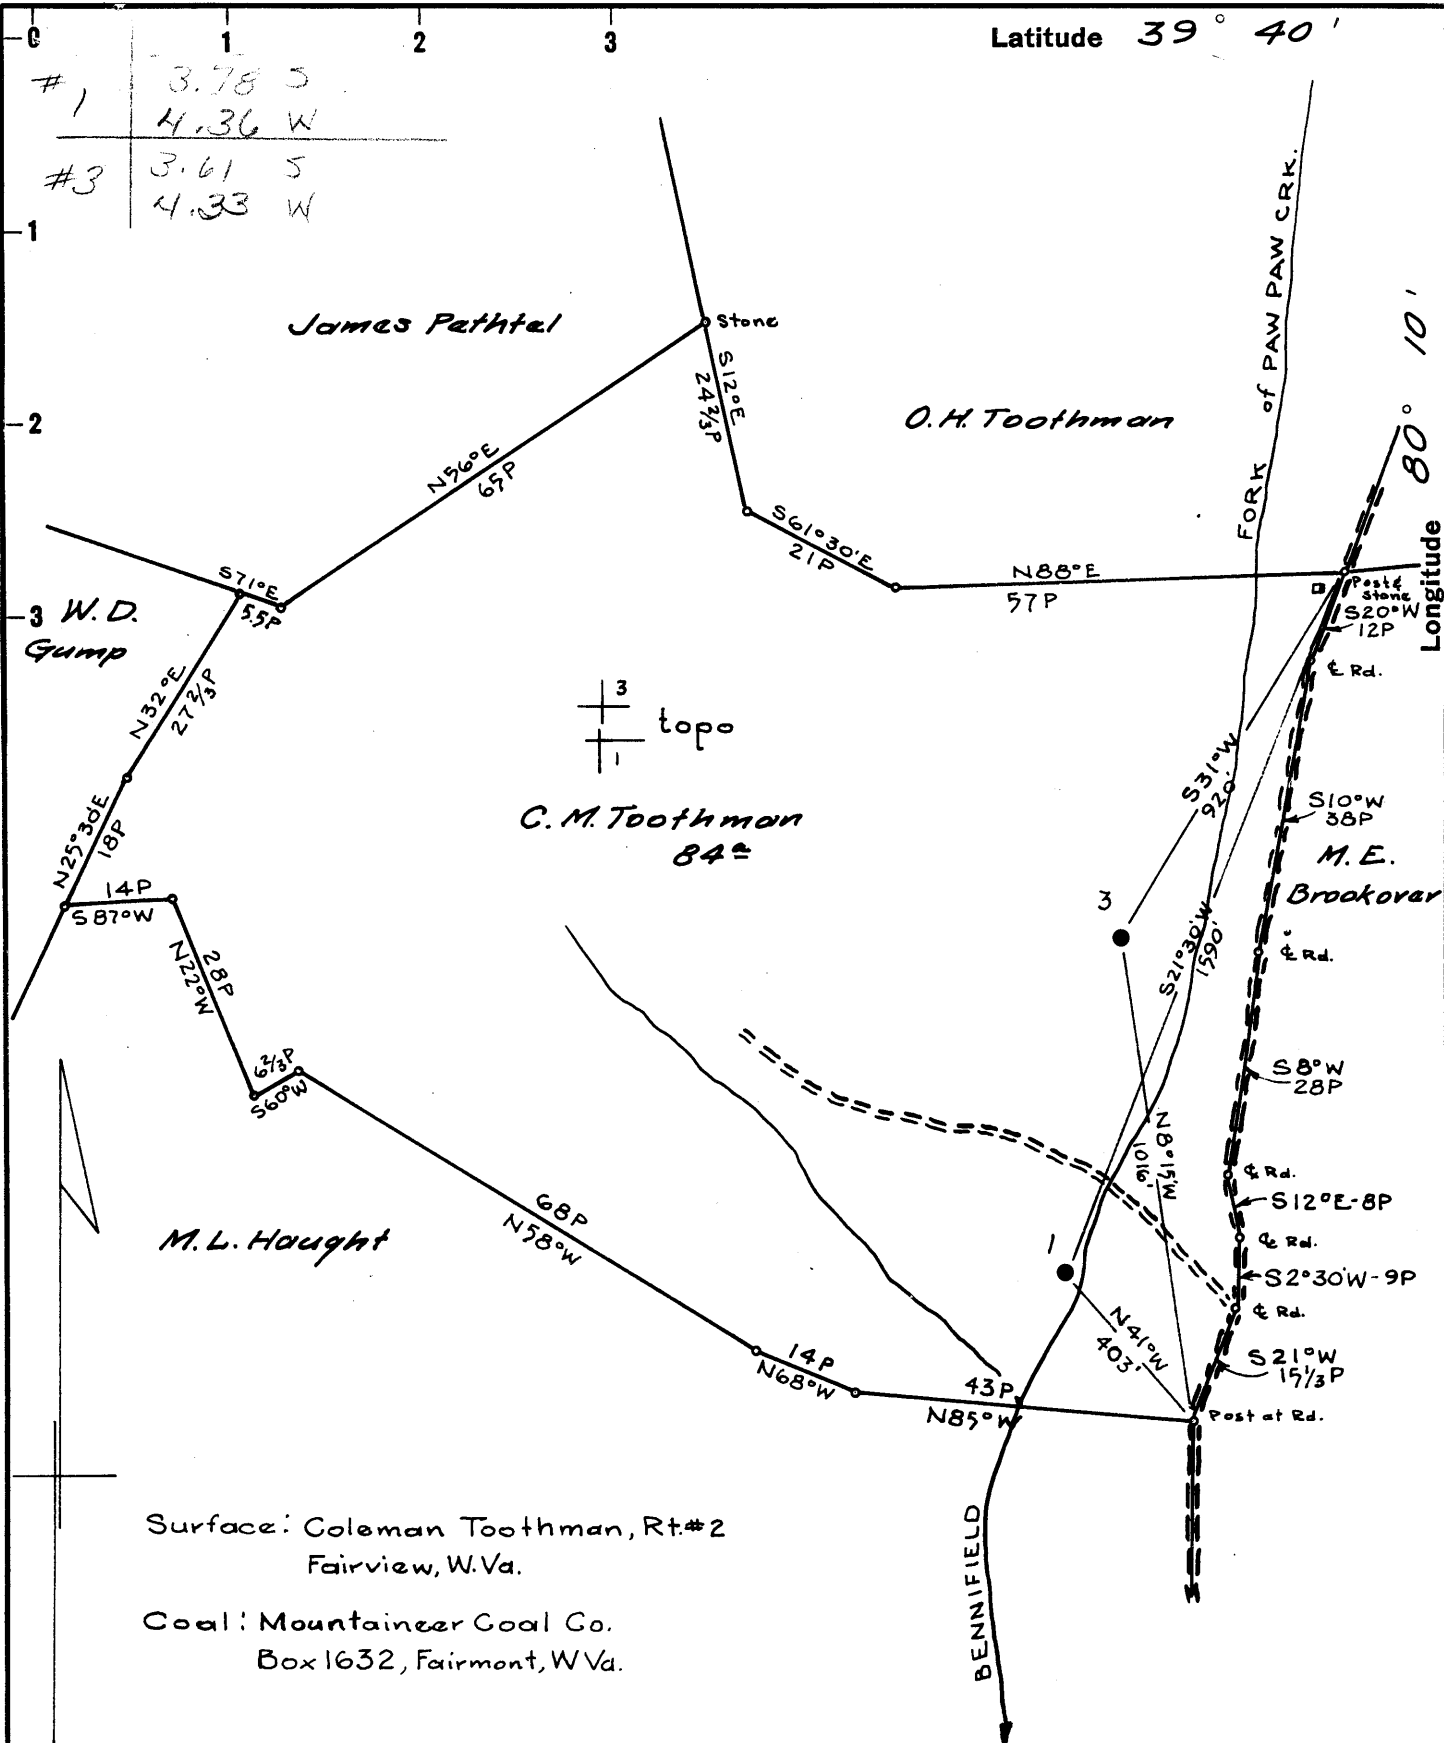

#1	3.78 S
	4.36 W
#3	3.61 S
	4.33 W

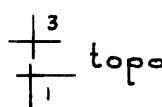

Surface: Coleman Toothman, Rt.#2
Fairview, W.Va.
Coal: Mountaineer Coal Co.
Box 1632, Fairmont, W.Va.

- New Location
- Drill Deeper
- Abandonment

Map N61E N11E21

Company **SOUTH PENN OIL CO.**
 Address **PARKERSBURG, W.Va.**
 Farm **C.M.TOOTHMAN**
 Tract _____ Acres **84[±]** Lease No. **79558**
 Well (Farm) No. **1 & 3** Serial No. _____
 Elevation (Spirit Level) **(1) 1043.41 ch. (3) 1073.54 ch.**
 Quadrangle **BLACKVILLE**
 County **MONONGALIA** District **CLAY**
 Engineer _____
 Engineer's Registration No. **2534**
 File No. **1318** Drawing No. _____
 Date **MAR. 31, 1960** Scale **1"=400'**

STATE OF WEST VIRGINIA
DEPARTMENT OF MINES
OIL AND GAS DIVISION
CHARLESTON

WELL LOCATION MAP
FILE NO. **MON-644-A #1**
MON-645-A #3

+ Denotes location of well on United States Topographic Maps, scale 1 to 62,500, latitude and longitude lines being represented by border lines as shown.

- Denotes one inch spaces on border line of original tracing.

