


Latitude 39° 40'

Longitude 80° 15'

2.075
4.42 W

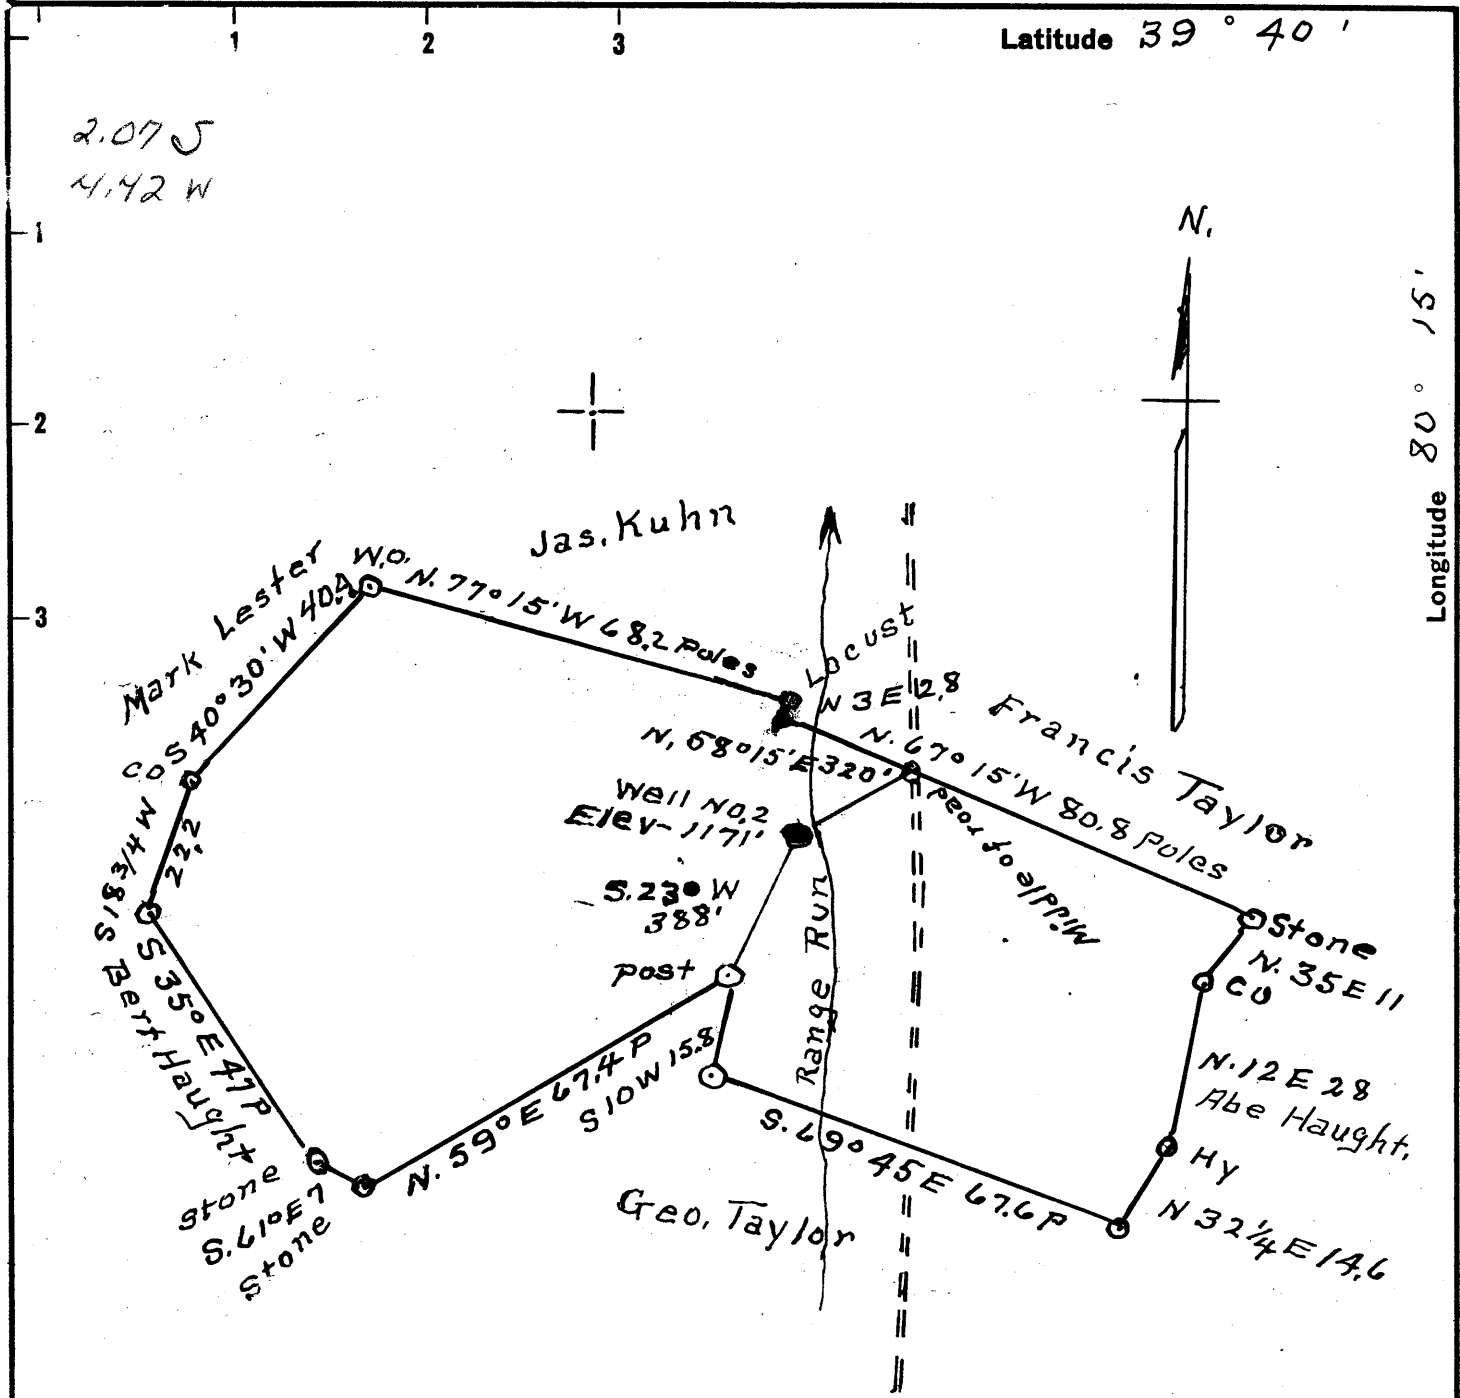

Coal = Little Kanawha Syndicate
 % Bernard G Sampson
 Box. 368 Fairmont W.Va.
 Surface Marshall T. Hartley
 Mannington, W.Va.

New Location
 Drill Deeper
 Abandonment

Company Cecil Chisler & Son
 Address R #2 Fairview, Wva
 Farm Mary Ann Tustin
 Tract 1 Acres 6 1/4 Lease No. 15907
 Well (Farm) No. Two Serial No. _____
 Elevation (Spirit Level) 1171'
 Quadrangle Mannington
 County Monongalia District Battelle
 Engineer A. L. Headley
 Engineer's Registration No. 2021
 File No. _____ Drawing No. _____
 Date Aug. 20, 1962 Scale 1" = 30 Poles.

STATE OF WEST VIRGINIA
 DEPARTMENT OF MINES
 OIL AND GAS DIVISION
 CHARLESTON

WELL LOCATION MAP
 FILE NO. MON-656-A

+ Denotes location of well on United States Topographic Maps, scale 1 to 62,500, latitude and longitude lines being represented by border lines as shown.

= Denotes one inch spaces on border line of original tracing.