


6-2-66

LATITUDE 39 ° 40 ' 1

1,325
1,914

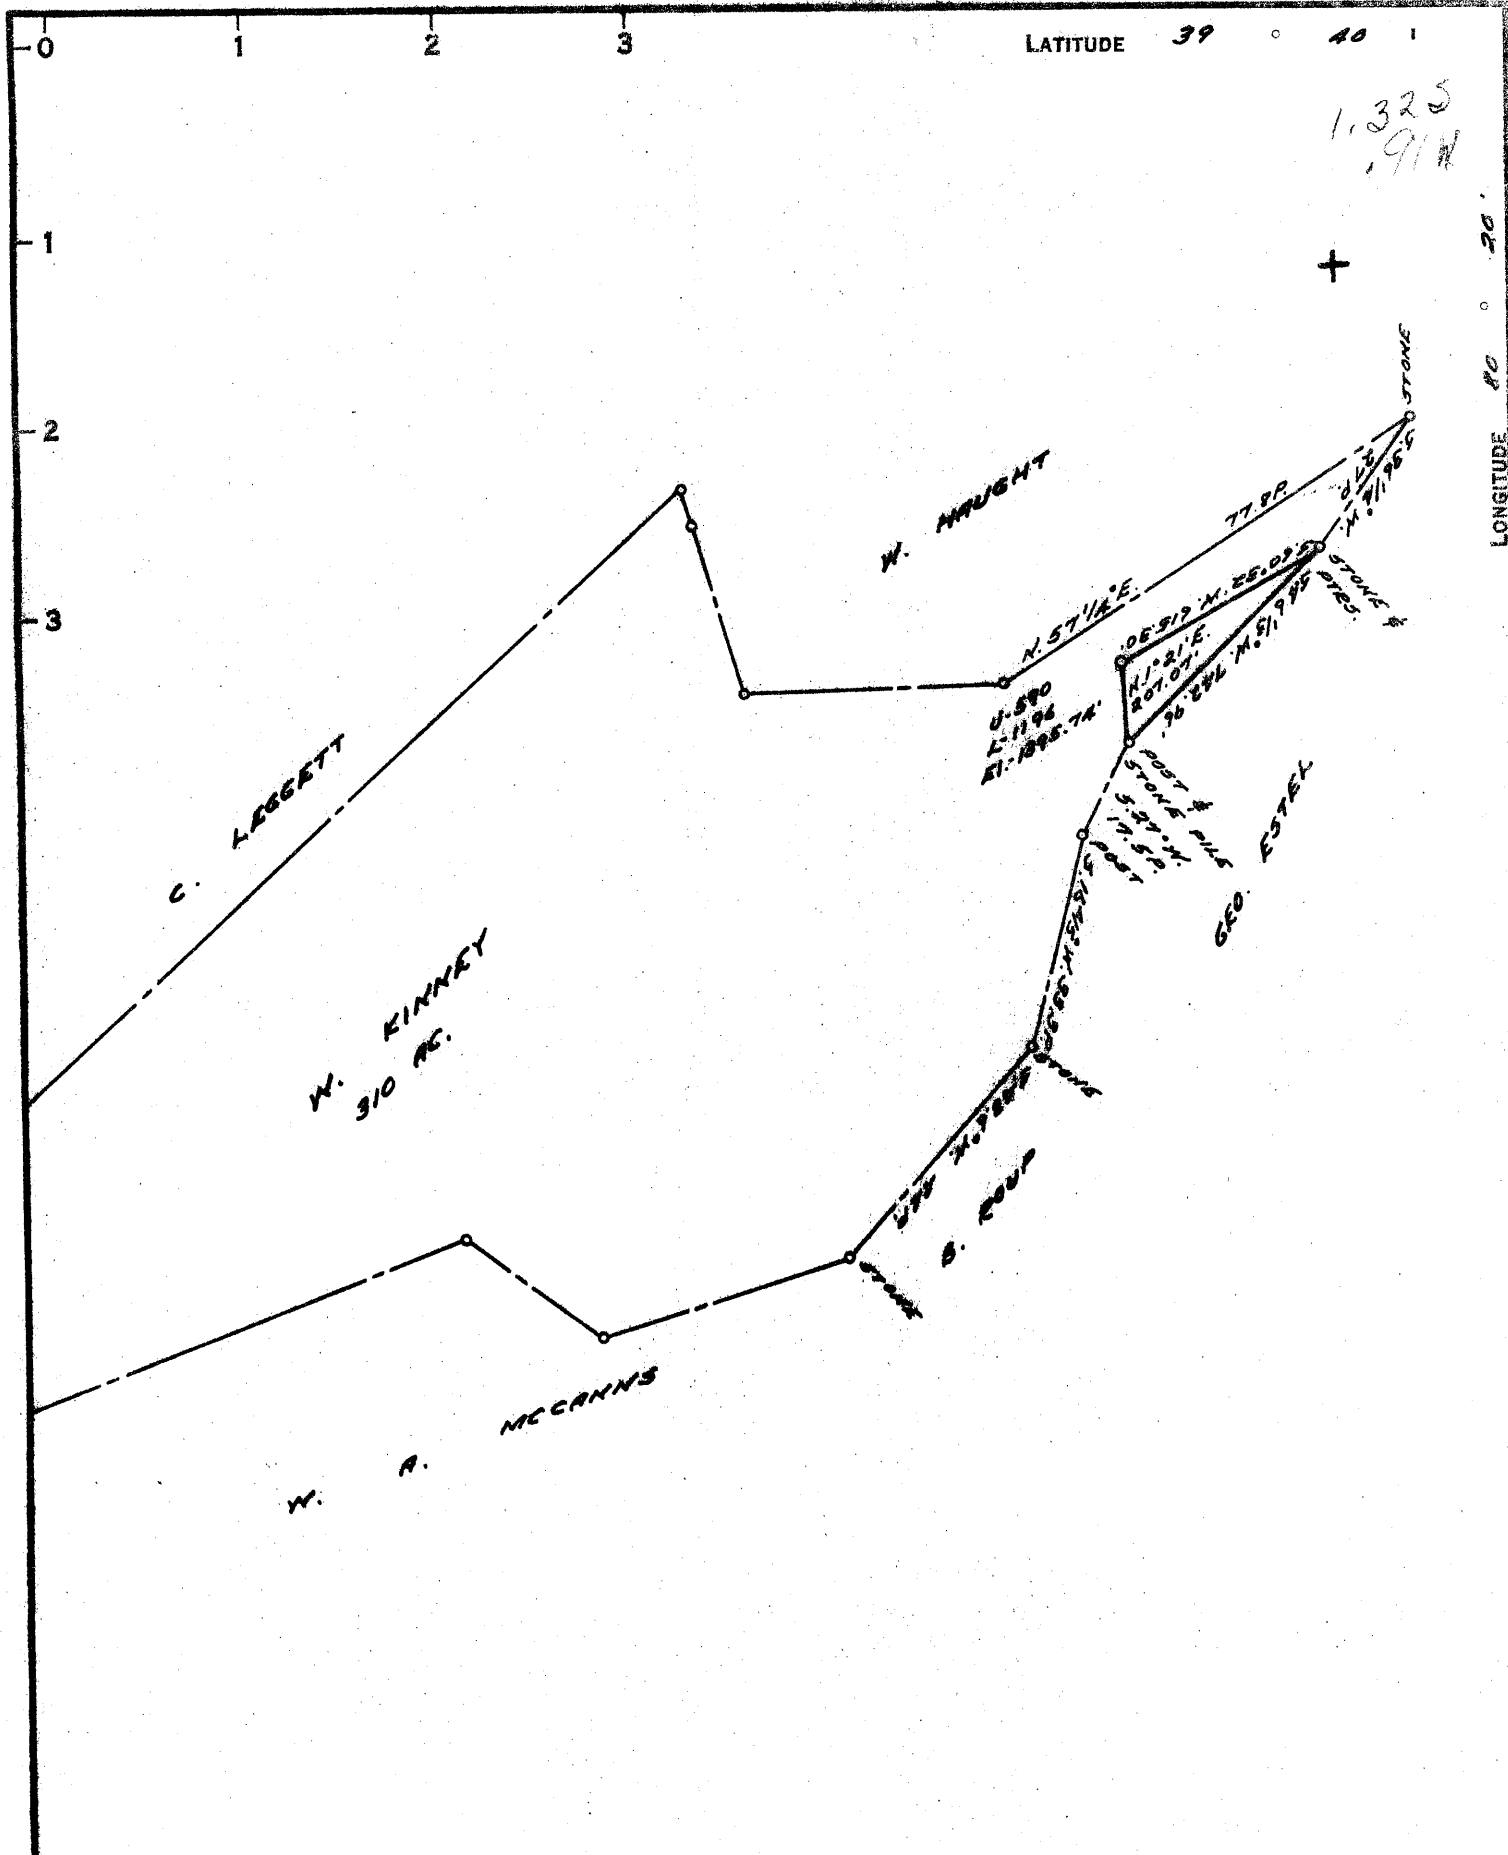

CHARLESTON NATIONAL BANK 1/2 INT.
COAL OWNED BY WHEELING DOLLAR SAVINGS TRUST CO. 1/2 INT

- NEW LOCATION
- RECONDITION
- DRILL DEEPER
- ABANDONMENT

"I, the undersigned, hereby certify that this map is correct to the best of my knowledge and belief and shows all the information required by paragraph 6 of the rules and regulations of the oil and gas section of the mining laws of West Virginia."
Minimum degree of accuracy is one part in 2000

Signed John A. Loudon
12710 R.W.


COMPANY	THE PRESTON OIL COMPANY		
ADDRESS	8 E. LONG ST., COLUMBUS, OHIO		
FARM	W. KINNEY		
MAP	P-26-13	ACRES	310
		LEASE NO.	2908
WELL (FARM) NO.	10	SERIAL NO.	U-590 L-1196
ELEVATION (SPIRIT LEVEL)	1365'		
QUADRANGLE	MANNINGTON - C		
COUNTY	MONONGALIA	DISTRICT	BATTELLE
POINT OF PROVEN ELEVATION	USGS BM 157, 150 BM 148 RND EI. 1096.37'		
FILE NO.		DRAWING NO.	Y-28-47
DATE	16 SEPT. 1965	SCALE	1"=500'

STATE OF WEST VIRGINIA
DEPARTMENT OF MINES
OIL AND GAS DIVISION
CHARLESTON
WELL LOCATION MAP

FILE NO. MDN-666-A

+ DENOTES LOCATION OF WELL ON UNITED STATES TOPOGRAPHIC MAPS, SCALE 1 TO 62,500, LATITUDE AND LONGITUDE LINES BEING REPRESENTED BY BORDER LINES AS SHOWN.
- DENOTES ONE INCH SPACES ON BORDER LINE OF ORIGINAL TRACING.

Latitude

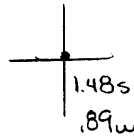

Longitude

Topo Location

7.5' Loc. _____ 15' Loc. _____
 _____ (calc.) _____

Company Preston Oil Co

Farm W Kimney #10

15' Quad _____
(sec.)

7.5' Quad Wadestown

District Battelle

WELL LOCATION PLAT

County 061 Permit 666A