


LATITUDE 39° 40'

B.16 S
2.56 W

LONGITUDE 80° 15'

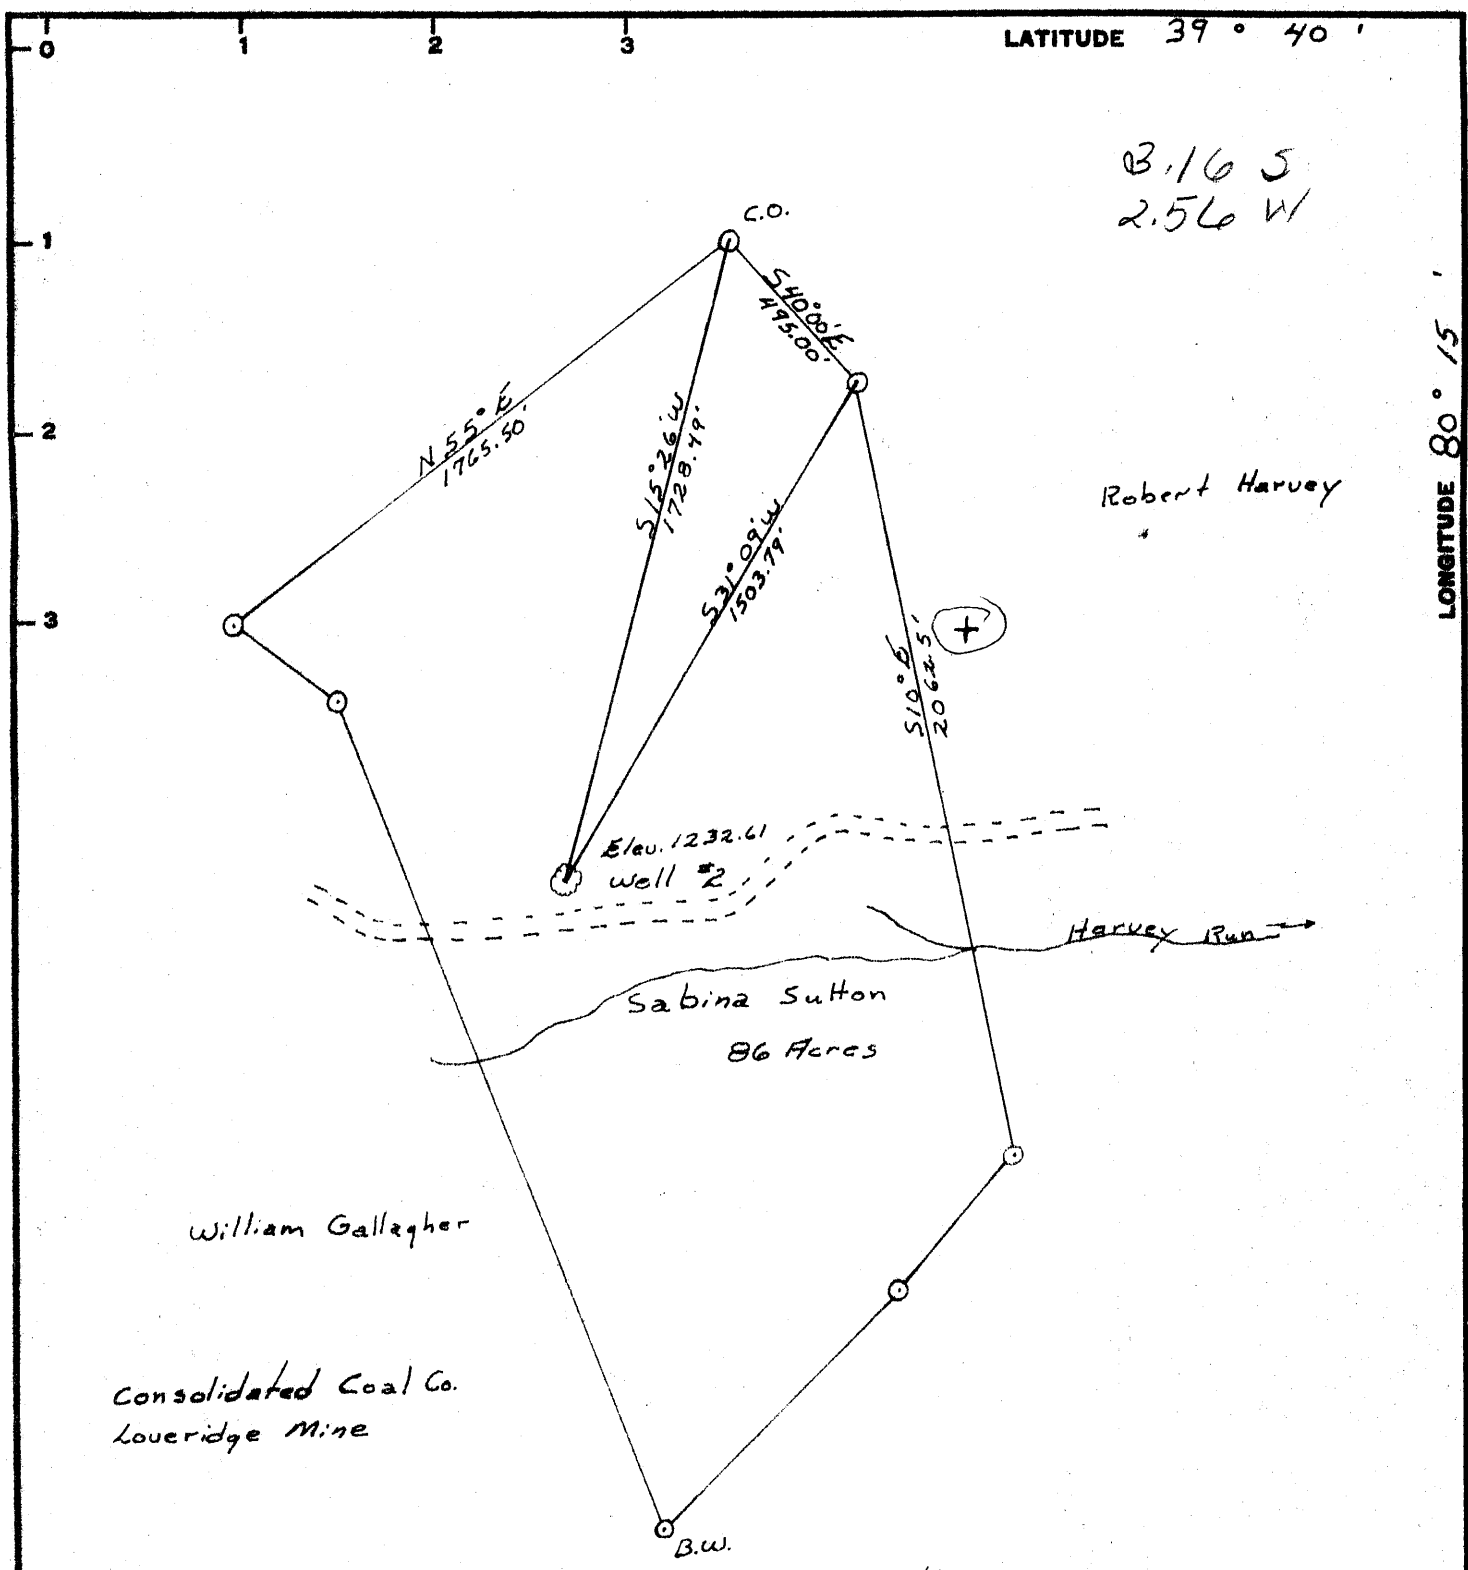

Minimum Error of Closure Less than 1 in 2000

Source of Elevation B.M. established by Mine 1145.67

- Fracture.....
- New Location.....
- Drill Deeper.....
- Abandonment.....

I, the undersigned, hereby certify that this map is correct to the best of my knowledge and belief and shows all the information required by paragraph 6 of the rules and regulations of the oil and gas section of the mining laws of West Virginia.

Signed: William P Foley R.P.E
 Squares: N S E W

Map No.

Company William Cassidy
 Address 4303 Whitford Drive, Vienna, W.Va.
 Farm Sabina Sutton
 Tract _____ Acres 86 Lease No. _____
 Well (Farm) No. 2 Serial No. _____
 Elevation (Spirit Level) 1232.61
 Quadrangle Mannington EC
 County Monongalia District Battelle
 Engineer William P Foley
 Engineer's Registration No. 4449
 File No. _____ Drawing No. _____
 Date 11-28-67 Scale 1" = 500'

STATE OF WEST VIRGINIA
 DEPARTMENT OF MINES
 OIL AND GAS DIVISION
 CHARLESTON

WELL LOCATION MAP
 FILE NO. MON-679-A

+ Denotes location of well on United States Topographic Maps, scale 1 to 62,500, latitude and longitude lines being represented by border lines as shown.
 - Denotes one inch spaces on border line of original tracing.