


LATITUDE

30° 40'
39°

2.265
1.73W

Note: This well location plat made from South Penn 1" = 800' scale well map.

LONGITUDE 80° 15'

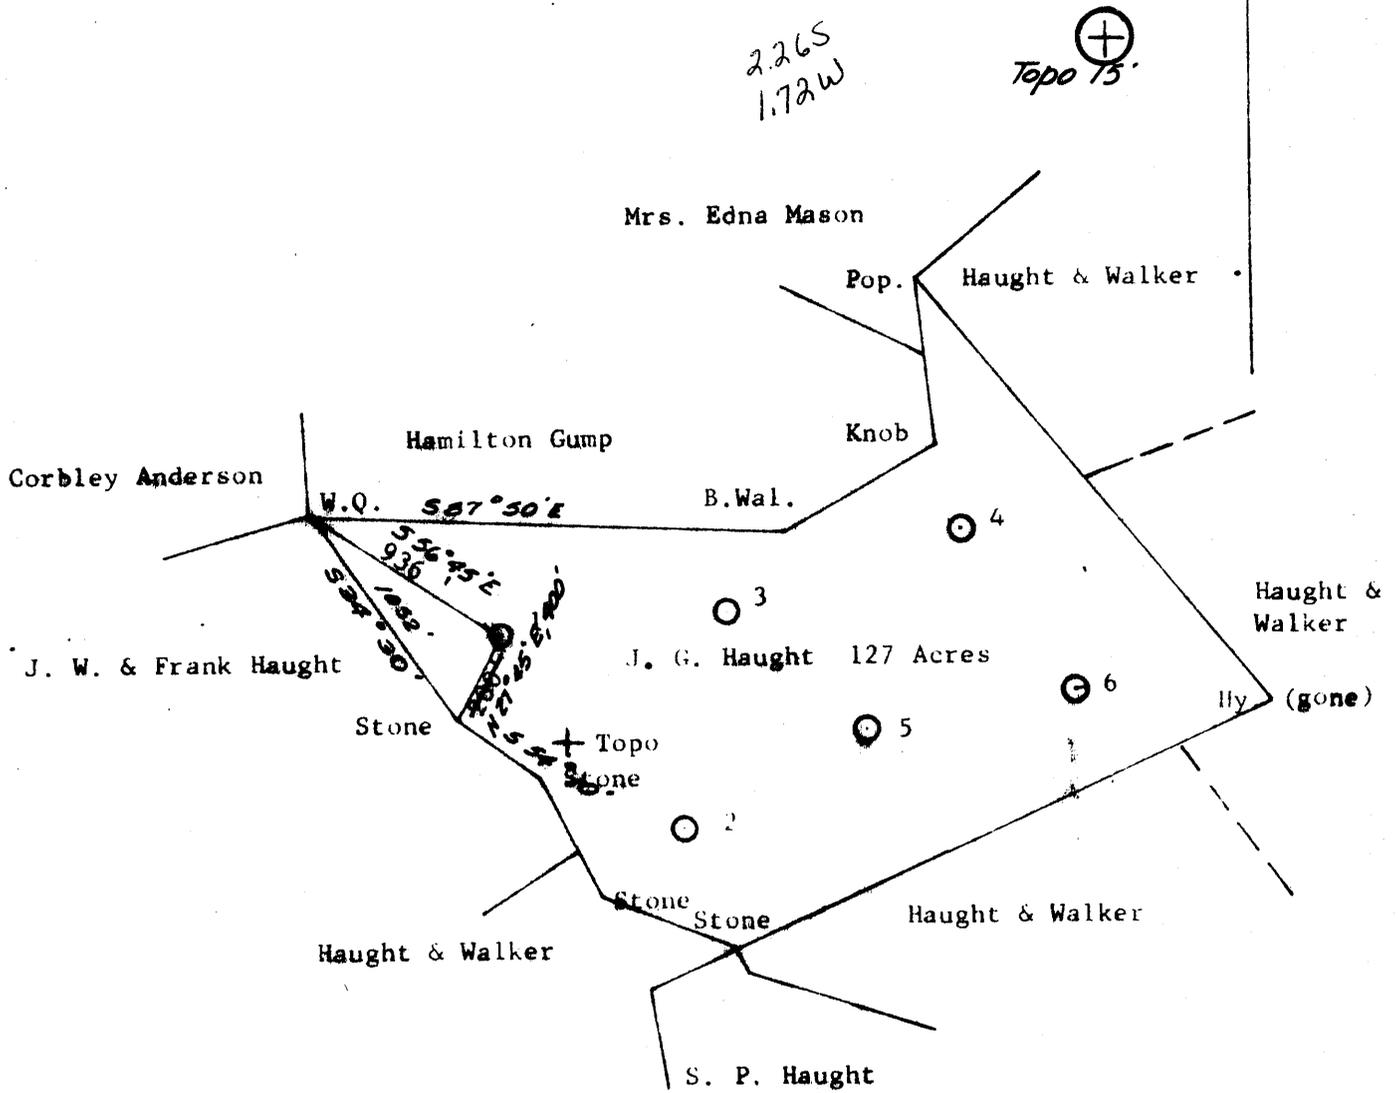

Minimum Error of Closure _____

Source of Elevation U.S.G.S. Monument

I, the undersigned, hereby certify that this map is correct to the best of my knowledge and belief and shows all the information required by paragraph 6 of the rules and regulations of the oil and gas section of the mining laws of West Virginia.

B. J. McCormley

Abandonment 7/31/75

Company	Mountaineer Coal Company for A. E. & M. W. Bissett
Address	P.O. Box 1632 Fairmont, W. Va. 26554
Farm	J. G. Haught 127 Acres
Tract	_____ Acres _____ Lease No. _____
Well (Farm) No.	Maught #1 Serial No. _____
Elevation (Spirit Level)	1356.38 EC
Quadrangle	Wadestown 7.5', <u>Mannington 15'</u>
County	Monongalia District Battelle
Engineer	B. J. McCormley
Registration No.	2067
File No.	_____ Drawing No. _____
Date	7/21/75 Scale 1" = 800'

STATE OF WEST VIRGINIA
Department of Mines
OIL AND GAS DIVISION
CHARLESTON

FILE NO. Mon-706-A

† Denotes location of well on United States Topographic Map, scale 1 to 24000, Latitude and Longitude lines being represented by border lines as shown.

47-061 AUG 5 1975