

New location
 Drill Deeper
 Abandonment
 12/13/71

Minimum Error of Closure 1 in 2500
 Source of Elevation ~~BBG~~ B.M. Elev 1567' at KESLERS CROSSLANES
 "I, the undersigned, hereby certify that this map is correct to the best of my knowledge and belief and shows all the information required by paragraph 6 of the rules and regulations of the oil and gas section of the mining laws of West Virginia


Company ~~BOURNES & JONES~~
 Address P.O. Box 372 - RIPLEY, W.Va.
 Farm R.A. SUMMERS
 Tract _____ Acres 124 Lease No. _____
 Well (Farm) No. 1 Serial No. _____
 Elevation (Spirit Level) 1584.0
 Quadrangle WINOHA NW
 County NICHOLAS District GRANT
 Engineer N.Y. Sefton
 Engineer's Registration No. 1832
 File No. _____ Drawing No. _____
 Date 8-21-71 Scale 1" = 500'

STATE OF WEST VIRGINIA
 DEPARTMENT OF MINES
 OIL AND GAS DIVISION
 CHARLESTON

WELL LOCATION MAP
 FILE NO. NIC-293-P

+ Denotes location of well on United States Topographic Maps, scale 1 to 62,500 latitude and longitude lines being represented by border lines as shown.

- Denotes one inch spaces on border line of original tracing.

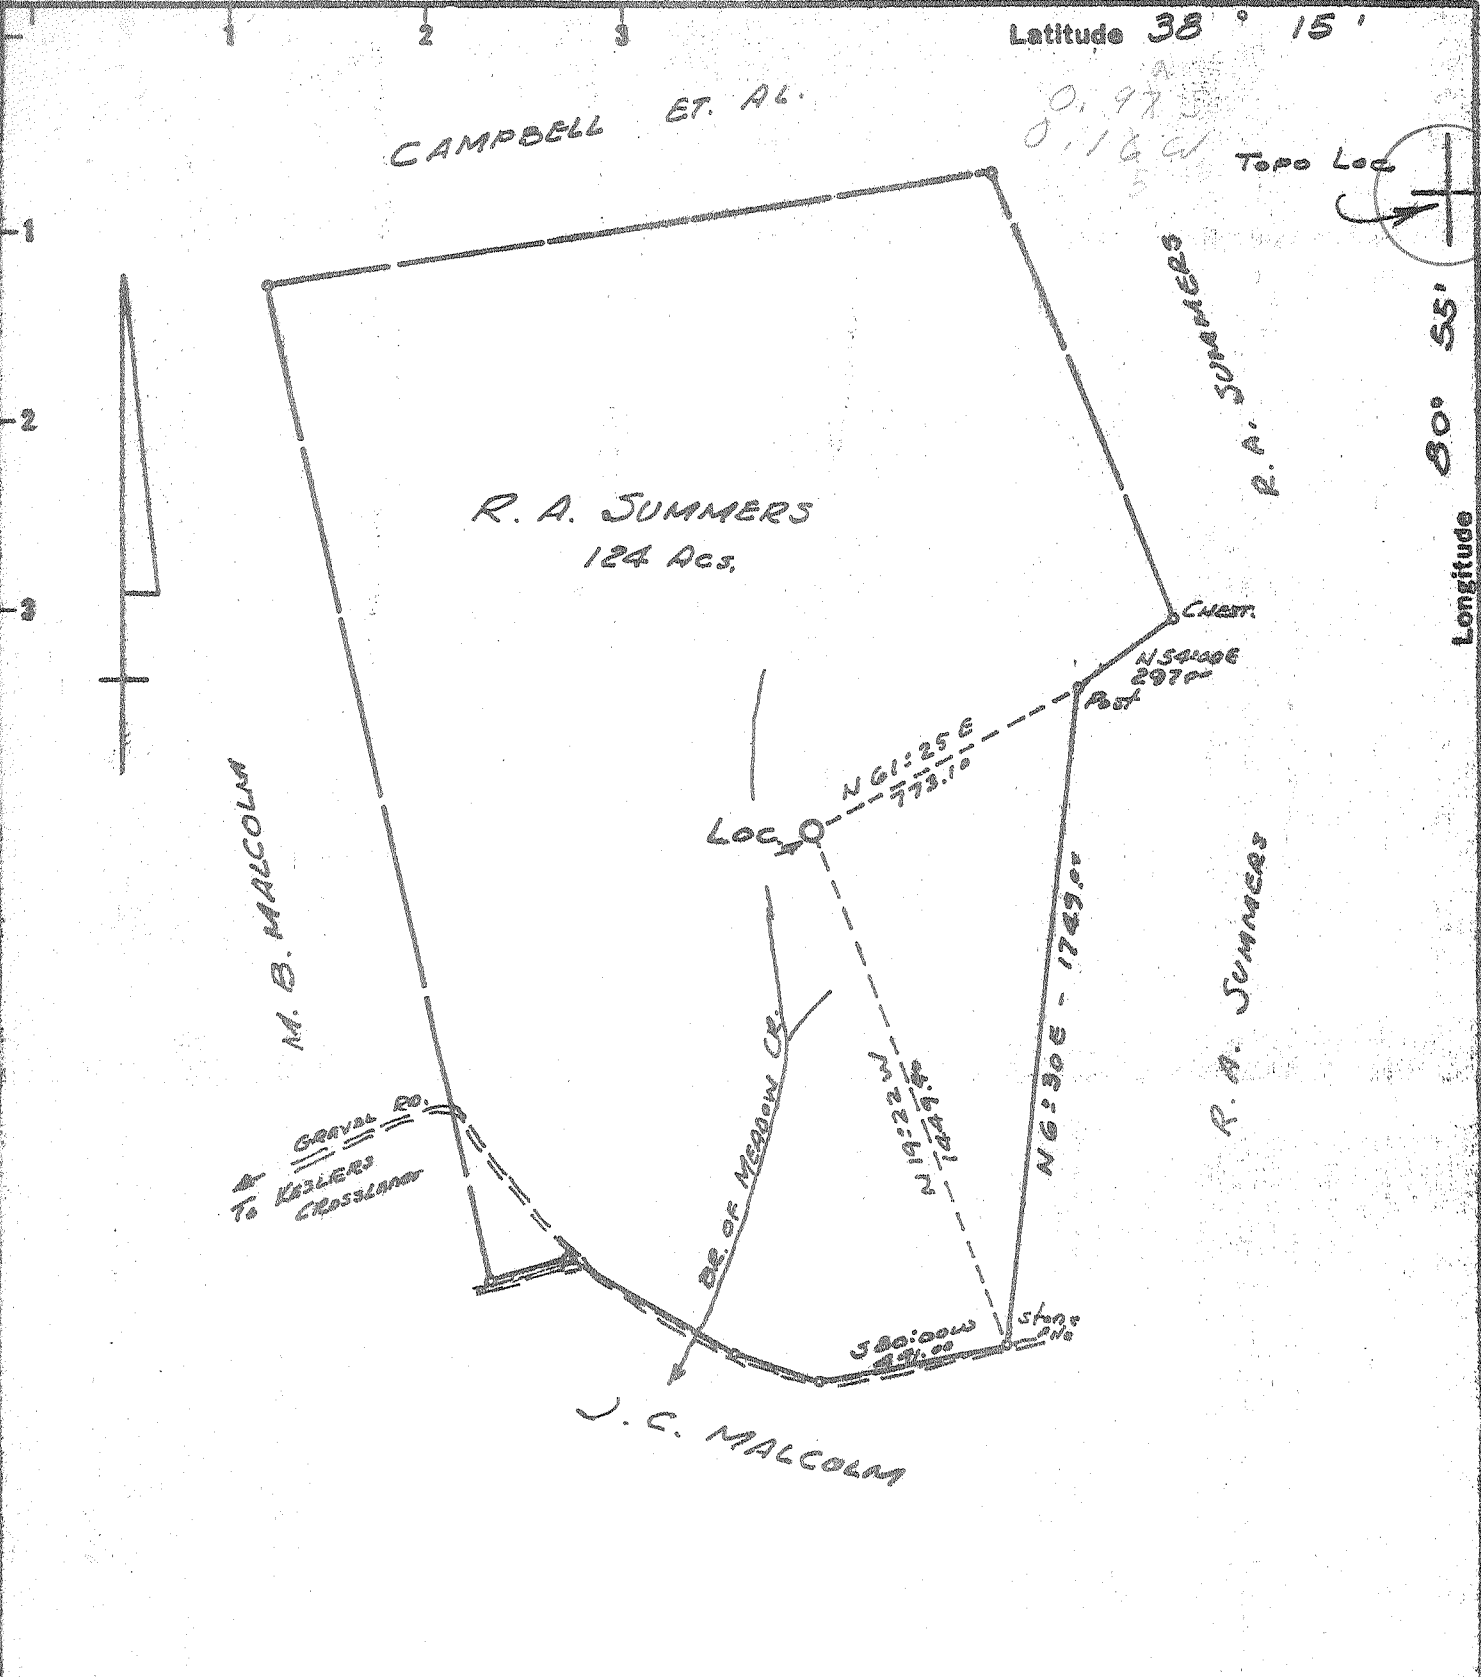

New Location

Drill Deeper

Abandonment

Minimum Error of Closure 1 in 2500

Source of Elevation B.M. Elev 1567' of KESLERS CROSSROADS

"I, the undersigned, hereby certify that this map is correct to the best of my knowledge and belief and shows all the information required by paragraph 6 of the rules and regulations of the oil and gas section of the mining laws of West Virginia."

Company BURNS & JONES

Address P.O. Box 372 - RIPLEY, W.Va.

Farm R.A. SUMMERS

Tract _____ Acres 124 Lease No. _____

Well (Farm) No. 1 Serial No. _____

Elevation (Spirit Level) 1584.0

Quadrangle WINOHA NW

County NICHOLAS District GRANT

Engineer N.Y. Sefton

Engineer's Registration No. 1832

File No. _____ Drawing No. _____

Date 8-21-71 Scale 1" = 500'

STATE OF WEST VIRGINIA
DEPARTMENT OF MINES
OIL AND GAS DIVISION
CHARLESTON

WELL LOCATION MAP
FILE NO. NIC-293

+ Denotes location of well on United States Topographic Maps, scale 1 to 62,500 latitude and longitude lines being represented by border lines as shown.

- Denotes one inch spaces on border line of original tracing.



RECEIVED

DEC 13 1971

STATE OF WEST VIRGINIA OIL & GAS DIVISION DEPT. OF MINES OIL AND GAS WELLS DIVISION

- Rotary [x]
Spudger []
Cable Tools []
Storage []

WELL RECORD 6

Oil or Gas Well Dry (KIND)

Quadrangle W. Va.

Permit No. Nic - 293

Company: B. Jones & Jones
Address: P.O. Box 372, Ripley, W. Va.
Farm: E. A. Summers, Acres: 124
Location: Meadow Creek, 1584 GL, Elev. 1592 KB
District: Grant, County: Nicholas
Drilling commenced: 10-6-71
Drilling completed: 12-7-71
Date Shot: From To
Open Flow: 10ths Water in, 10ths Merc. in
Volume: Cu. Ft.
Rock Pressure: lbs., hrs.
Oil: bbls., 1st 24 hrs.
WELL ACIDIZED (DETAILS): No
WELL FRACTURED (DETAILS): No
RESULT AFTER TREATMENT (Initial open Flow or bbls.):
ROCK PRESSURE AFTER TREATMENT: HOURS
Fresh Water: Feet, Salt Water: Feet
Producing Sand: Depth

Table with 4 columns: Casing and Tubing, Used in Drilling, Left in Well, Packers. Rows include sizes like 16 18', 13, 10, 8 1/4 9 5/8", 6 5/8 7", 5 3/16, 4 1/2, 3, 2 and packer details.

Attach copy of cementing record.
CASING CEMENTED: See reverse side, SIZE, No. Ft., Date
Amount of cement used (bags):
Name of Service Co.:
COAL WAS ENCOUNTERED AT: FEET, INCHES, FEET, INCHES, FEET, INCHES

Table with 8 columns: Formation, Color, Hard or Soft, Top, Bottom, Oil, Gas or Water, Depth, Remarks. Lists geological layers from Soil to Slate with depths and water encounters.

(over)

Formation	Color	Hard or Soft	Top	Bottom	Oil, Gas or Water	Depth Found	Remarks
Shale Brown			1129	1310			
Sand			1310	1360			
Shale			1360	1600			
Lime			1600	1685			
Shale			1685	1720			
Big Lime			1720	1995			
Shun			1995	2010	Damp		
Shale			2010	2252			
Shale Brown			2252	2275			
Shale			2275	3255			
Shale			3255	3270	Water, hole full		
Shale			3270	6516			
Coniferous			6516	6664			
Criskany (estimated)			6664	6700	Damp		
Lime			6700	7195			
Polomite & Anhydrite			7195	7578			
Newburg			7578	7602	Damp		
Polomite & Shale			7602				
TOTAL DEPTH				7642			
13 3/8"	225'	130 sks.	10-13-71	Contractor	G. D. Jones		
9 5/8"	1805'	46 sks.	10-19-71	Contractor	G. D. Jones		
7"	4100'	56 sks.	11-9-71	Contractor	G. D. Jones		
		Method of Drilling					
		Foam	0 - 1805				
		Air	1805 - 3270				
		Fluid	3270 - 4100				
		Air	4100 - 7642				

Date....., 19.....

APPROVED....., Owner

By..... (Title)